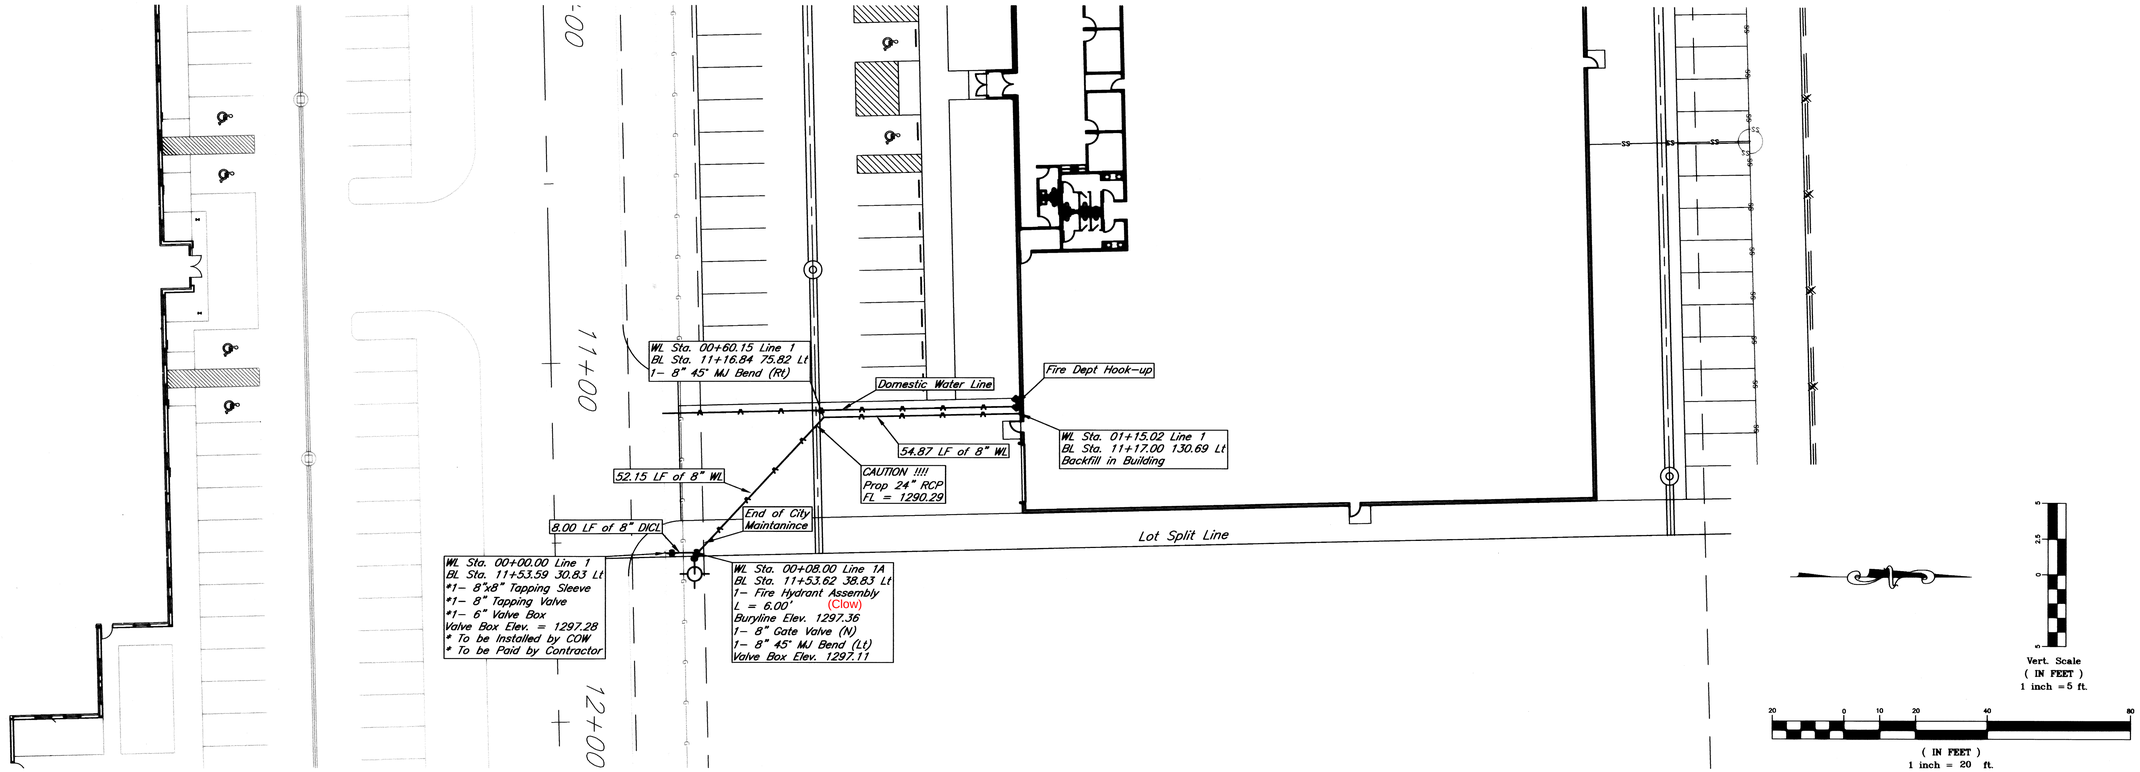

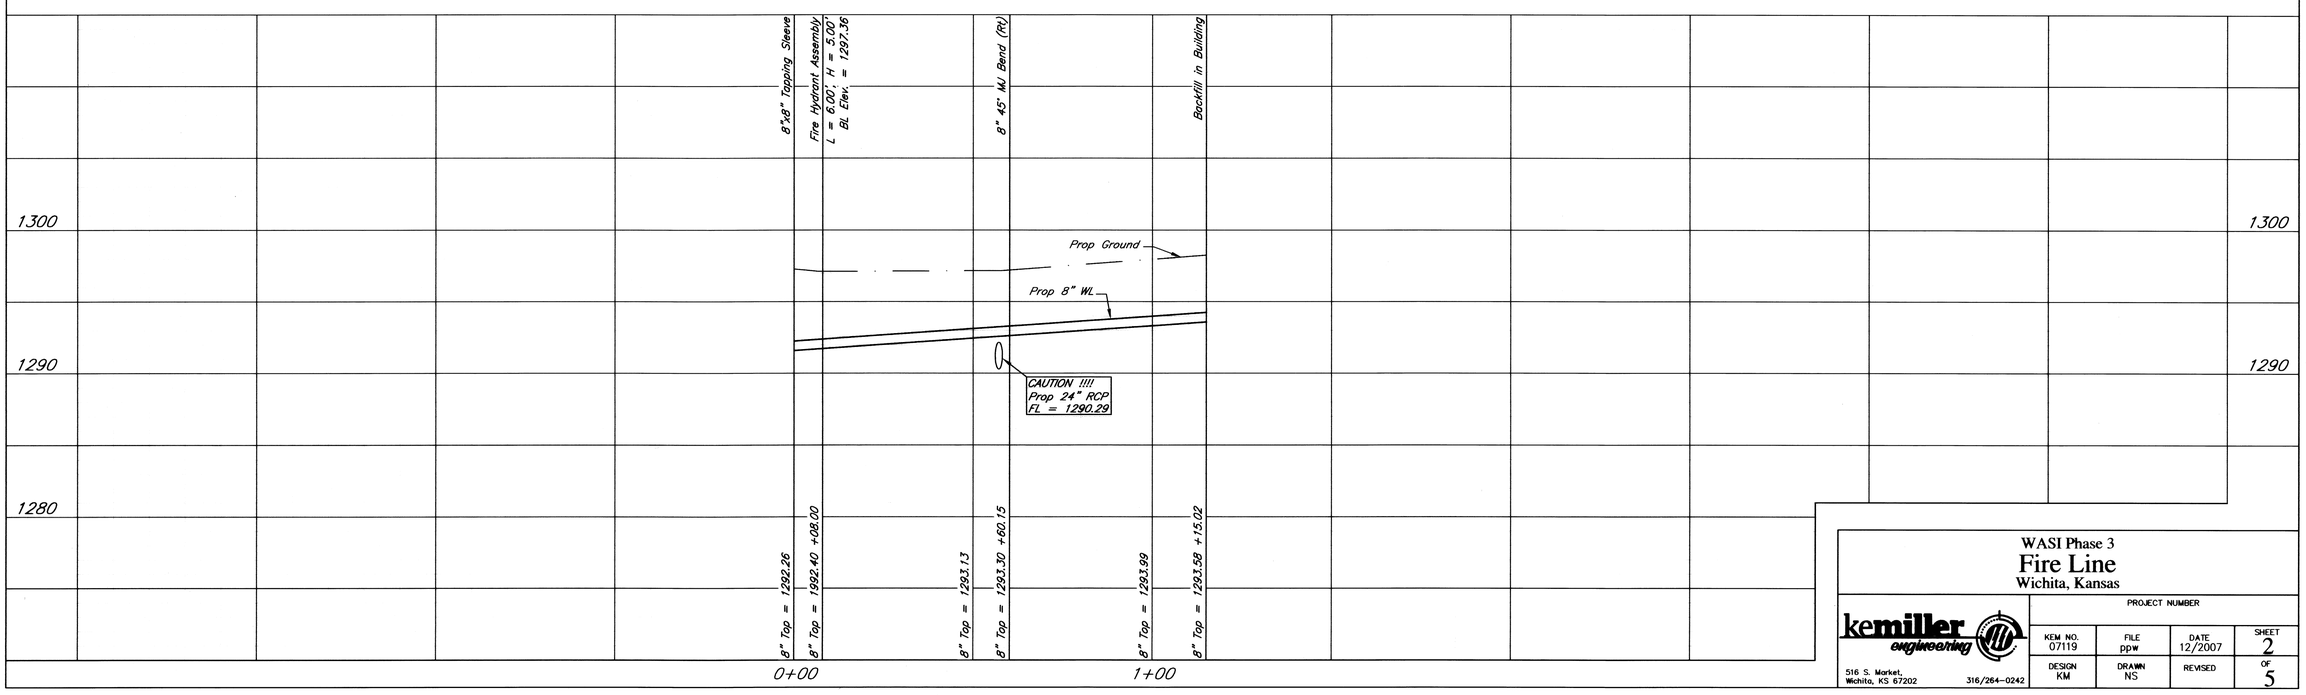

WASI Phase 3

Fire Line

Wichita, Kansas

kemiller engineering

516 S. Market,
Wichita, KS 67202 316/264-0242

PROJECT NUMBER			
KEM NO. 07119	FILE ppw	DATE 12/2007	SHEET 2
DESIGN KM	DRAWN NS	REVISED	OF 5