
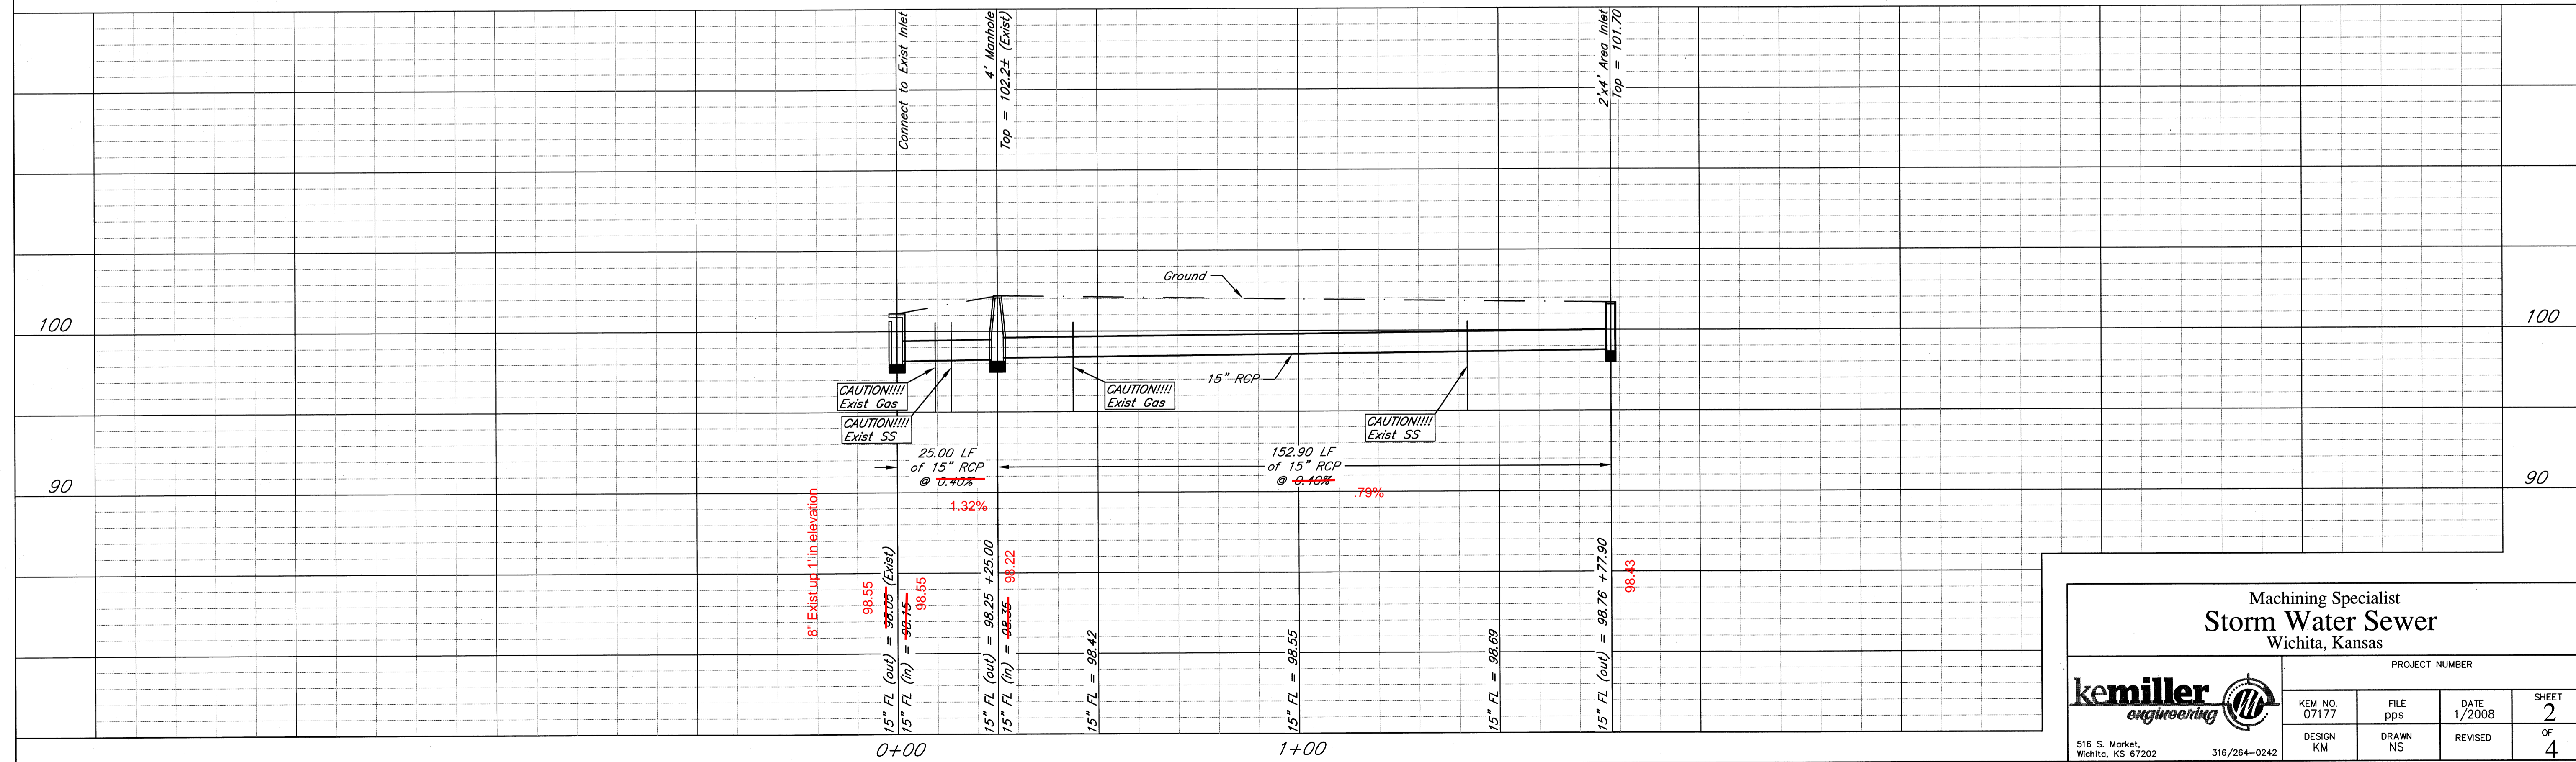


**NOTES:**  
Field check and verify depth and sizes of existing gas and sanitary sewer lines.

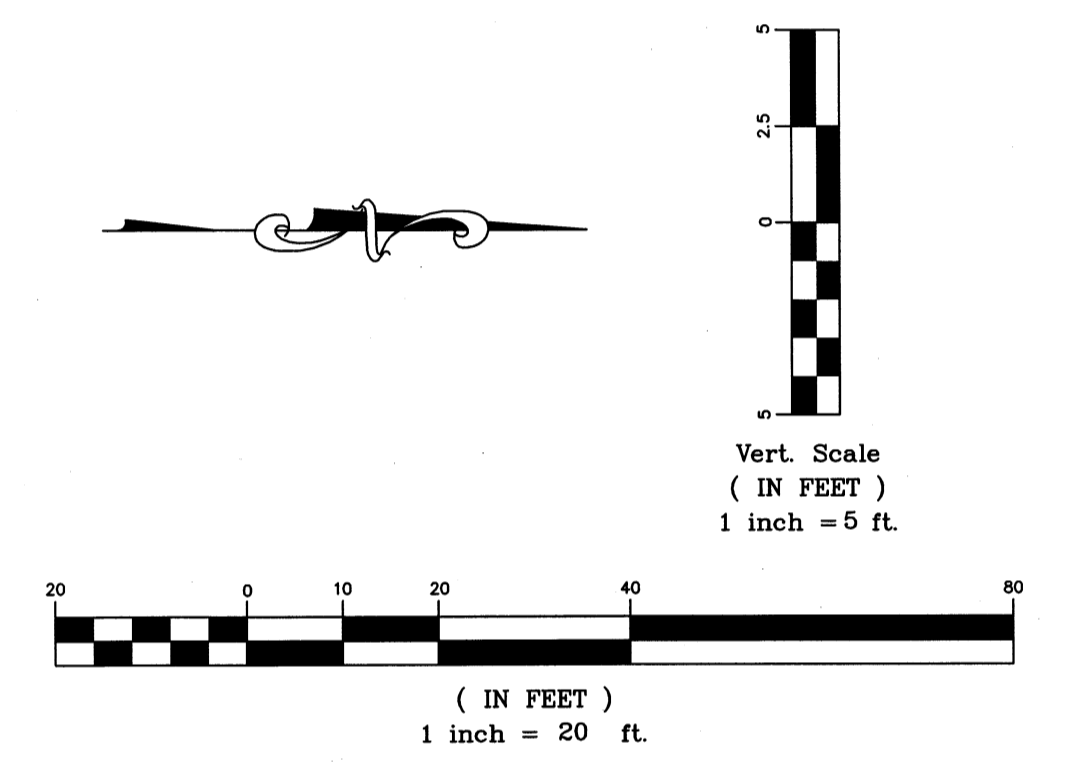

Machining Specialist  
**Storm Water Sewer**  
Wichita, Kansas

PROJECT NUMBER			
<b>kemiller</b> <small>engineering</small>	KEM NO. 07177	FILE pps	DATE 1/2008
DESIGN KM	DRAWN NS	REVISED	SHEET 2 OF 4
<small>516 S. Market, Wichita, KS 67202</small>		<small>316/264-0242</small>	