

PLAN SCALE 1"=40'
PROFILE SCALE 1"=40' HOR. 1"=4' VERTICAL


AS BUILT PLANS

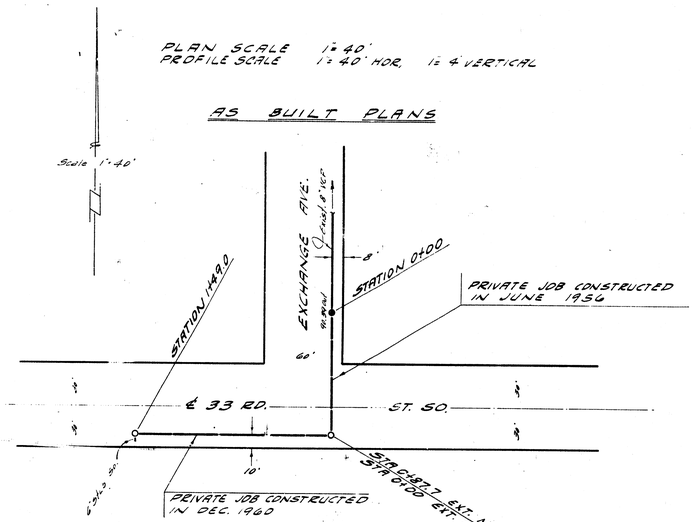

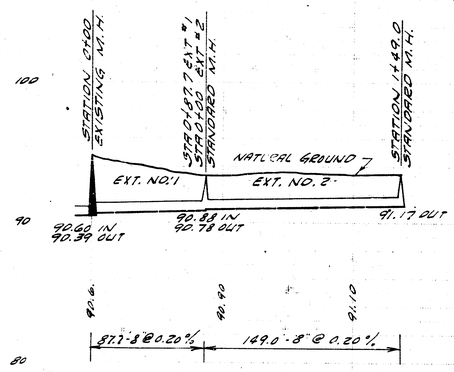


AS BUILT PLANS

EXT. OF LAT. 6 SAN. SEWER 23
CITY OF WICHITA, KANSAS
B.E. SMITH CITY ENGINEER
PRIVATE JOB. DEC. 1960

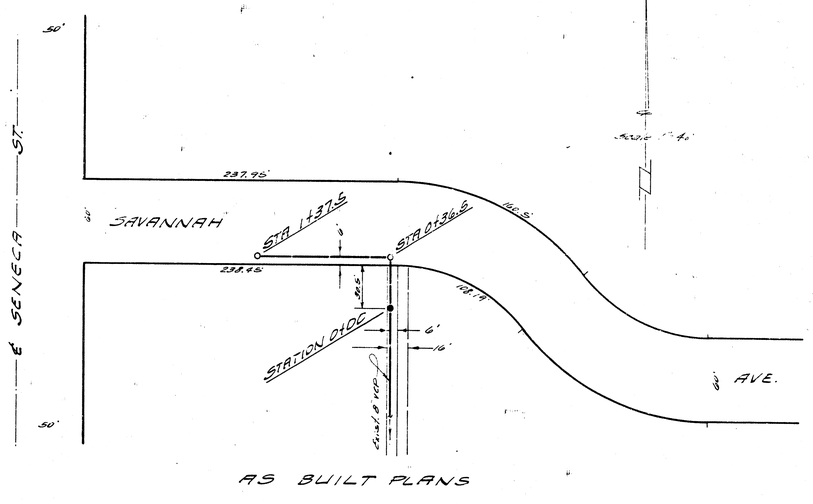

AS BUILT PLANS

PLAN SCALE 1"=40'
PROFILE SCALE 1"=40' HOR. 1"=4' VERTICAL

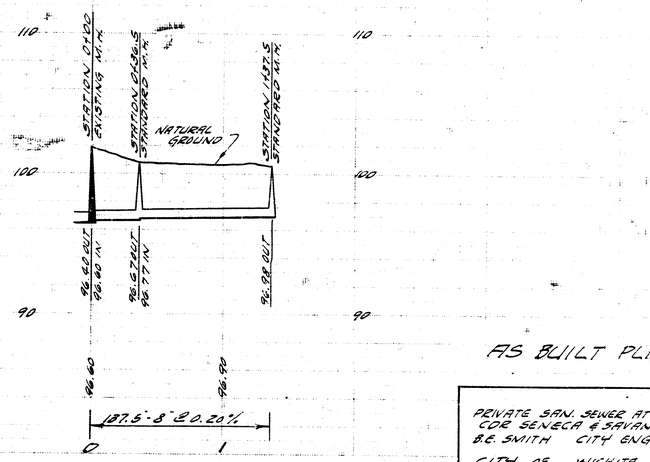

AS BUILT PLANS

PRIVATE SAN. SEWER AT SE COR SENECA & SAVANNAH
B.E. SMITH CITY ENGINEER
CITY OF WICHITA, KANSAS
PRIVATE JOB. DEC. 1960

8 8 5 (3)