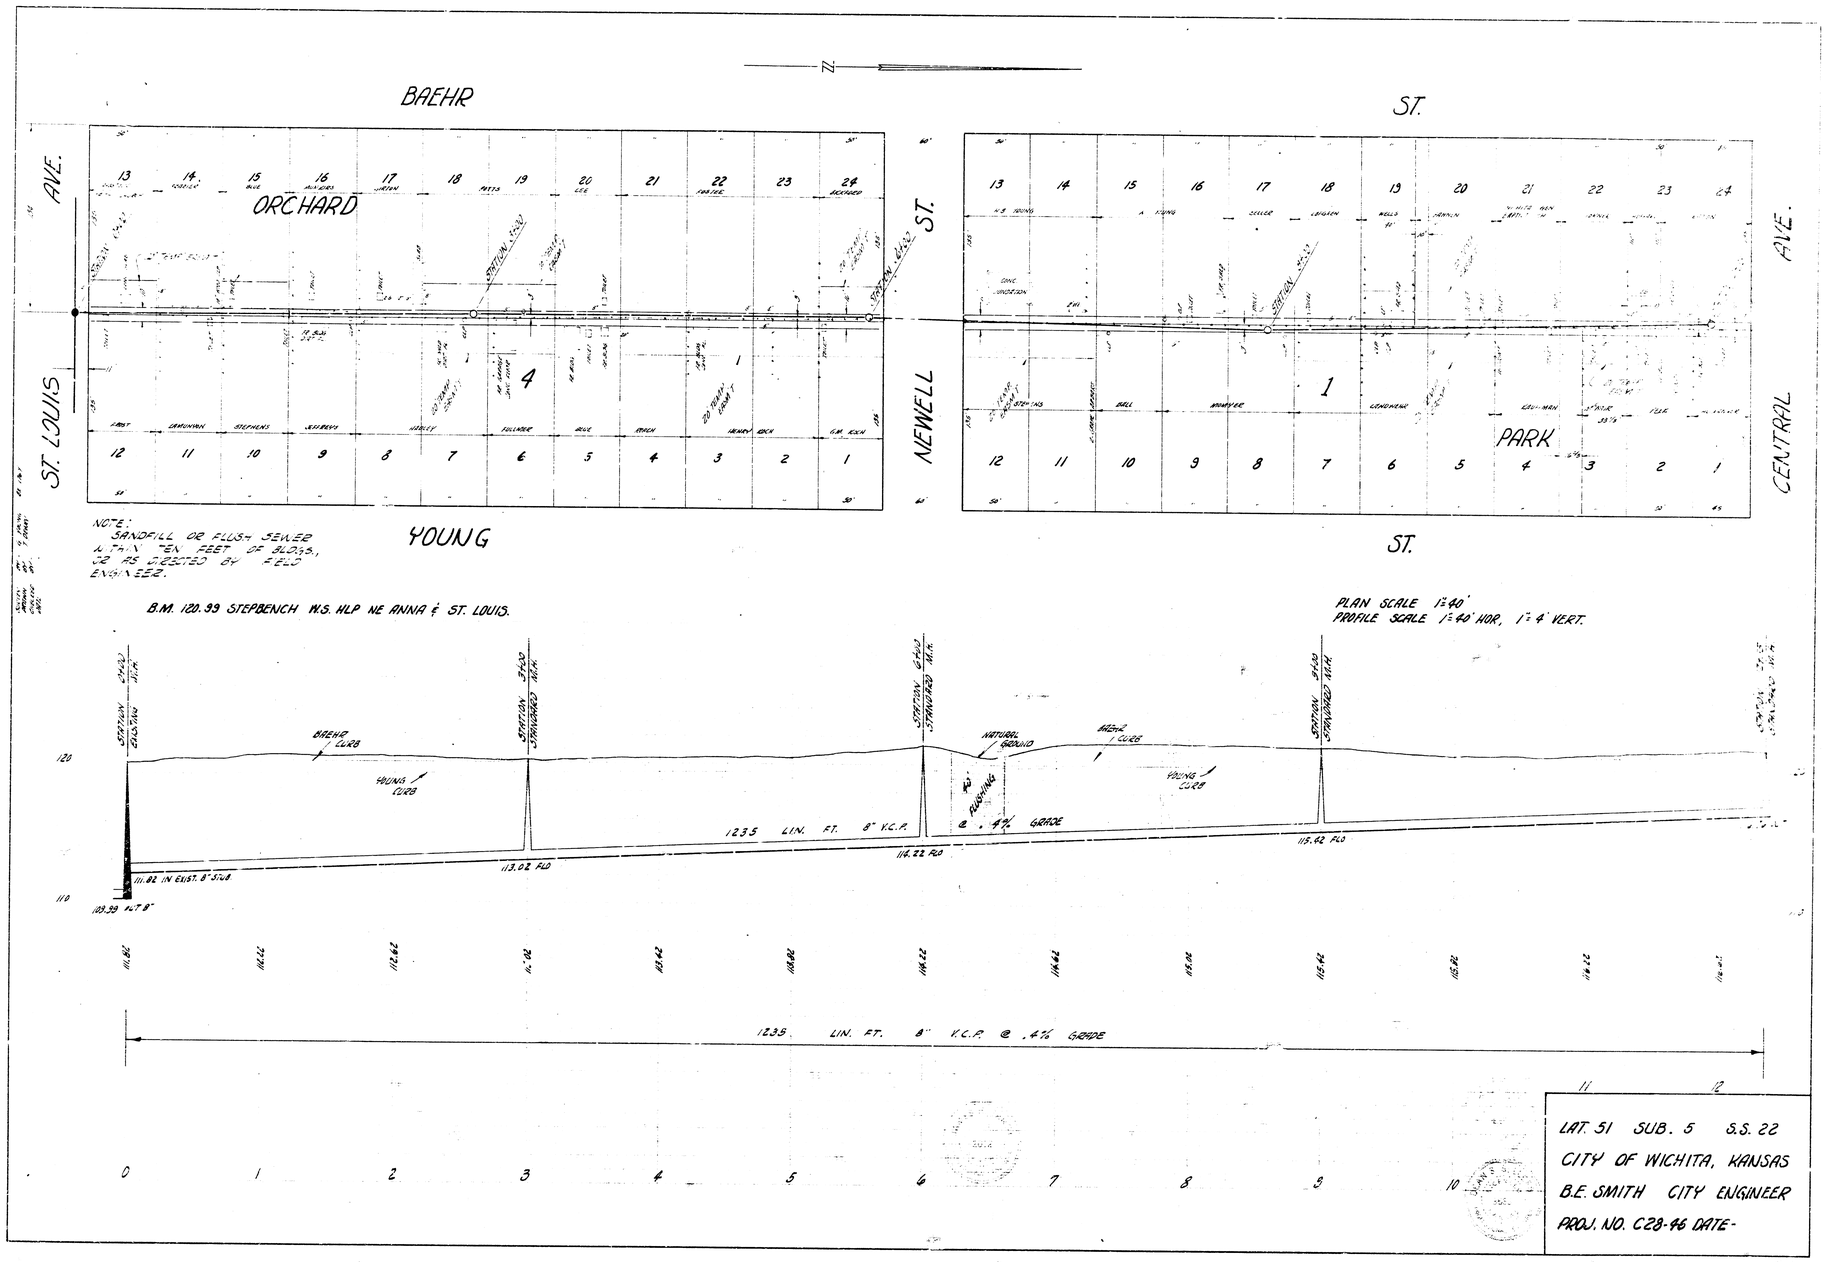

LAT. 51 SUB. 5 S.S. 22
CITY OF WICHITA, KANSAS
B.E. SMITH CITY ENGINEER
PROJ. NO. C28-46 DATE-