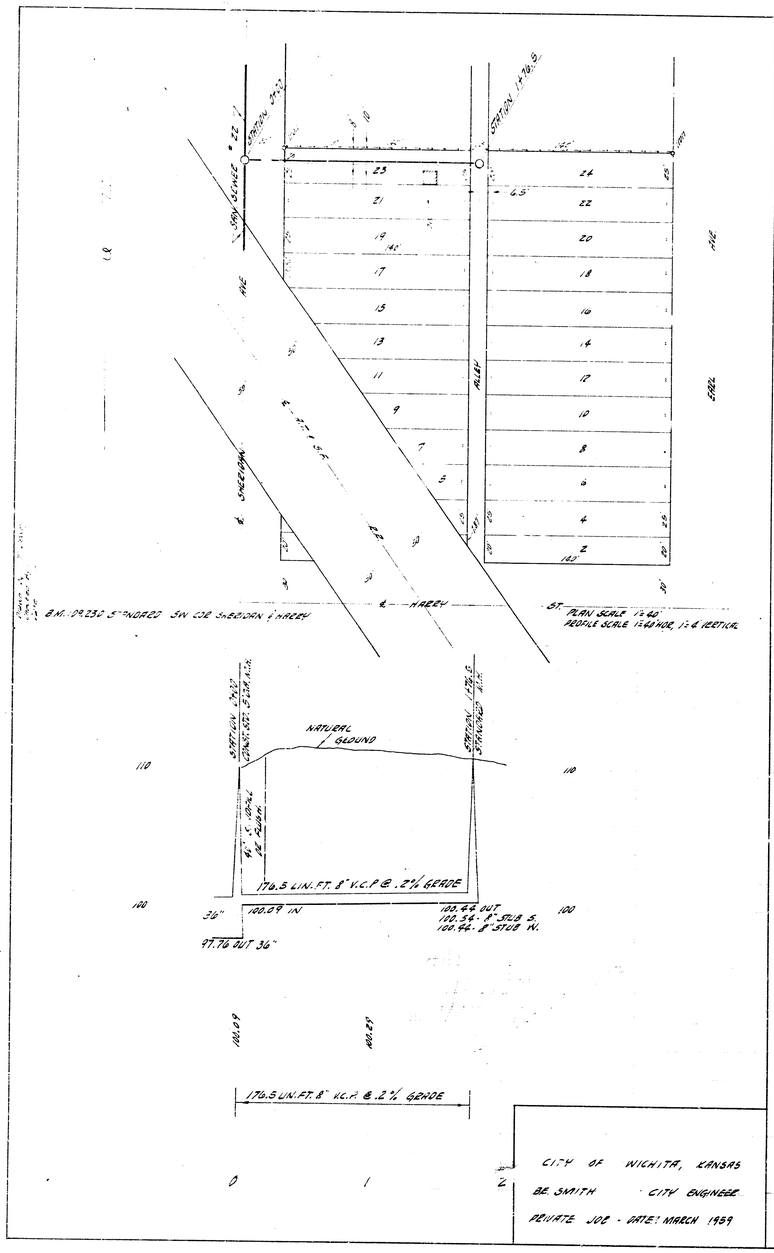
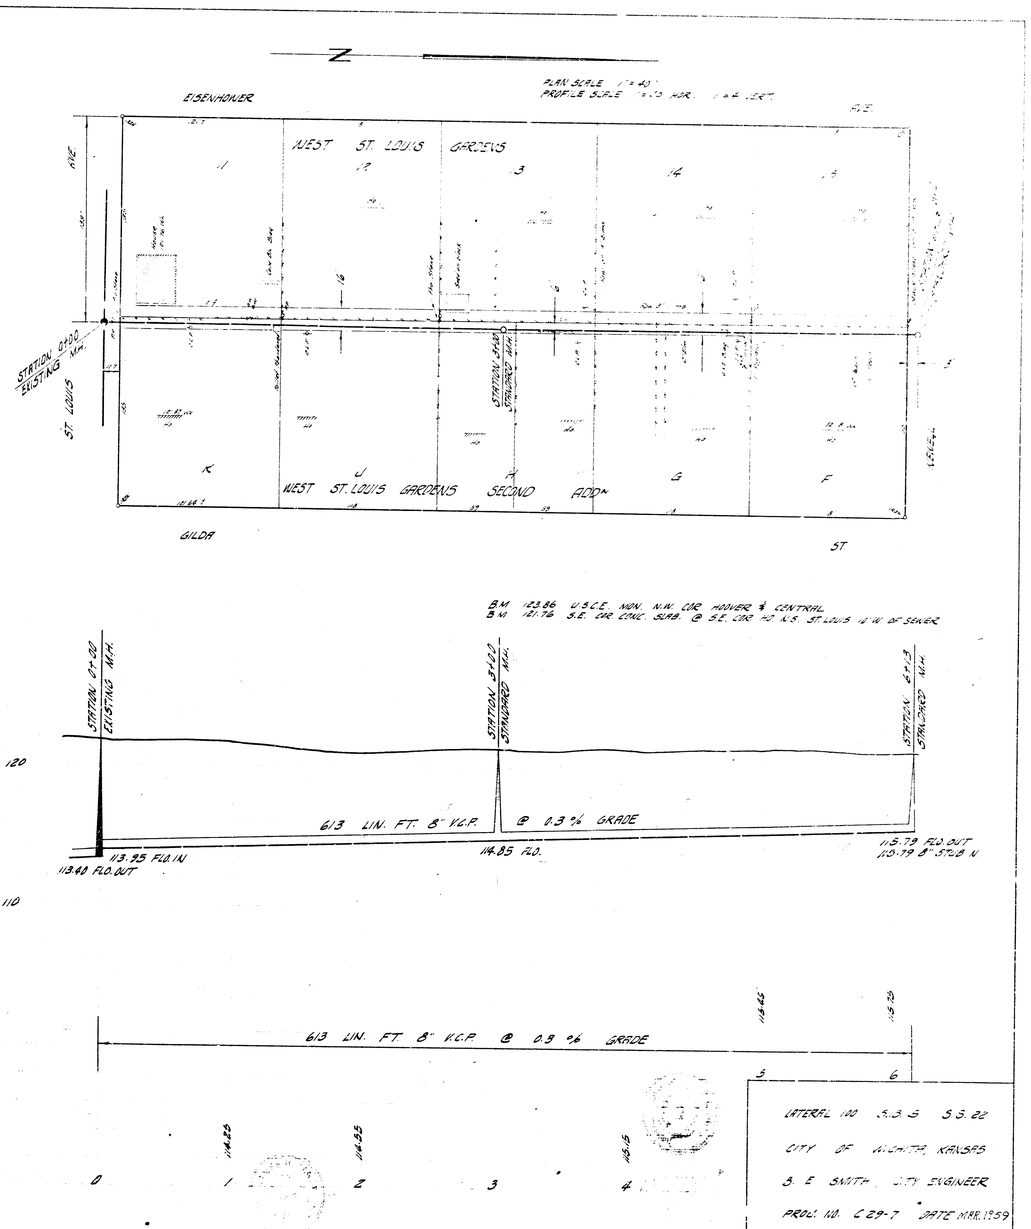

ALLEY
SHERIDAN
AVE
AVE
AVE
ST
B.M. DR 232 STANDARD SW COR SHERIDAN & HARRY
HARRY
PLAN SCALE 1"=40'
PROFILE SCALE 1"=40' HOR. 1"=4' VERT.
STATION 0+00 EXISTING M.H.
STATION 1+76.5 STANDARD M.H.
NATURAL GROUND
176.5 LIN. FT. 8" V.C.P. @ .2% GRADE
100.09 IN
100.44 OUT
100.34 - 8" STUB S.
100.44 - 8" STUB N.
97.76 OUT 36"
176.5 LIN. FT. 8" V.C.P. @ .2% GRADE
CITY OF WICHITA, KANSAS
B.E. SMITH - CITY ENGINEER
PRIVATE JOB - DATE: MARCH 1959


EISENHOWER
AVE
WEST ST. LOUIS GARDENS
ST. LOUIS
STATION 0+00 EXISTING M.H.
WEST ST. LOUIS GARDENS SECOND ADDN
GILDA
ST
B.M. 123.86 U.S.C.E. MON. N.W. COR. HOOVER & CENTRAL
B.M. 121.76 S.E. COR. CONC. SLAB @ S.E. COR. HD. U.S. ST. LOUIS 16' W. OF SEWER
STATION 0+00 EXISTING M.H.
613 LIN. FT. 8" V.C.P. @ 0.3 % GRADE
113.95 FLO. IN
113.40 FLO. OUT
114.85 FLO.
115.79 FLO. OUT
110.79 8" STUB N.
613 LIN. FT. 8" V.C.P. @ 0.3 % GRADE
LATERAL 100 S.S.S. S.S. 22
CITY OF WICHITA, KANSAS
B. E. SMITH, CITY ENGINEER
PROJ. NO. C 29-7 DATE MAR. 1959