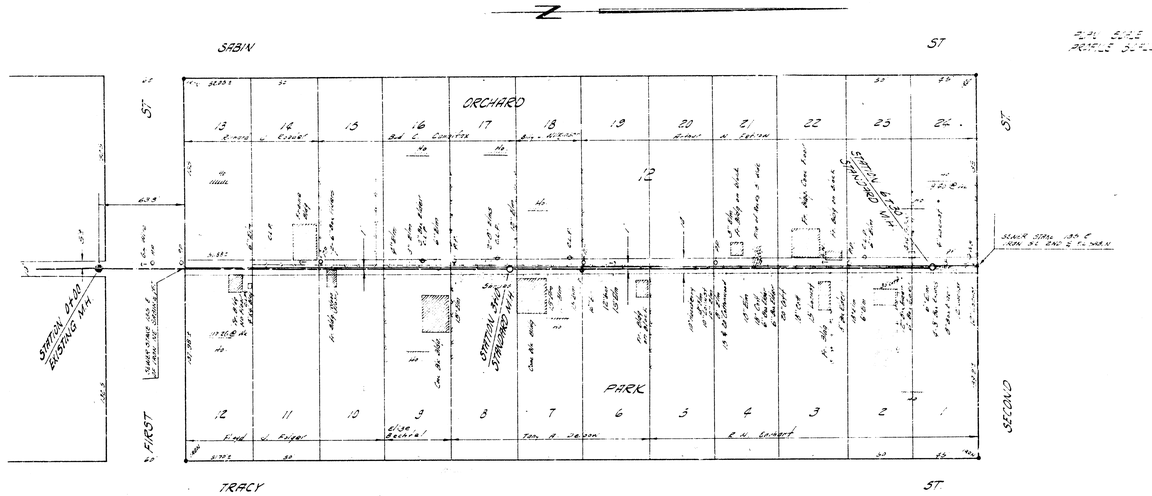

SABIN
ST
ORCHARD
PARK
FIRST
ST
SECOND
ST
TRACY
ST
STATION 0+00
EXISTING M.H.
STATION 6+30
STANDARD M.H.
STATION 6+30
STANDARD M.H.
SEWER SERVICE
SEWER SERVICE
SEWER SERVICE