Survey Lawson Skinner
Plan D. Cramer
Profile
Checked

B.M. 102.87 N.E. Cor. 1st Step on back porch of House S.E. Cor. Wildwood & St. Paul
B.M. 98.40 4" E. end S.E. Curb Return S.E. Cor. 30th & Gordon

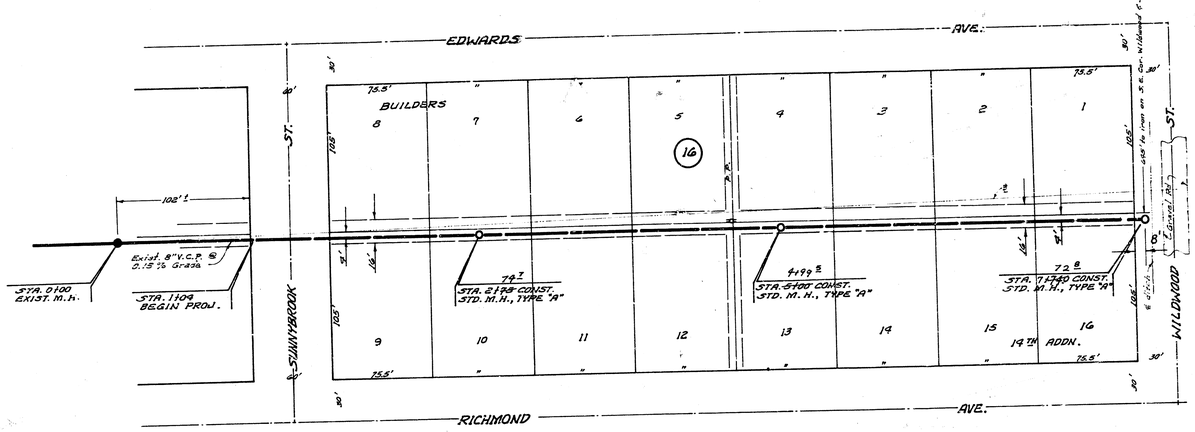

Plan Scale 1" = 40' Hor.
Profile Scale 1" = 4' Vert.

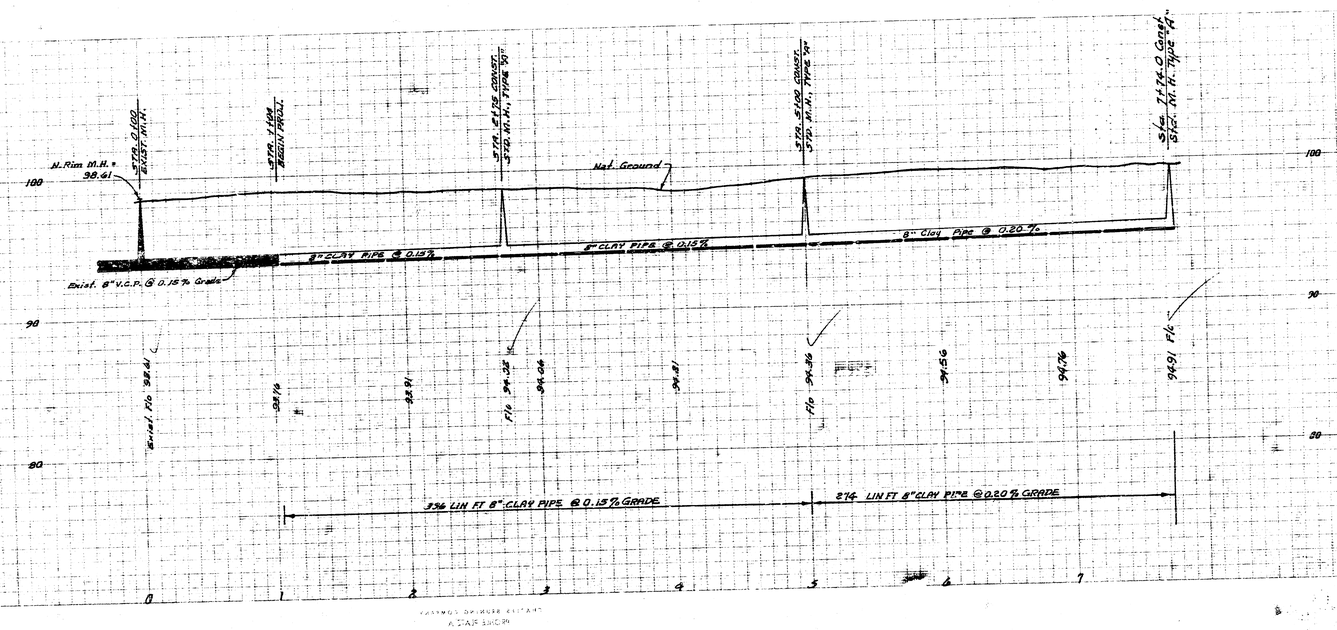

"As Built" Final Meas. SS" 11 JAK

LAT. 105, SAN. SEWER 22
CITY OF WICHITA, KANSAS
R. W. LINN, CITY ENGINEER
PROJ. NO. DBKLSG8005
DATE: NOV. 1973

FILMED FROM THE BEST AVAILABLE COPY ....