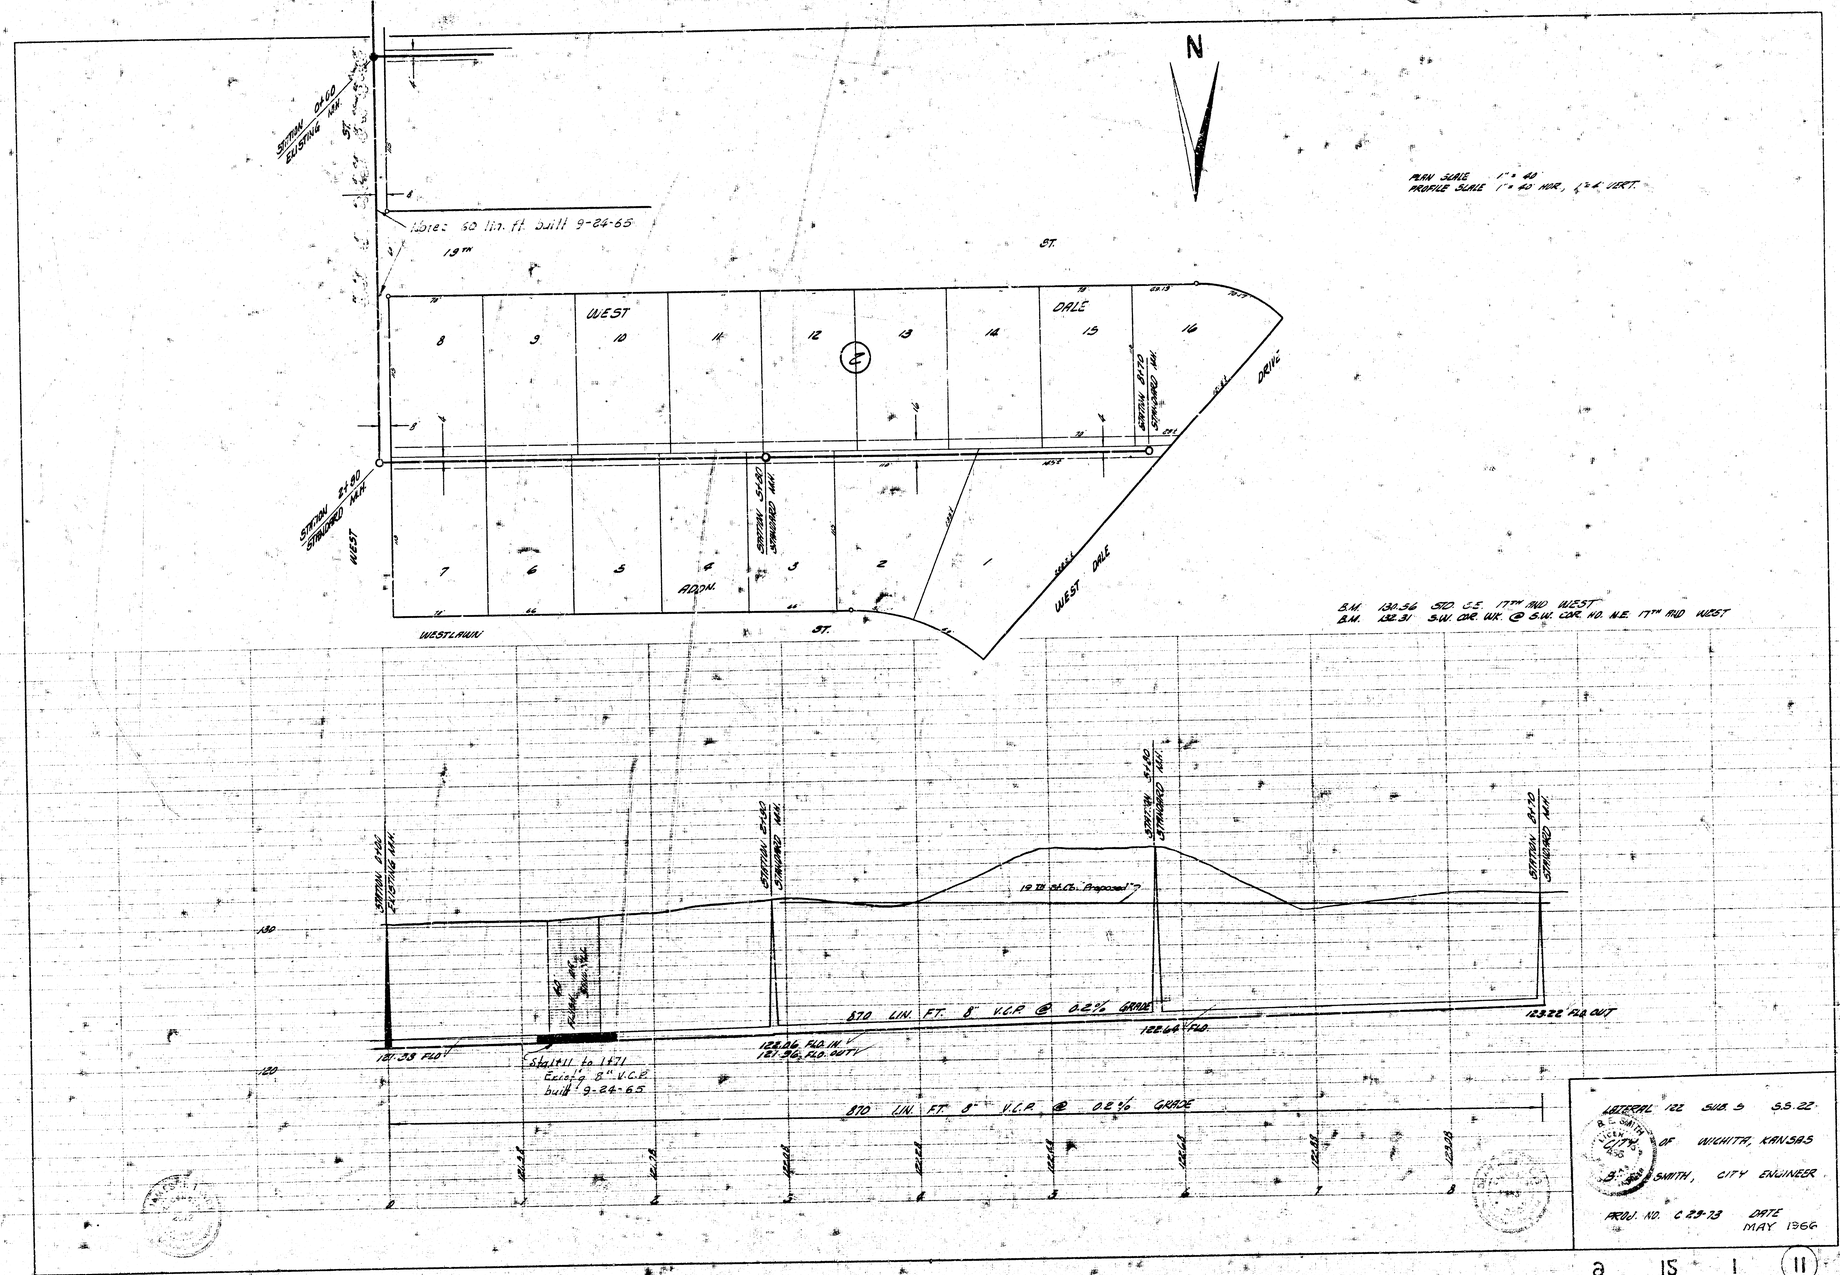
N
MAP SCALE 1" = 40
PROFILE SCALE 1" = 40 HOR., 1" = 4 VERT.
STATION 0+00 EXISTING MH.
19TH ST.
Lateral 50 lin. ft. built 9-24-65
WEST DALE
8
9
10
11
12
13
14
15
16
7
6
5
4
3
2
1
ADDN.
STATION 2+00 STANDARD MH.
STATION 3+00 STANDARD MH.
STATION 4+00 STANDARD MH.
STATION 5+00 STANDARD MH.
WEST DALE DRIVE
WESTLAWN ST.
B.M. 130.56 STD. S.E. 17TH AND WEST
B.M. 128.31 S.W. COR. WK. @ S.W. COR. NO. N.E. 17TH AND WEST
STATION 0+00 EXISTING MH.
STATION 2+00 STANDARD MH.
STATION 4+00 STANDARD MH.
STATION 6+00 STANDARD MH.
19 TH St. Co. Proposal
130
120
870 LIN. FT. 8" V.C.P. @ 0.2% GRADE
127.33 FLO
Station 1+11 to 1+71 Existing 8" V.C.P. built 9-24-65
122.06 FLO. IN
121.96 FLO. OUT
122.66 FLO.
123.22 FLO OUT
870 LIN. FT. 8" V.C.P. @ 0.2% GRADE
0
1
2
3
4
5
6
7
8
LATERAL 122 SUB. 5 S.S. 22
CITY OF WICHITA, KANSAS
B. SMITH, CITY ENGINEER
PROJ. NO. C 29-73 DATE MAY 1966

9 15 1 11