


BM 168.59 Stand SW Douglas & Oliver
172.71 x on w. ch. Dallas 10 N of NW Douglas

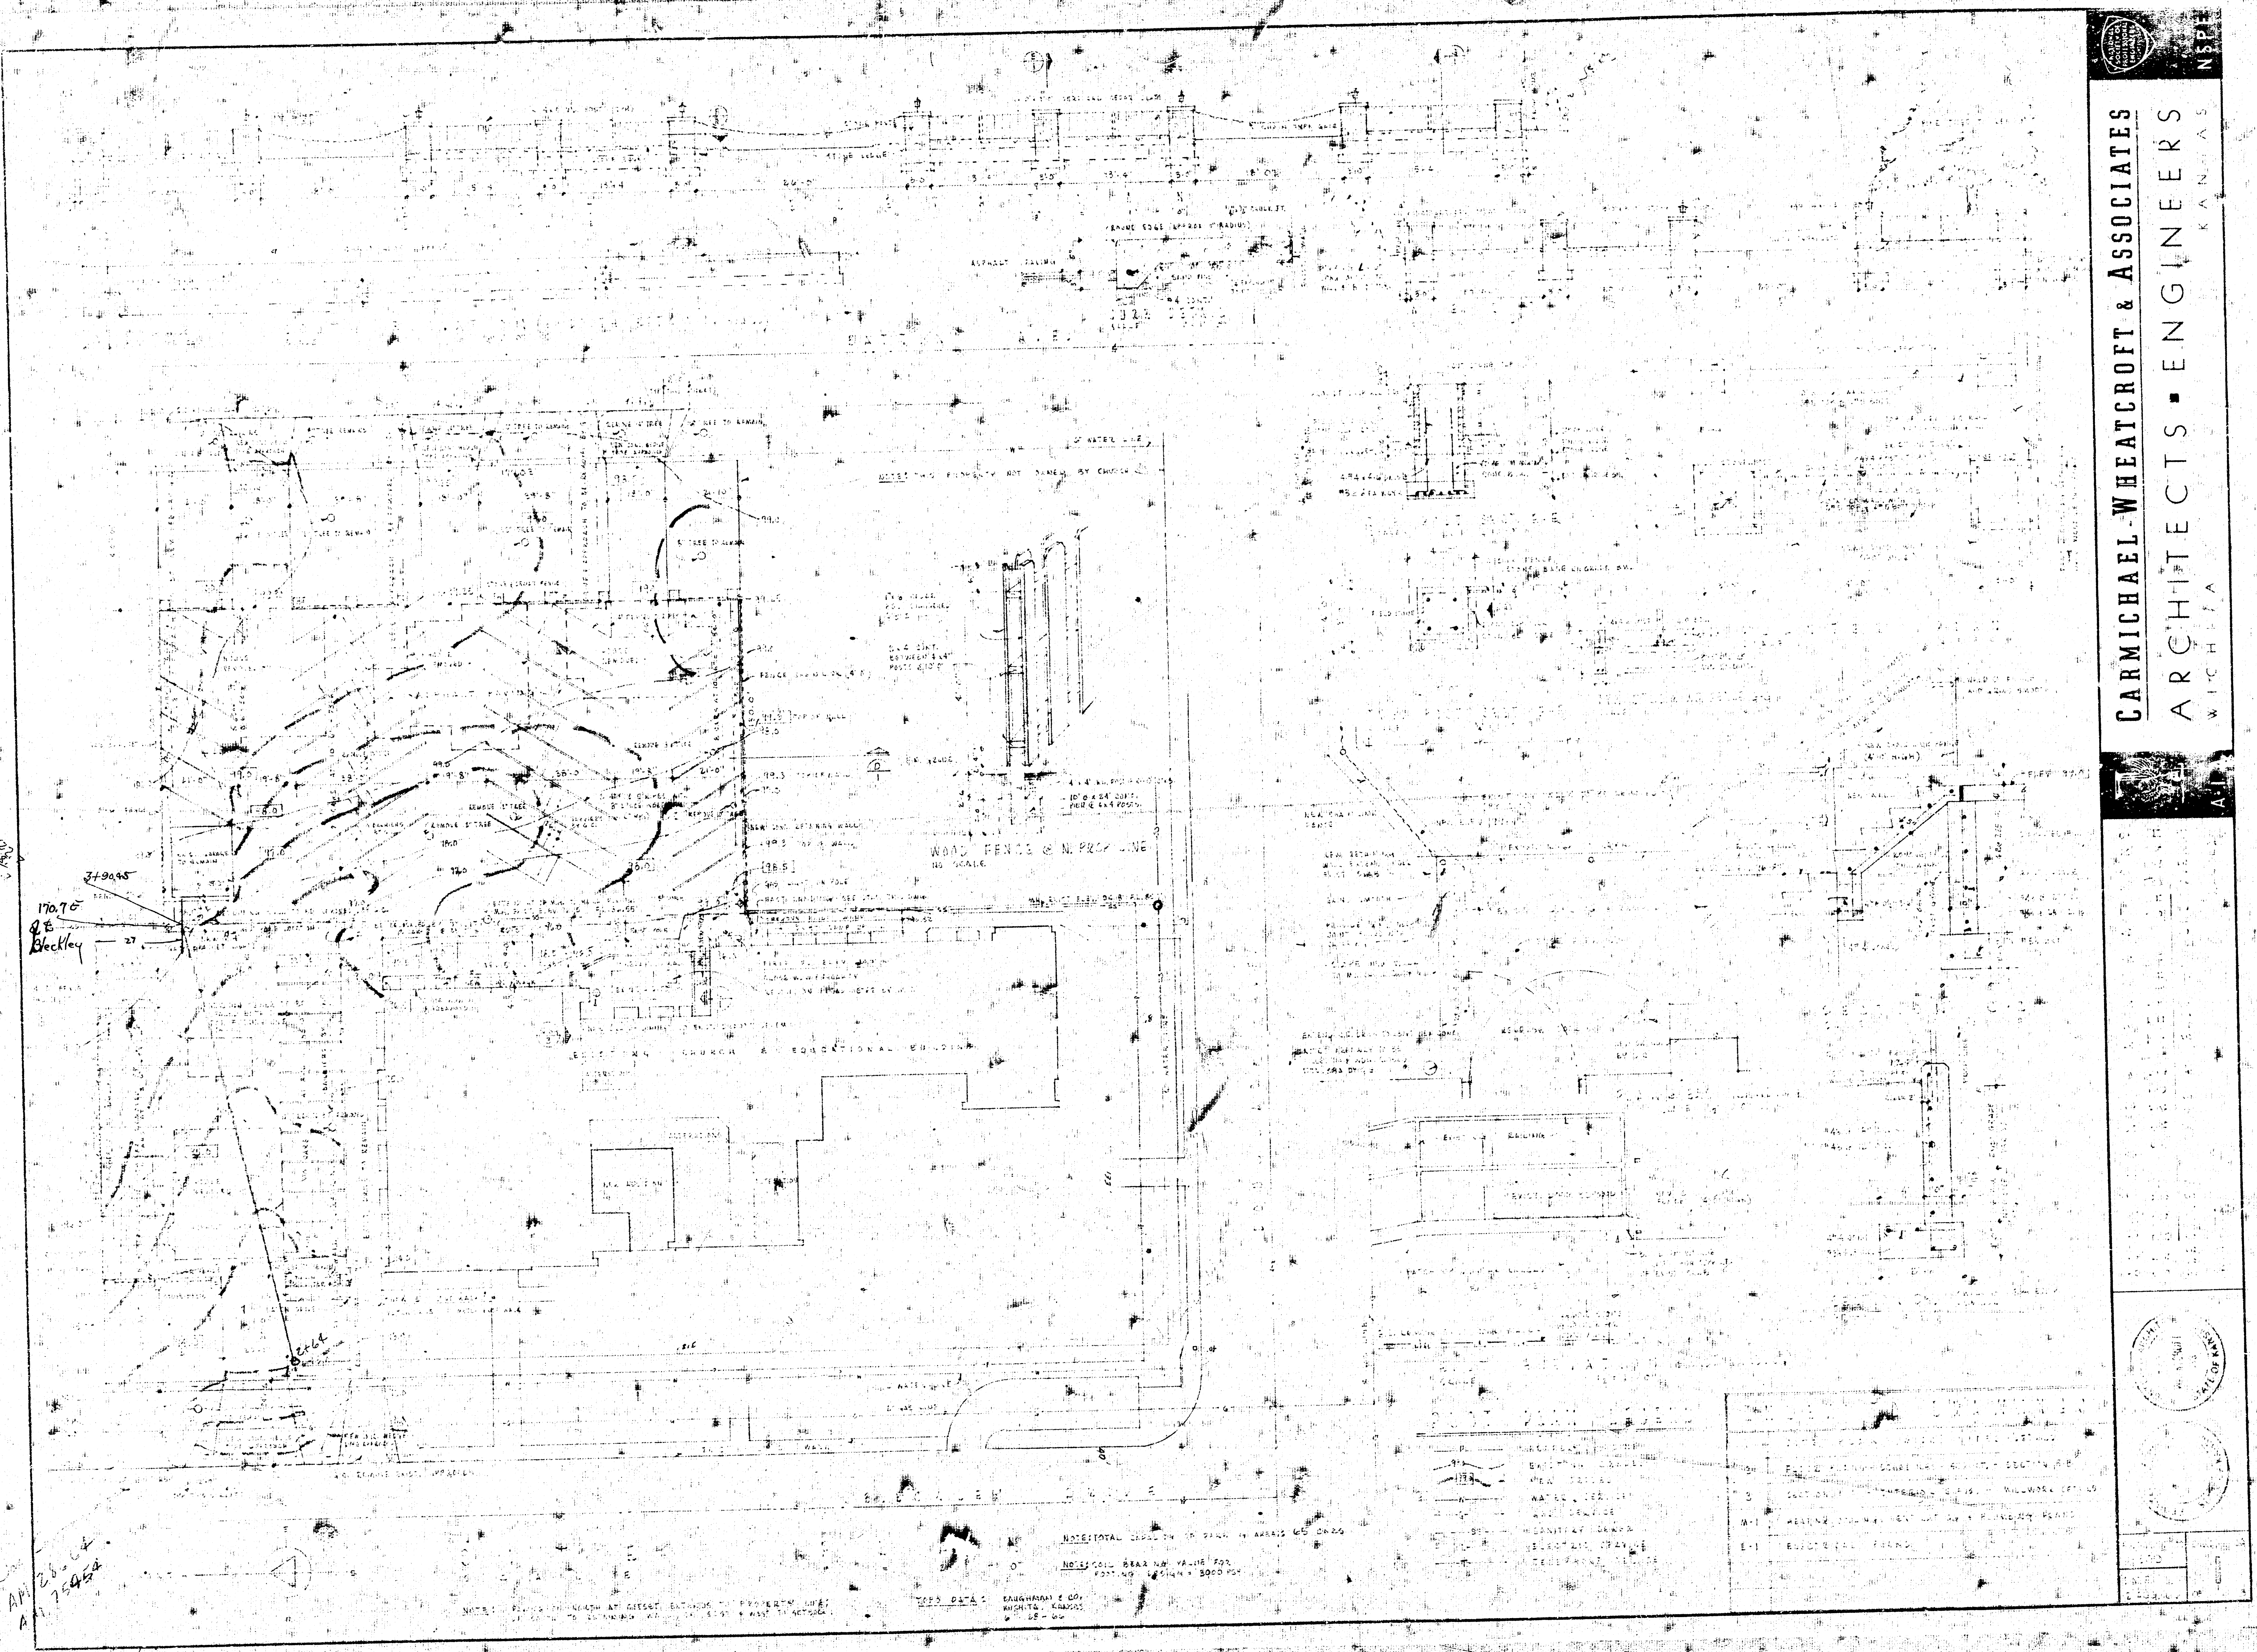

CARMICHAEL WHEATCROFT & ASSOCIATES
ARCHITECTS - ENGINEERS
WICHITA KANSAS

