NOTE: REMOVAL OF EXIST. STUB N. SHALL NOT BE PAID FOR DIRECTLY, BUT SHALL BE INCLUDED IN THE COST OF THE PROJECT.

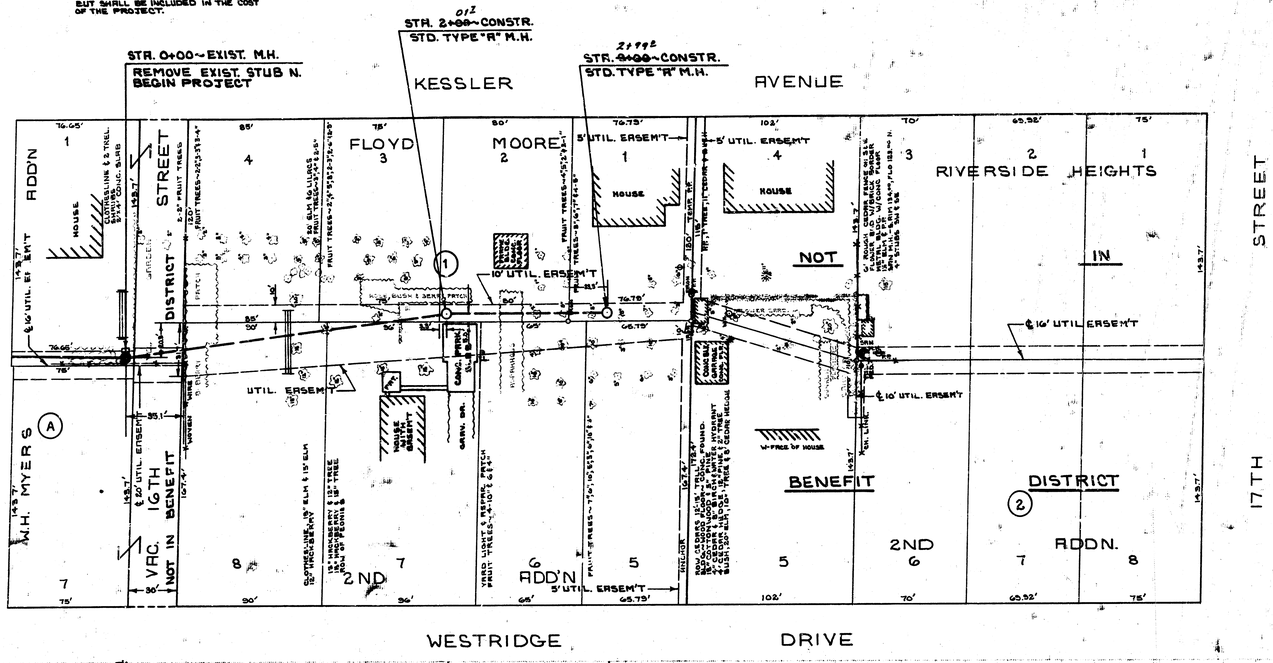

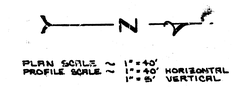

BM #1~129.423 ~ NE COR. CONC. PORCH HOUSE #1649 N. KESSLER

BM #2~130.95 ~ "H" IN RITCHIE TOP WEST CB ON KESSLER AVE. 1 FT. N. OF N.L. 17TH ST.

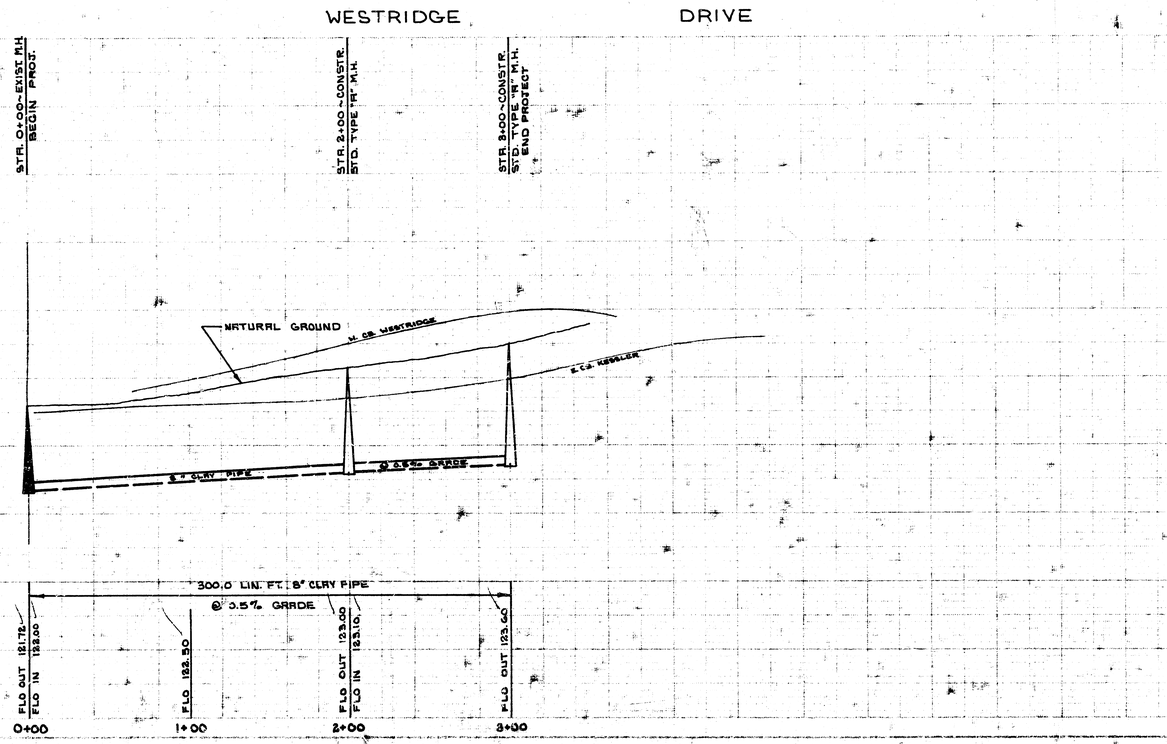

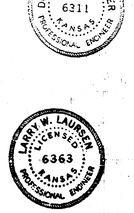

"As Built" Final Mes. K-111

LAT. 212~MAIN 5~ S.S. #22

CITY OF WICHITA

R.W. LINN ~ CITY ENGINEER

DATE FEB. 1973 PROJ. NO. DBKL 572028

14 2 1 10. Eng. 11. Water 3

FILMED FROM THE BEST