




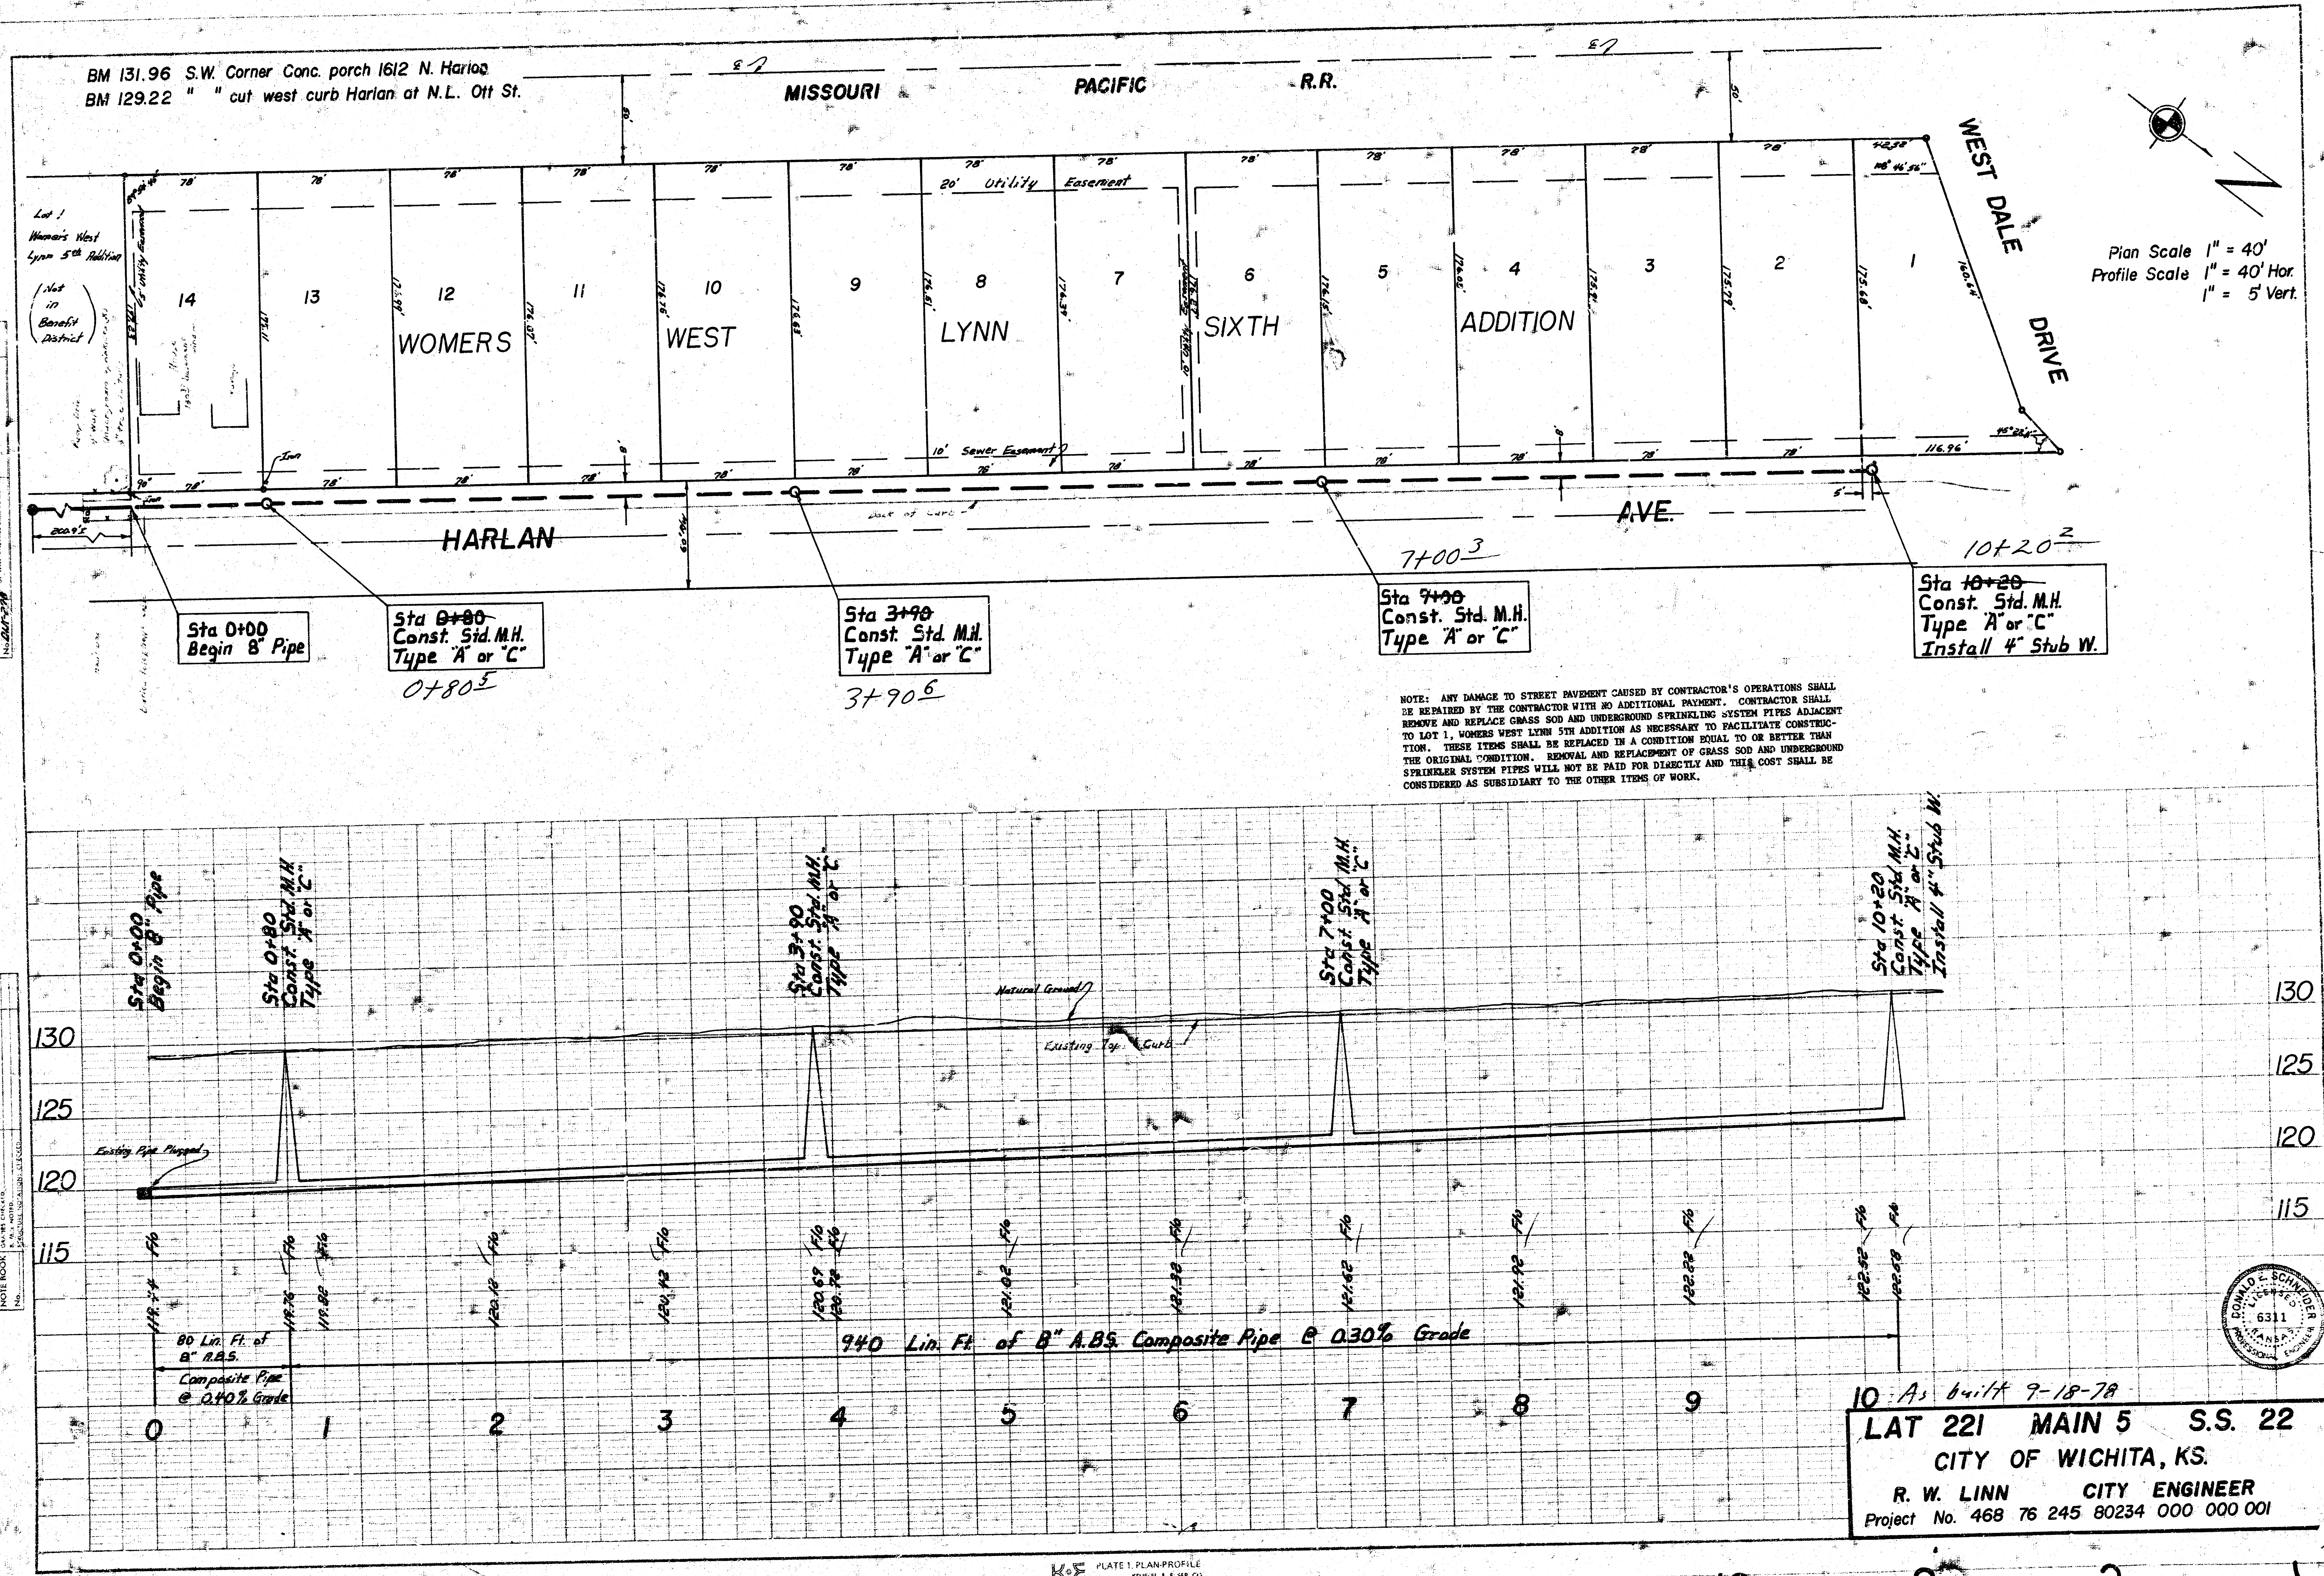

FILMED FROM THE BEST AVAILABLE COPY...