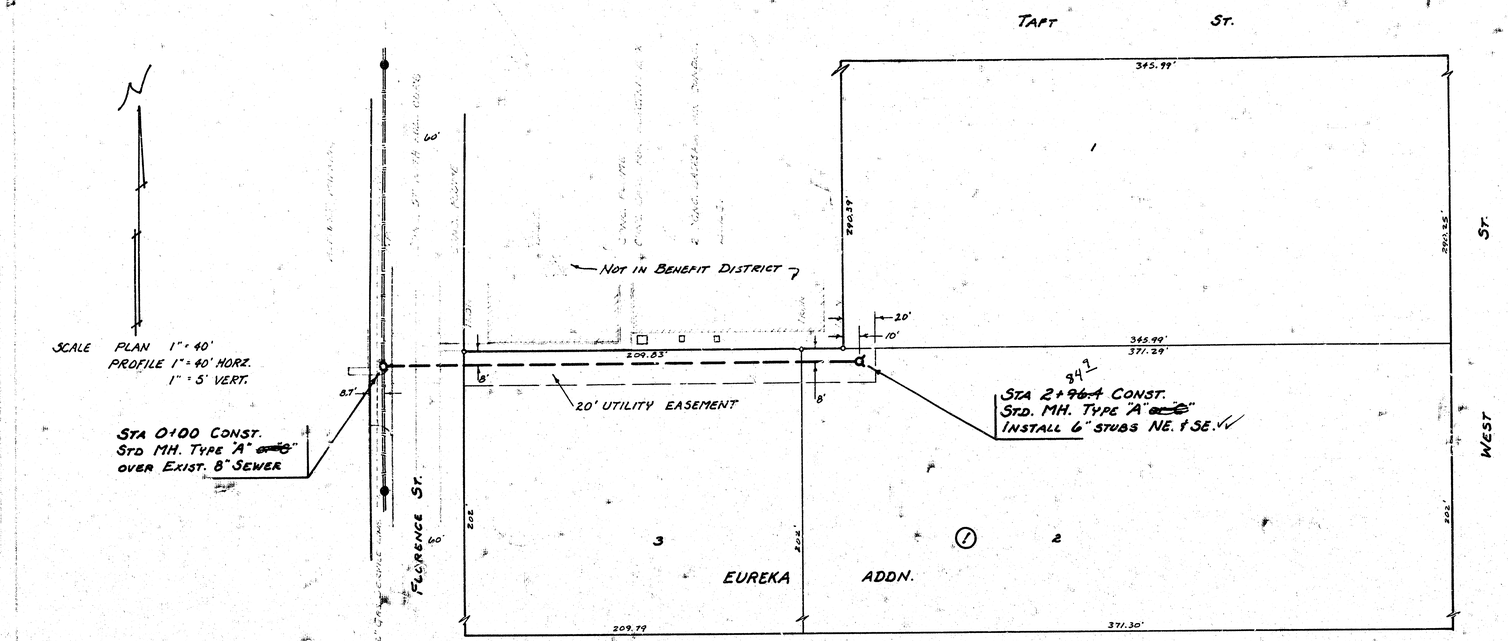

SCALE PLAN 1" = 40'
PROFILE 1" = 40' HORZ.
1" = 5' VERT.

M. CARPENTER 11/81
K. LOOTS 11/81
PLAN MAP 13

THE CONTRACTOR SHALL BE RESPONSIBLE FOR PRESERVING PROPERTY MONS. THE CONTRACTOR SHALL BE REQUIRED TO RE-ESTABLISH ANY PROPERTY MONS WHICH ARE DAMAGED OR DESTROYED BY HIS CONSTRUCTION OPERATIONS. SUCH MONS SHALL BE RE-ESTABLISHED BY A LICENSED LAND SURVEYOR OR A LICENSED PROFESSIONAL ENGINEER IN ACCORDANCE WITH STATE LAWS.

B.M. 120.12 "D" TOP ON 2.5' DIA. CONC. BASE TO LIGHT TOWER 53' E. OF ℄ TRACY AND 90.5' S. OF ℄ TAFT.

B.M. 119.68 "R" TOP ON 2.5' DIA. CONC. BASE TO LIGHT TOWER 40' W. OF ℄ FLORENCE ON N. SIDE 2ND DRIVEWAY TO K-MART S. OF TAFT.

PROFILE

As Built
J.L.L.
6/82

DONALD E. SCHNEIDER
LICENSED
6311
KANSAS
ENGINEER

LAT. 234, MAIN 5, SAN. SEW. NO. 22
CITY OF WICHITA, KANSAS
R. W. BRUGGEMAN
DIRECTOR OF ENGINEERING / CITY ENGINEER
PROJ. NO. 468-76-245-81164-000-000-001

1/1