LATERAL 235, MAIN 5

SANITARY SEWER NO. 22

Project no. 468-76-245-81210-000-000-001

CITY OF WICHITA, KANSAS

MIKE LINDEBAK CITY ENGINEER

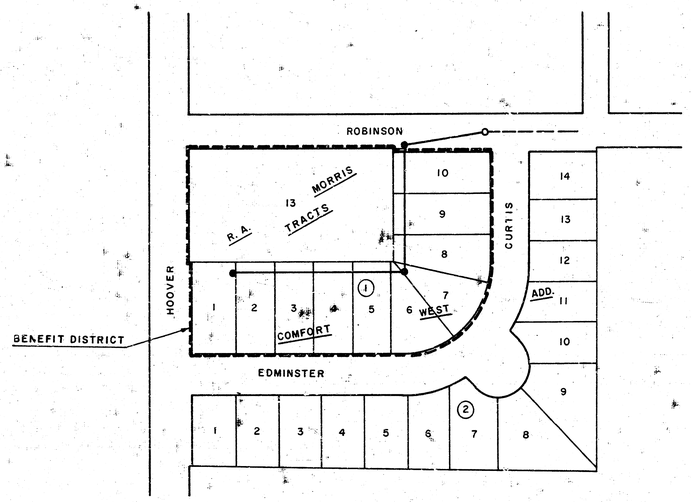

LOCATION MAP

As Built
J.L.L
8-84

JUNE 1984

BAUGHMAN COMPANY, P.A.
SURVEYING & ENGINEERING
316/262-7271 • 332 LAURA • WICHITA, KANSAS 67211

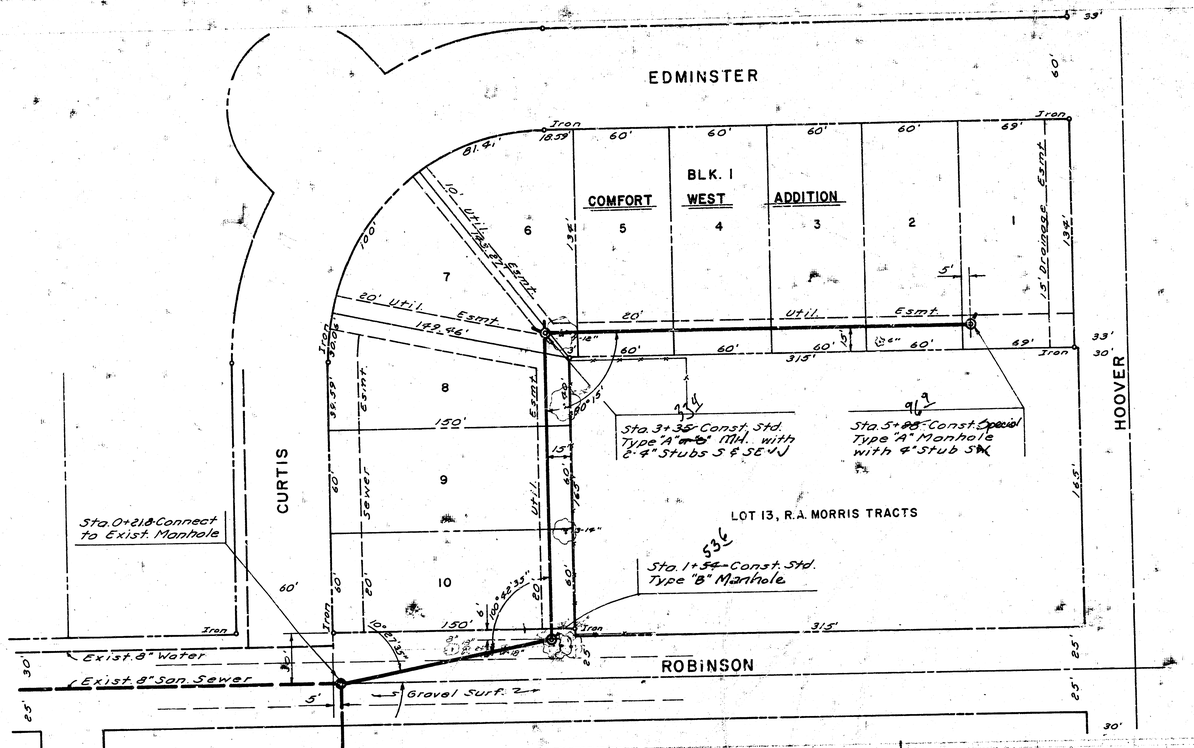

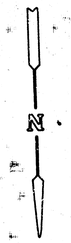

Scale: Hor. 1"=40'
Ver. 1"=5'

NOTE: TREE REMOVAL SHALL BE INCIDENTAL TO L.F. PIPE.

B.M. City disc 34'E. & 42'S. & Hoover & 9th
Elev. 126.89

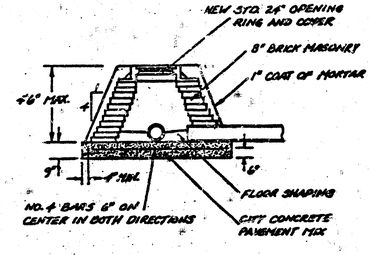

SPECIAL - MANHOLE "TYPE A"

As Built
J.LL
8-84

LATERAL 235, MAIN 5
SANITARY SEWER NO. 22

CITY OF WICHITA, KS.

PROJ. NO. 468-76-245-81210-000-000-001

BAUGHMAN COMPANY, P.A.
SURVEYING & ENGINEERING
314/262-7271 • 539 LAURA • WICHITA, KANSAS 67211

W. BRENT WOOTEN
LICENSED
8470
KANSAS
PROFESSIONAL ENGINEER

14842

2/2