Sheet 1 of 1

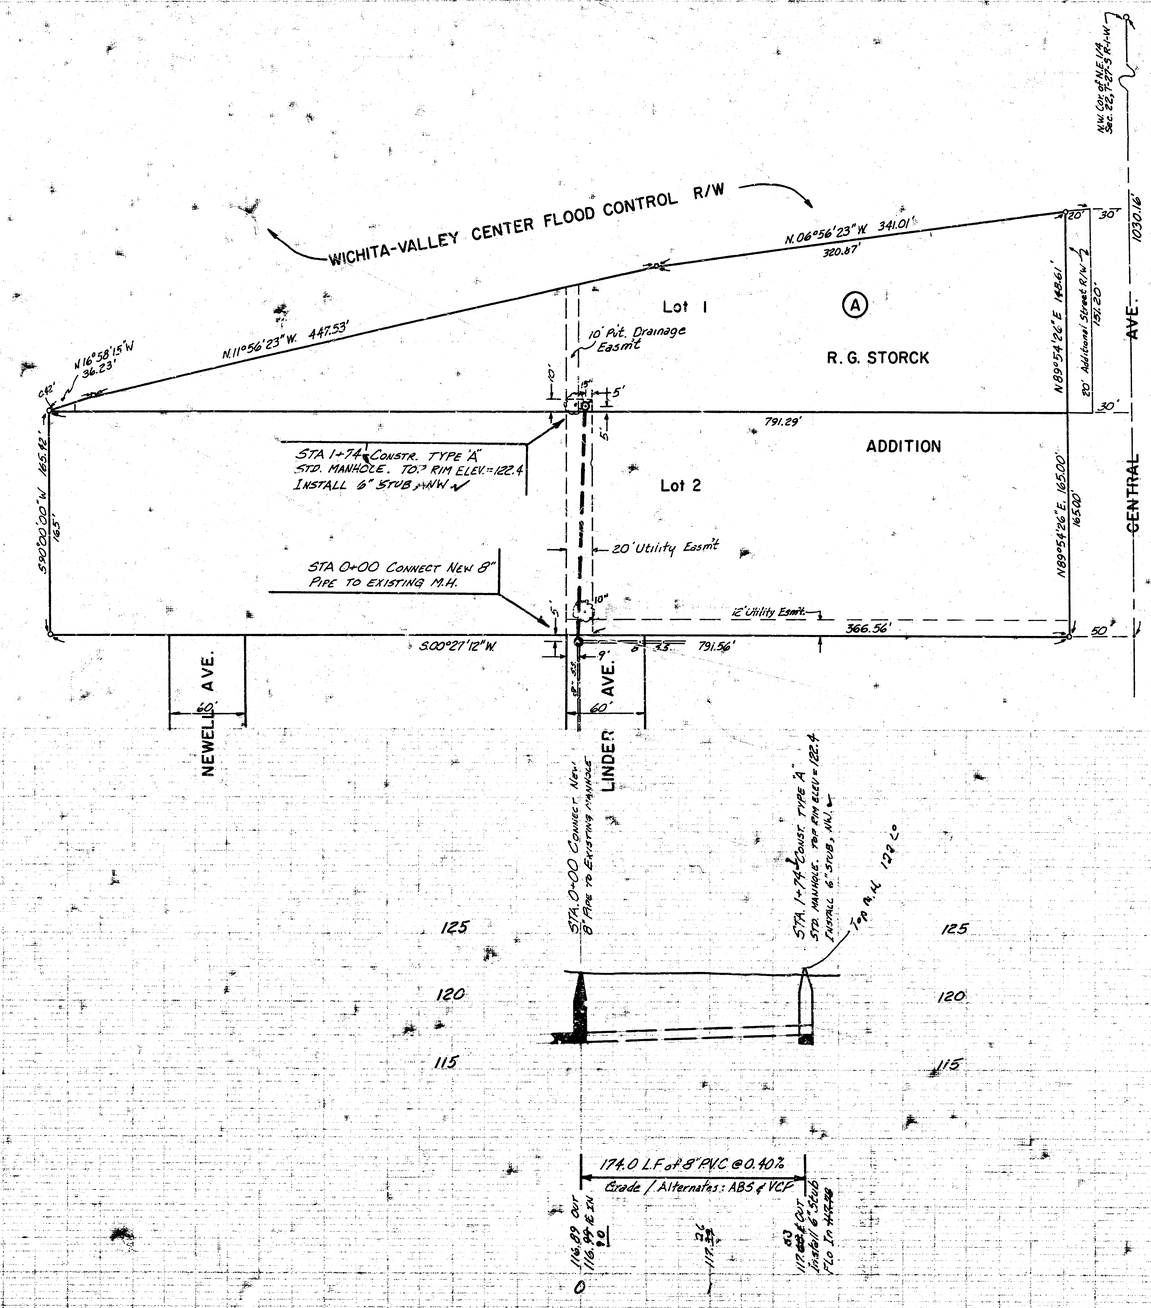

As Built
JLL
1-84

N

SCALE: Plan 1"=50'
Profile 1"=50' Horz.
1"=5' Vert.

BENCH MARK: 132.548 - City Std. Disc., NE Corner of Bridge over Big Ditch Floodway on West Central.

THE CONTRACTOR SHALL BE RESPONSIBLE FOR PRESERVING PROPERTY IRONS. THE CONTRACTOR SHALL BE REQUIRED TO RE-ESTABLISH ANY PROPERTY IRONS WHICH ARE DAMAGED OR DESTROYED BY HIS CONSTRUCTION OPERATIONS. SUCH IRONS SHALL BE RE-ESTABLISHED BY A LICENSED LAND SURVEYOR OR A LICENSED PROFESSIONAL ENGINEER IN ACCORDANCE WITH STATE LAWS.

PROJECT DESCRIPTION
LAT. 239, MAIN 5, S.S. NO. 22

PROJECT NUMBER
468-76-245-81298-000-000-CC

BOOK NO. | APPROVED BY | DATE 10/83
DRAWN BY JNL | REVISED

CITY OF WICHITA
DEPARTMENT OF ENGINEERING
M.E. LINDERAK, CITY ENGINEER

SCALE