Sheet 1 of 1

As Built
JLL
1-84

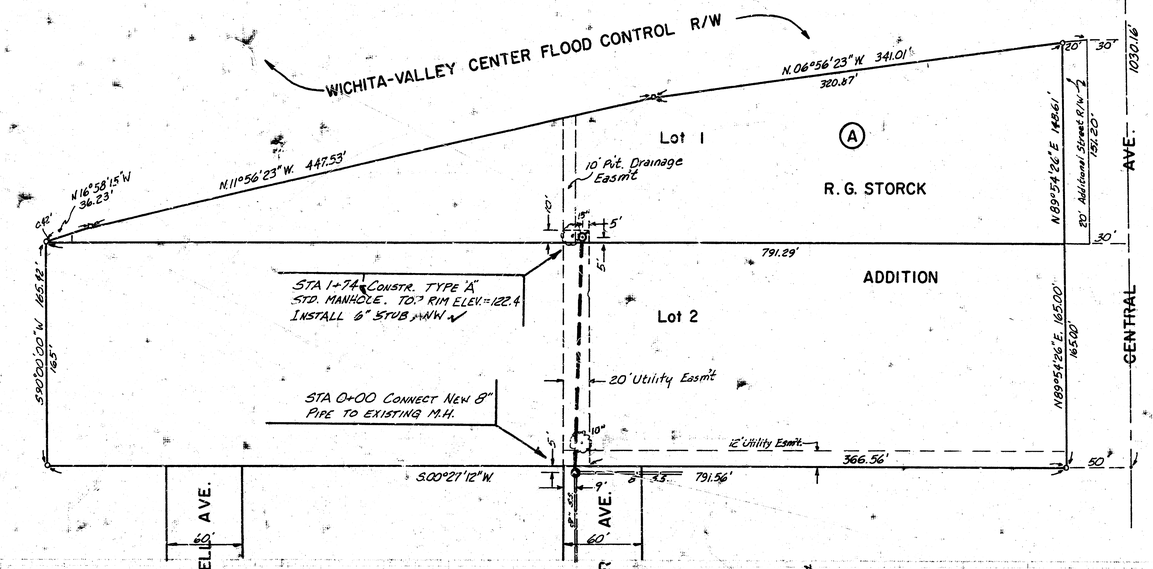

N

SCALE: Plan 1"=50'
Profile 1"=50' Horz.
1"=5' Vert.

BENCH MARK: 132.548 - City Std. Disc., NE Corner of Bridge over Big Ditch Floodway on West Central.

THE CONTRACTOR SHALL BE RESPONSIBLE FOR PRESERVING PROPERTY IRONS. THE CONTRACTOR SHALL BE REQUIRED TO RE-ESTABLISH ANY PROPERTY IRONS WHICH ARE DAMAGED OR DESTROYED BY HIS CONSTRUCTION OPERATIONS. SUCH IRONS SHALL BE RE-ESTABLISHED BY A LICENSED LAND SURVEYOR OR A LICENSED PROFESSIONAL ENGINEER IN ACCORDANCE WITH STATE LAWS.

LICENSED 3206 KANSAS PROFESSIONAL ENGINEER

PROJECT DESCRIPTION	LAT. 239, MAIN 5, S.S. NO. 22
PROJECT NUMBER	468-76-245-81290-000-000-00
BOOK NO. / APPROVED BY	DATE 1/8/83
DRAWN BY JNL	REVISED
CITY OF WICHITA DEPARTMENT OF ENGINEERING	
R.E. LINDEBAK, CITY ENGINEER	SCALE