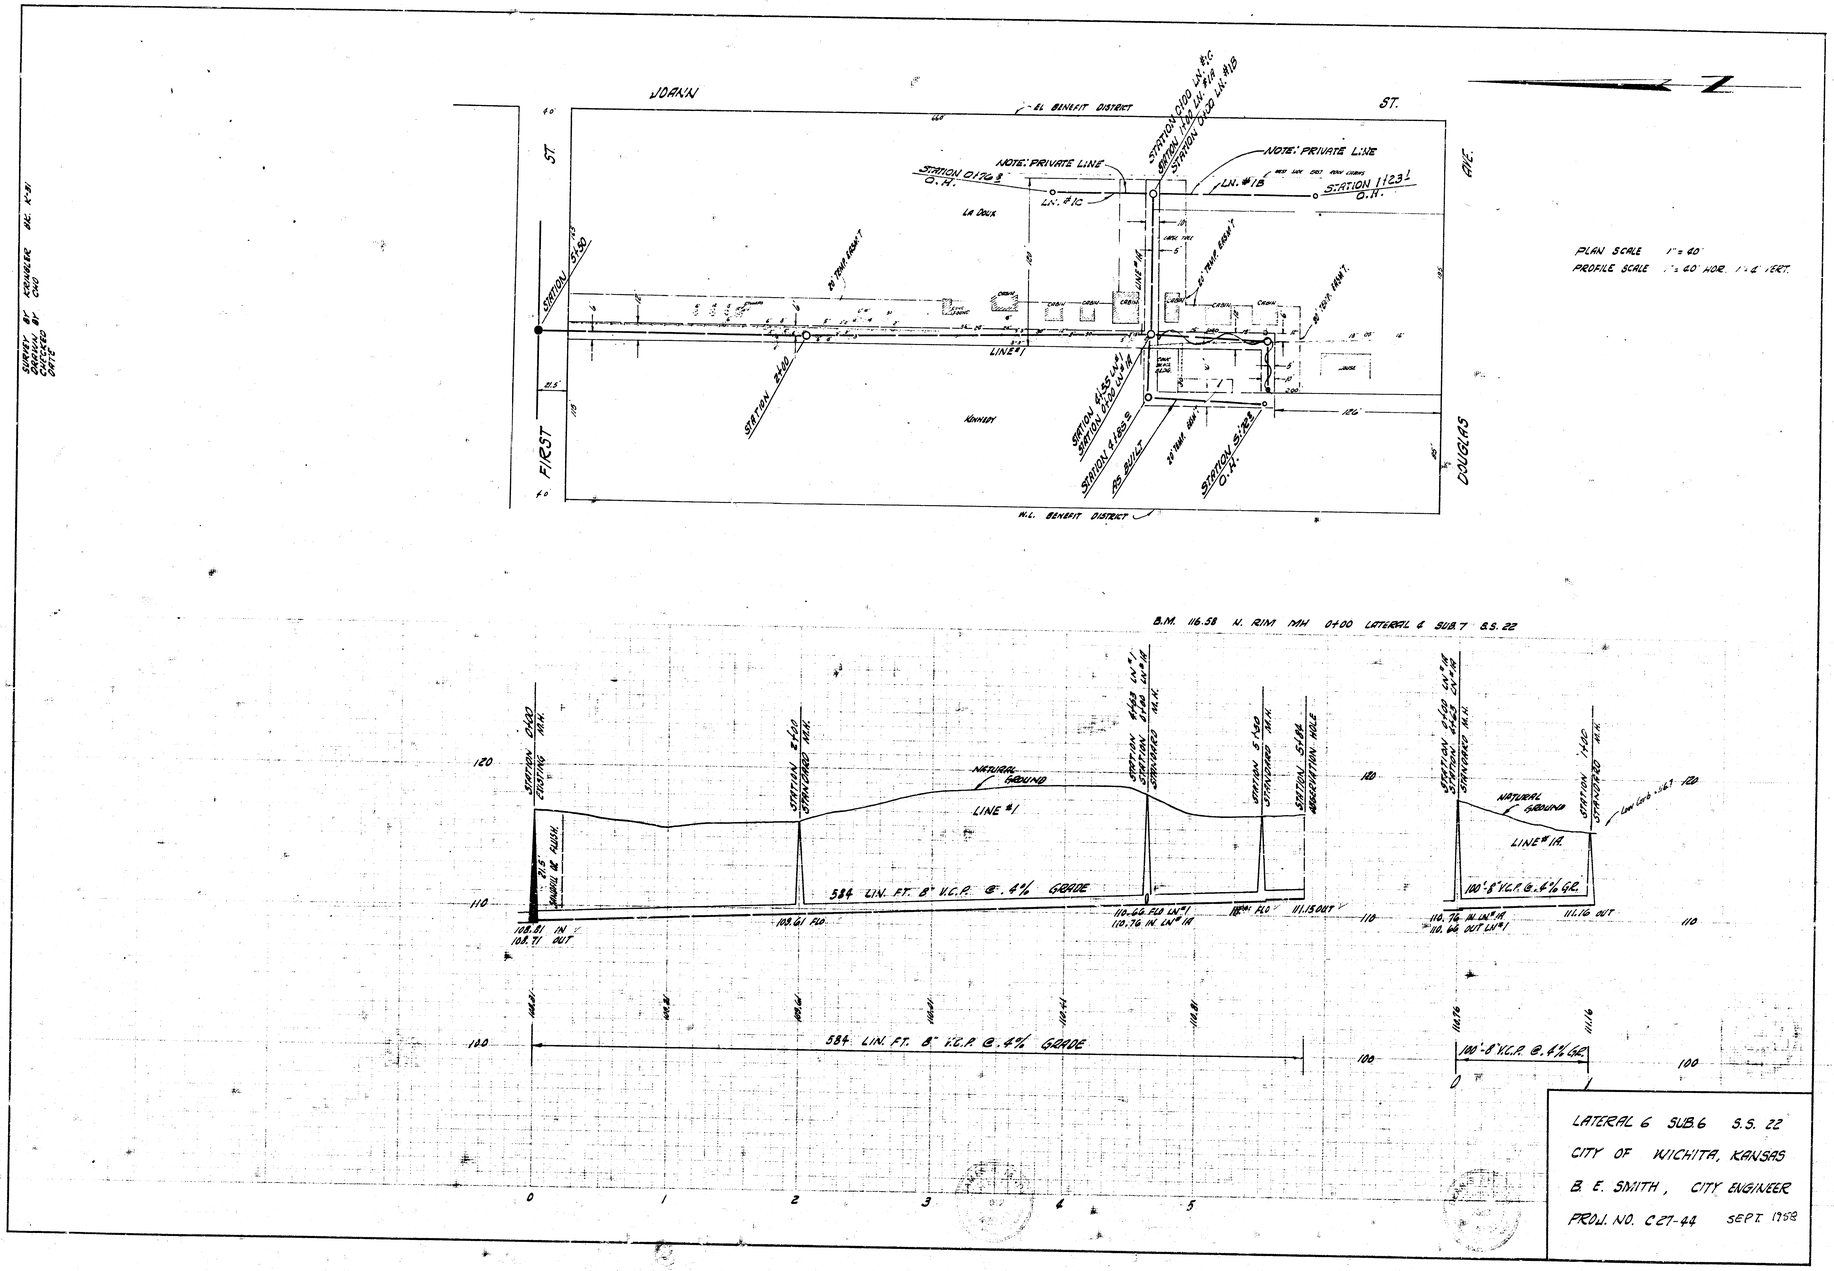

LATERAL 6 SUB. 6 S.S. 22
CITY OF WICHITA, KANSAS
B. E. SMITH, CITY ENGINEER
PROJ. NO. C27-44 SEPT. 1958