B.M. 121.66 City Std. 10' N. and 2' E. of S.E. Cor. (30' S. and 92' E. of ℄ SHERIDAN and CENTRAL)

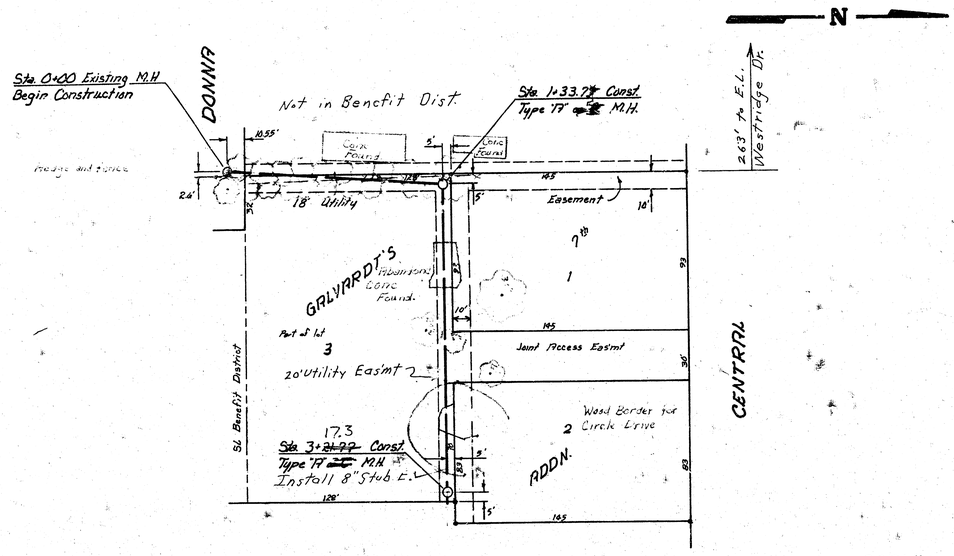

~SCALE~

PLAN 1" = 40'

PROFILE

Horz. 1" = 40'

Vert. 1" = 5'

NOTE: CONTRACTOR SHALL REPLACE WOOD BORDER FOR CIRCLE DRIVE. THIS WORK WILL NOT BE PAID FOR DIRECTLY AND SHALL BE CONSIDERED AS SUBSIDIARY TO THE OTHER ITEMS OF WORK.

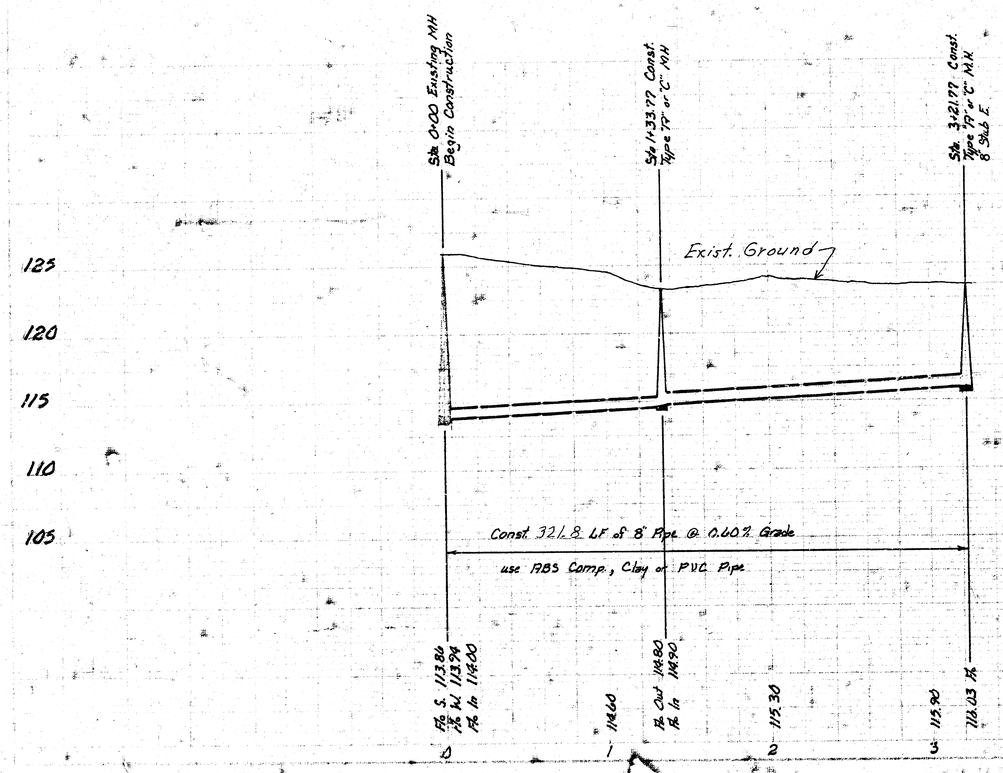

As Built 1/81

DONALD E. SCHNEIDER LICENSED 6311 KANSAS PROFESSIONAL ENGINEER

LATERAL 11, MAIN 8, SANITARY SEWER No. 22
Project No. 468-76-245-80898-000-000-001
DEAN SELLERS ~ Acting City ENGINEER
WICHITA, KANSAS
Date: _____