

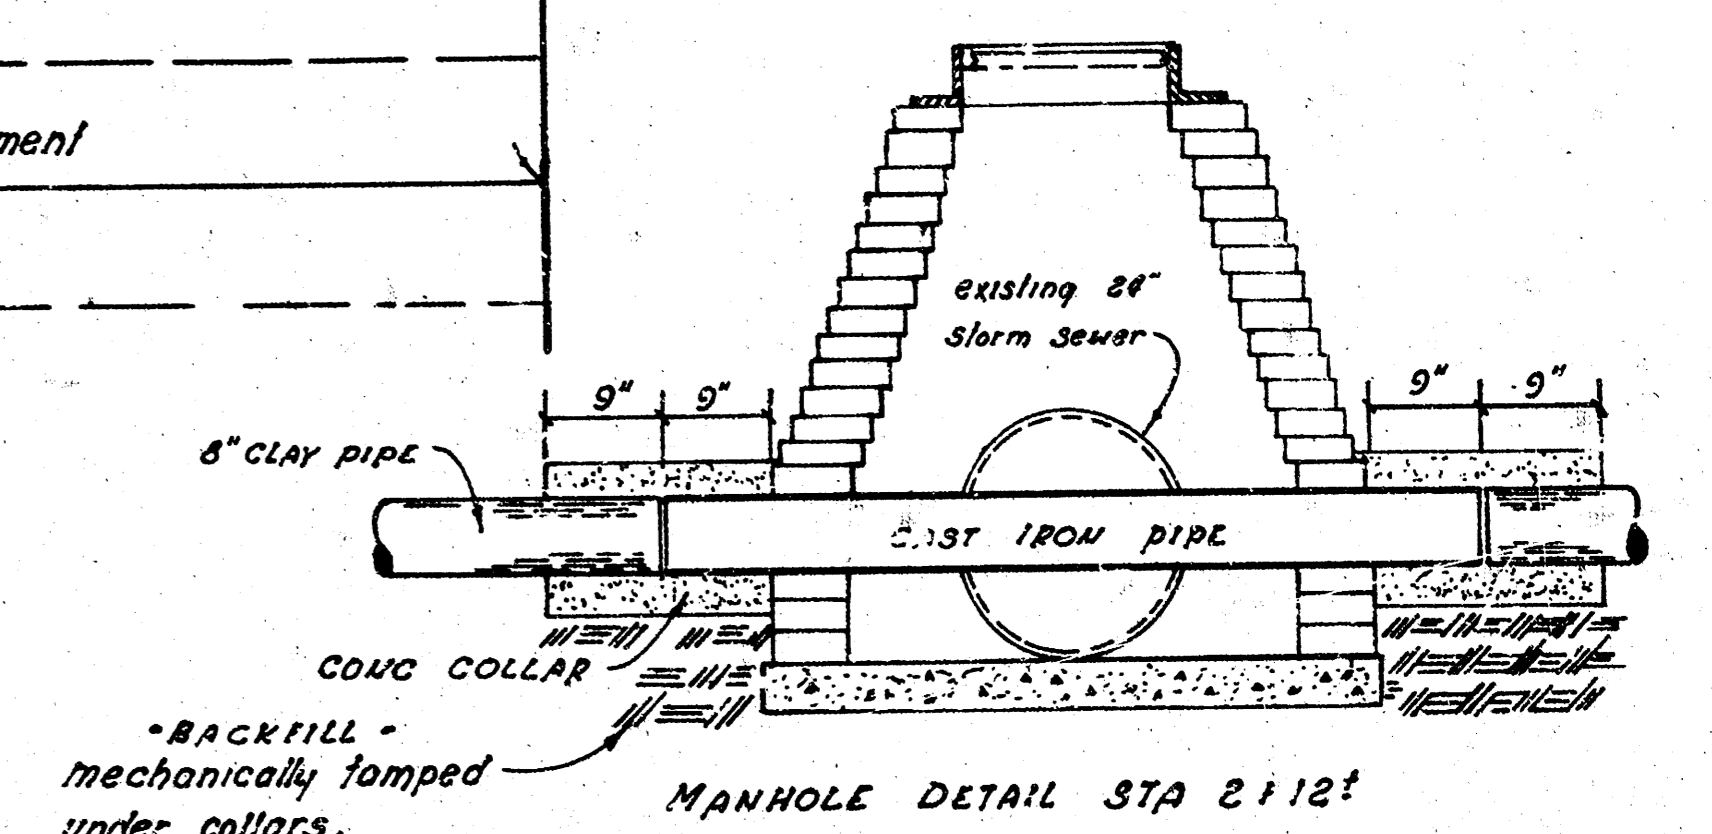


PLAN SCALE 1" = 20'
 PROFILE 1" = 20' HORIZ
 1" = 2' VERT

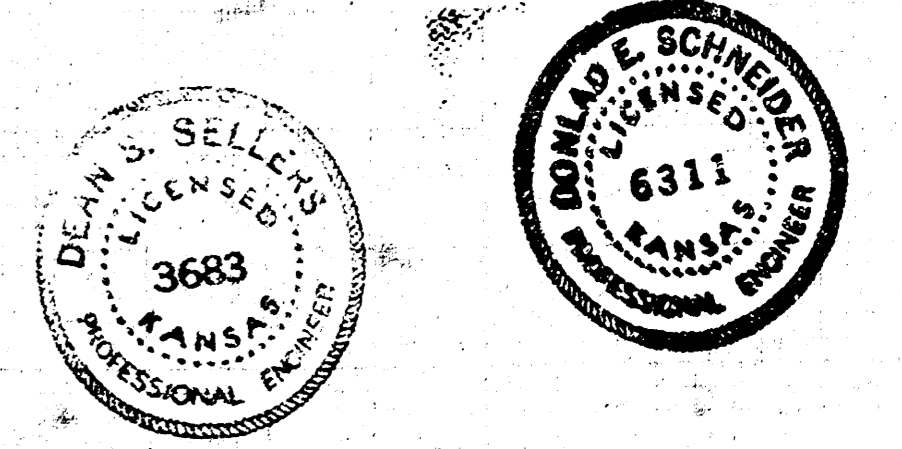

MANHOLE DETAIL STA 2112
 Concrete collars and compoacting fill under collars is to be included in bid price L.F. cast iron pipe.

NOTE: The exact limits of combined curb & gutter removed to be consistent with existing joint locations and determined by the engineer.
 Existing base pavement is to be sawed and matched.
 Sawing of existing pavt is to be included in bid price so pds pavt removed & replaced.

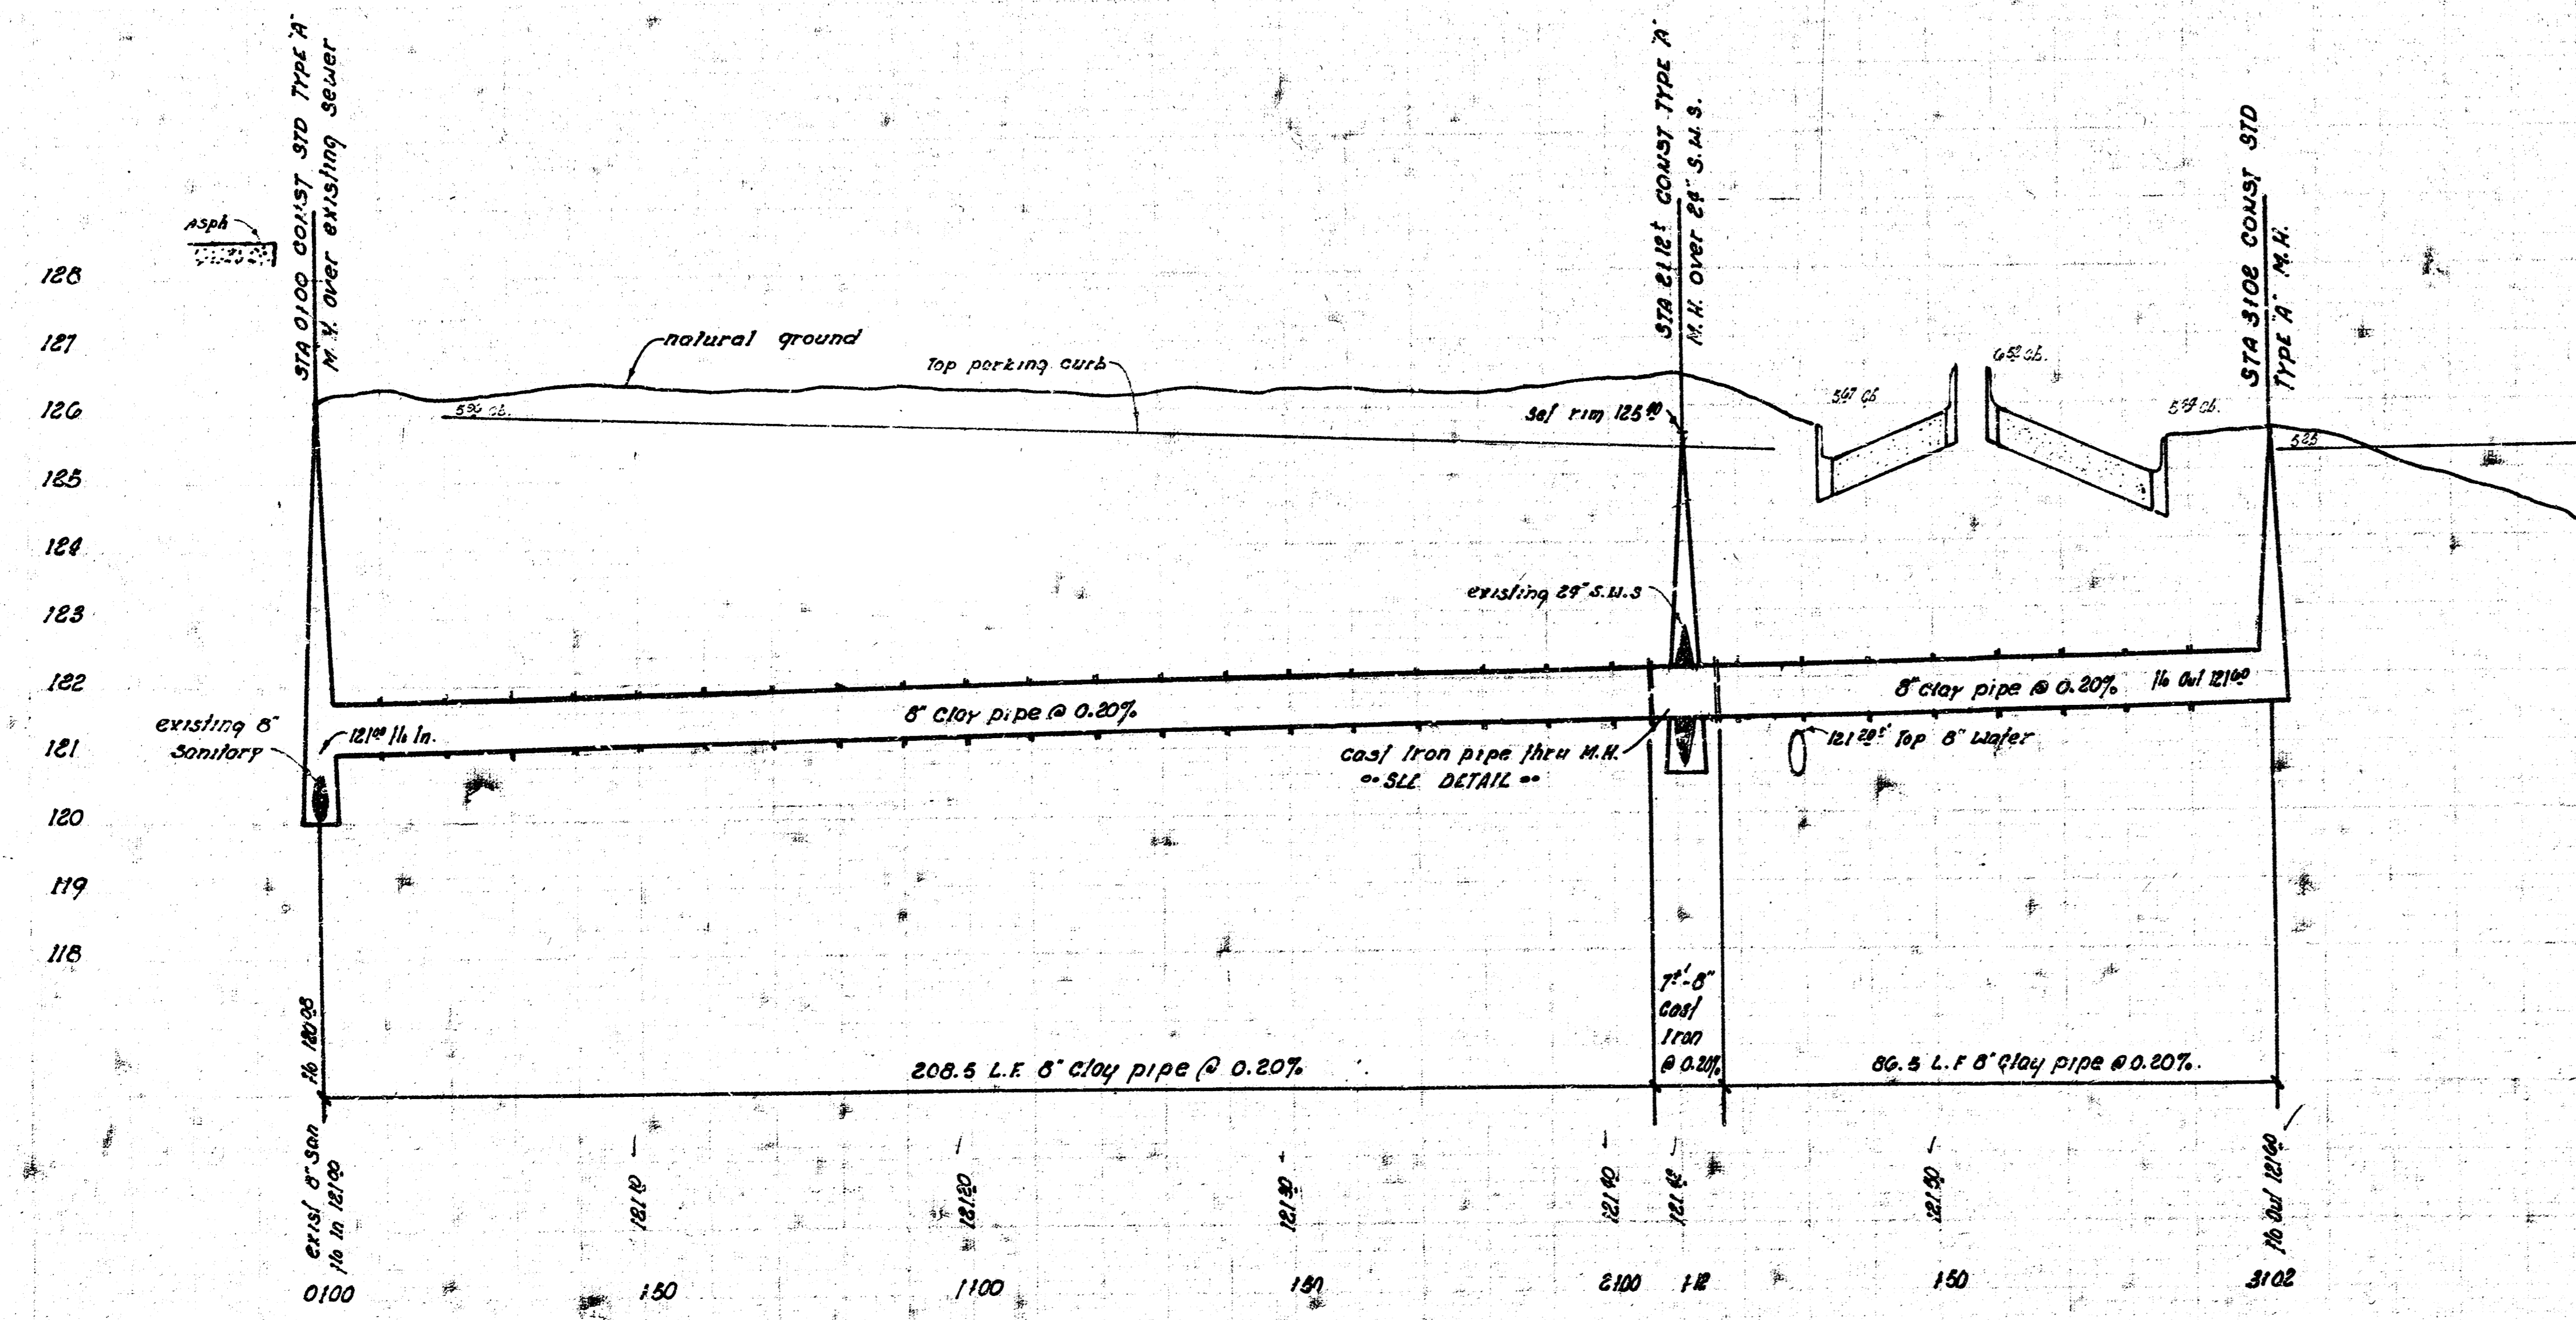

MS BUILT FROM FINAL MEASUREMENTS IN SS JK #4
 LATERAL 28, MAIN 9, S.S. # 22.
 CITY OF WICHITA, KANSAS
 R. W. LINN, CITY ENGINEER
 DATE Sept. 1972 PROJ. No. DBKL 572063

14 4 5 14

FILED FROM THE BEST AVAILABLE COPY