


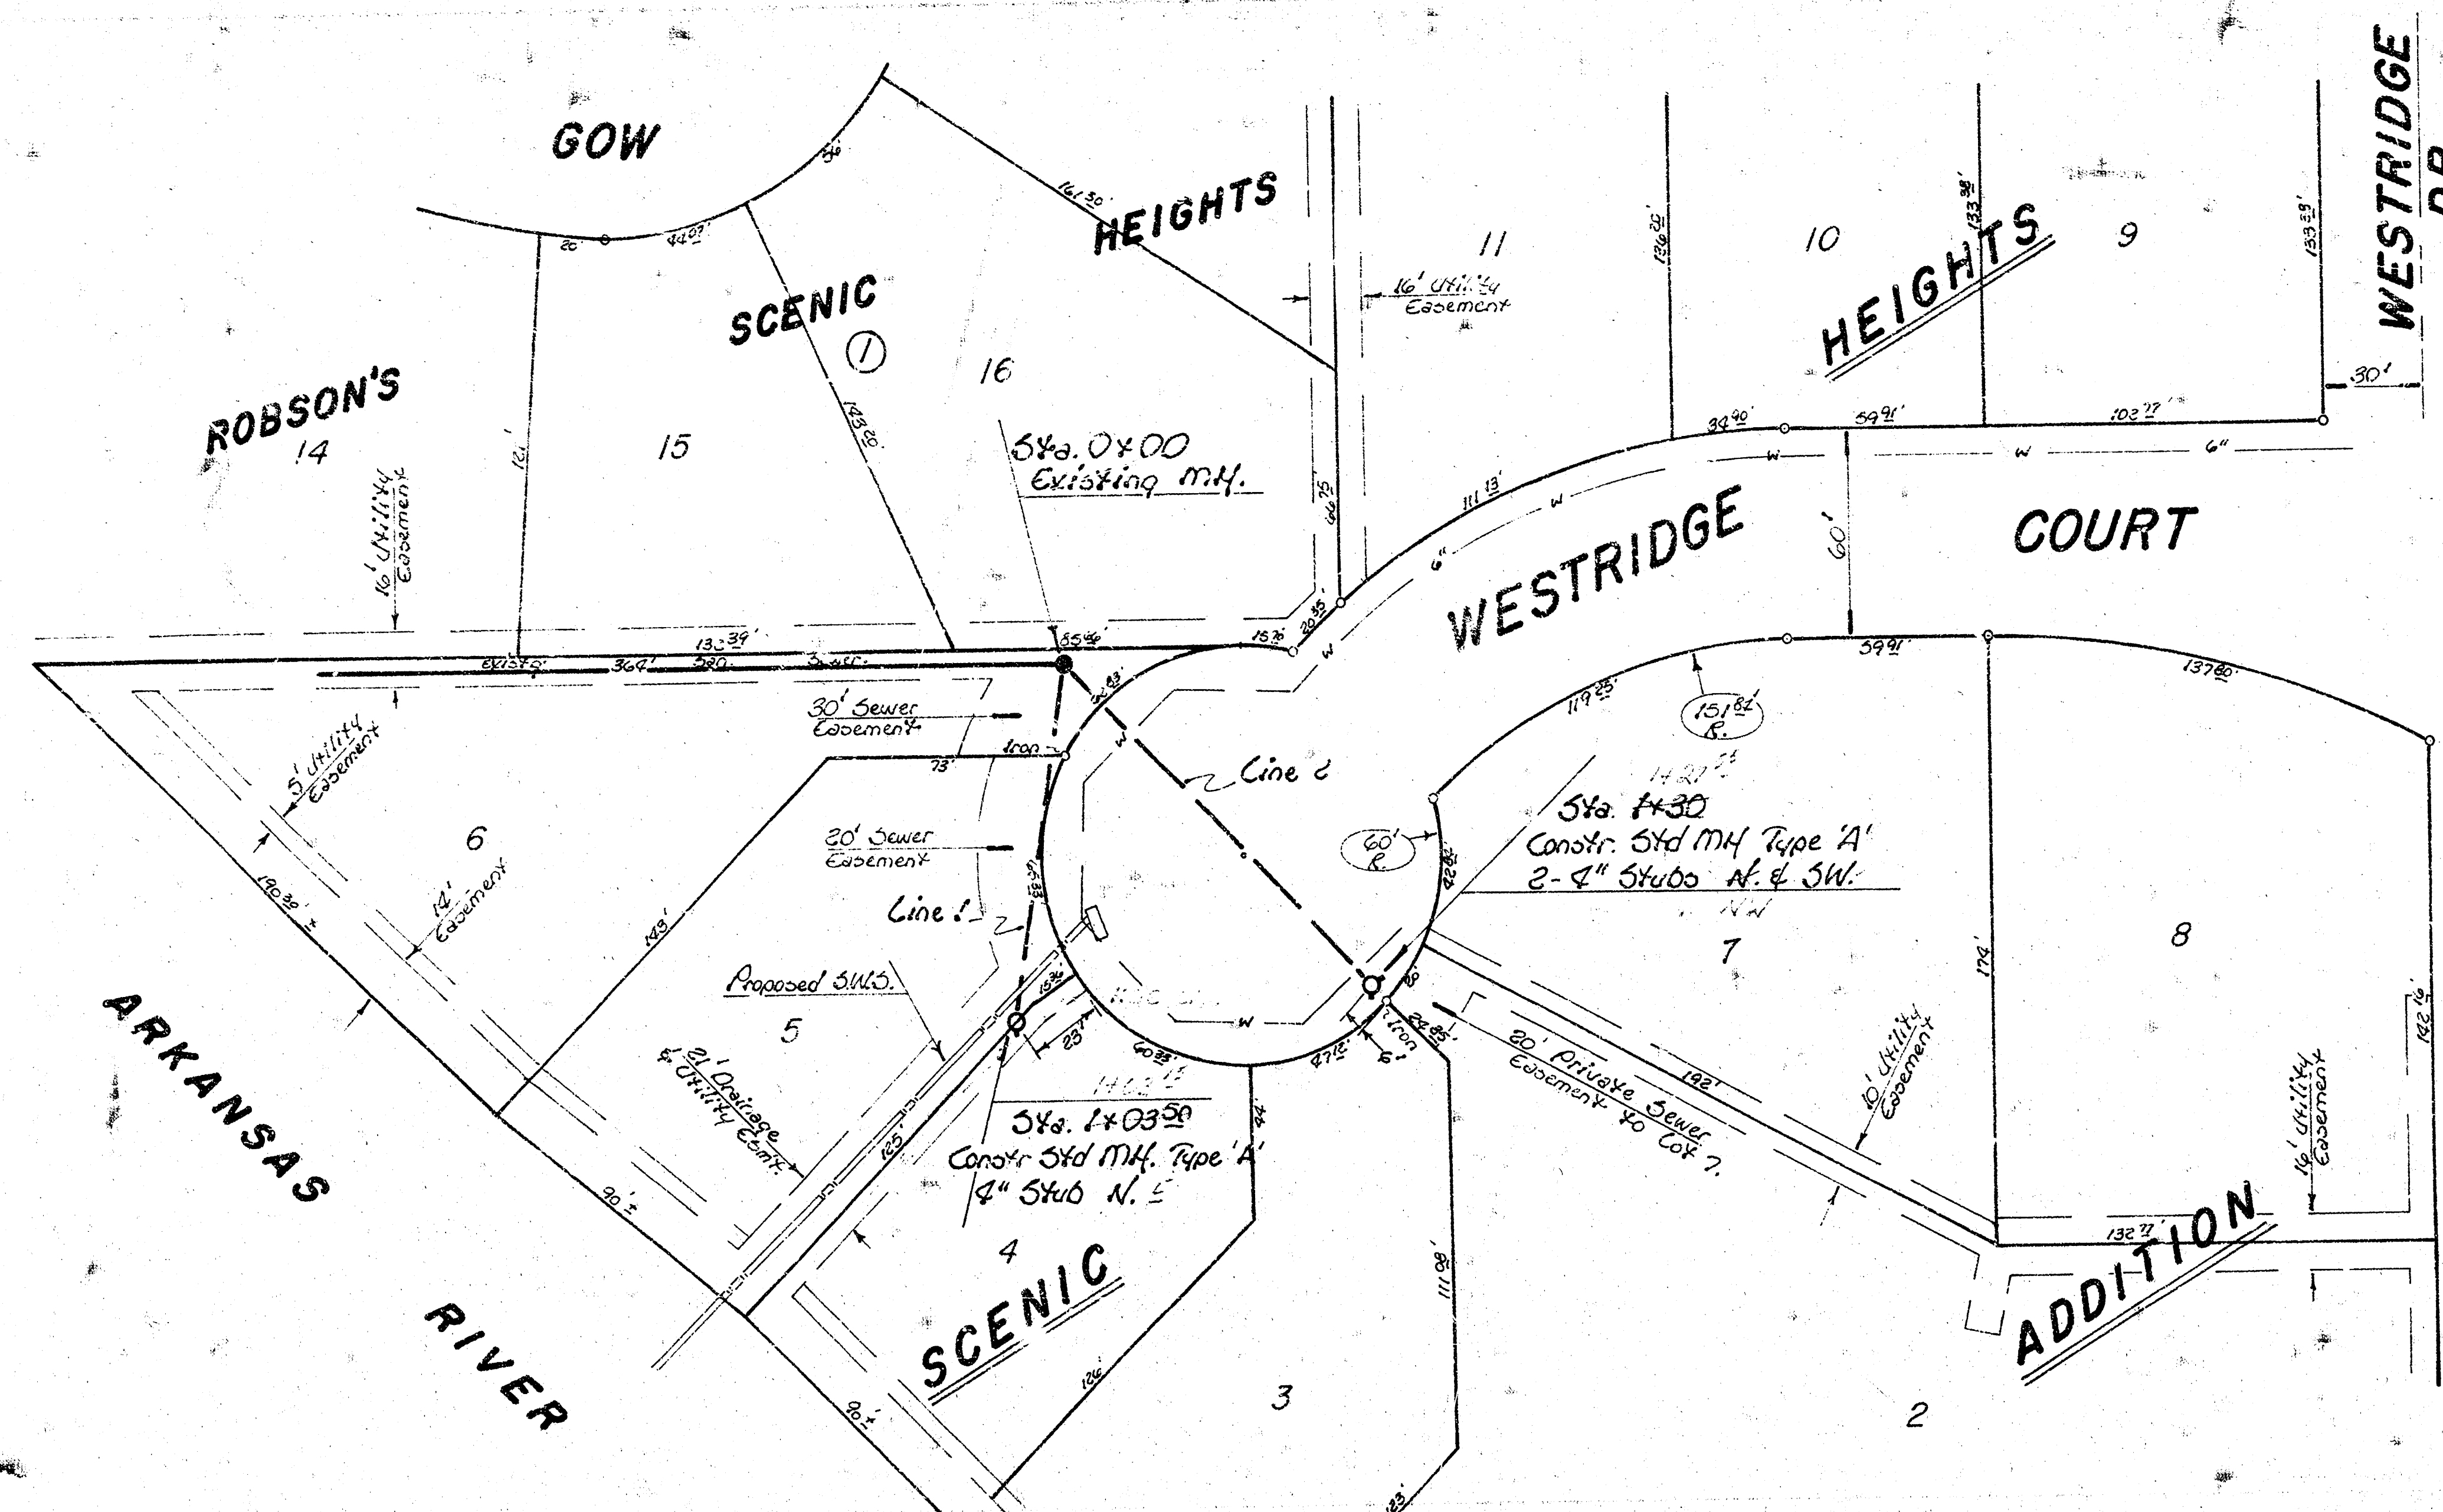


B.M. 133.91 SW Cor. Conc. Porch h/o. #1950 High.
 B.M. 132.80 SW Cor. Conc. Porch h/o. #2116 Westridge.
 B.M. 134.04 NE Cor. Conc. Porch h/o. #2103 Westridge
 at intersection of Westridge & Westridge Ct.

Scale
 Plan: 1" = 30'
 Profile: 1" = 10' Hor.
 1" = 5' Vert.

Note:

Take Ties & Replace any "irons" moved or destroyed during Construction.
 Note location of KGE Line in vicinity of MH Construction.

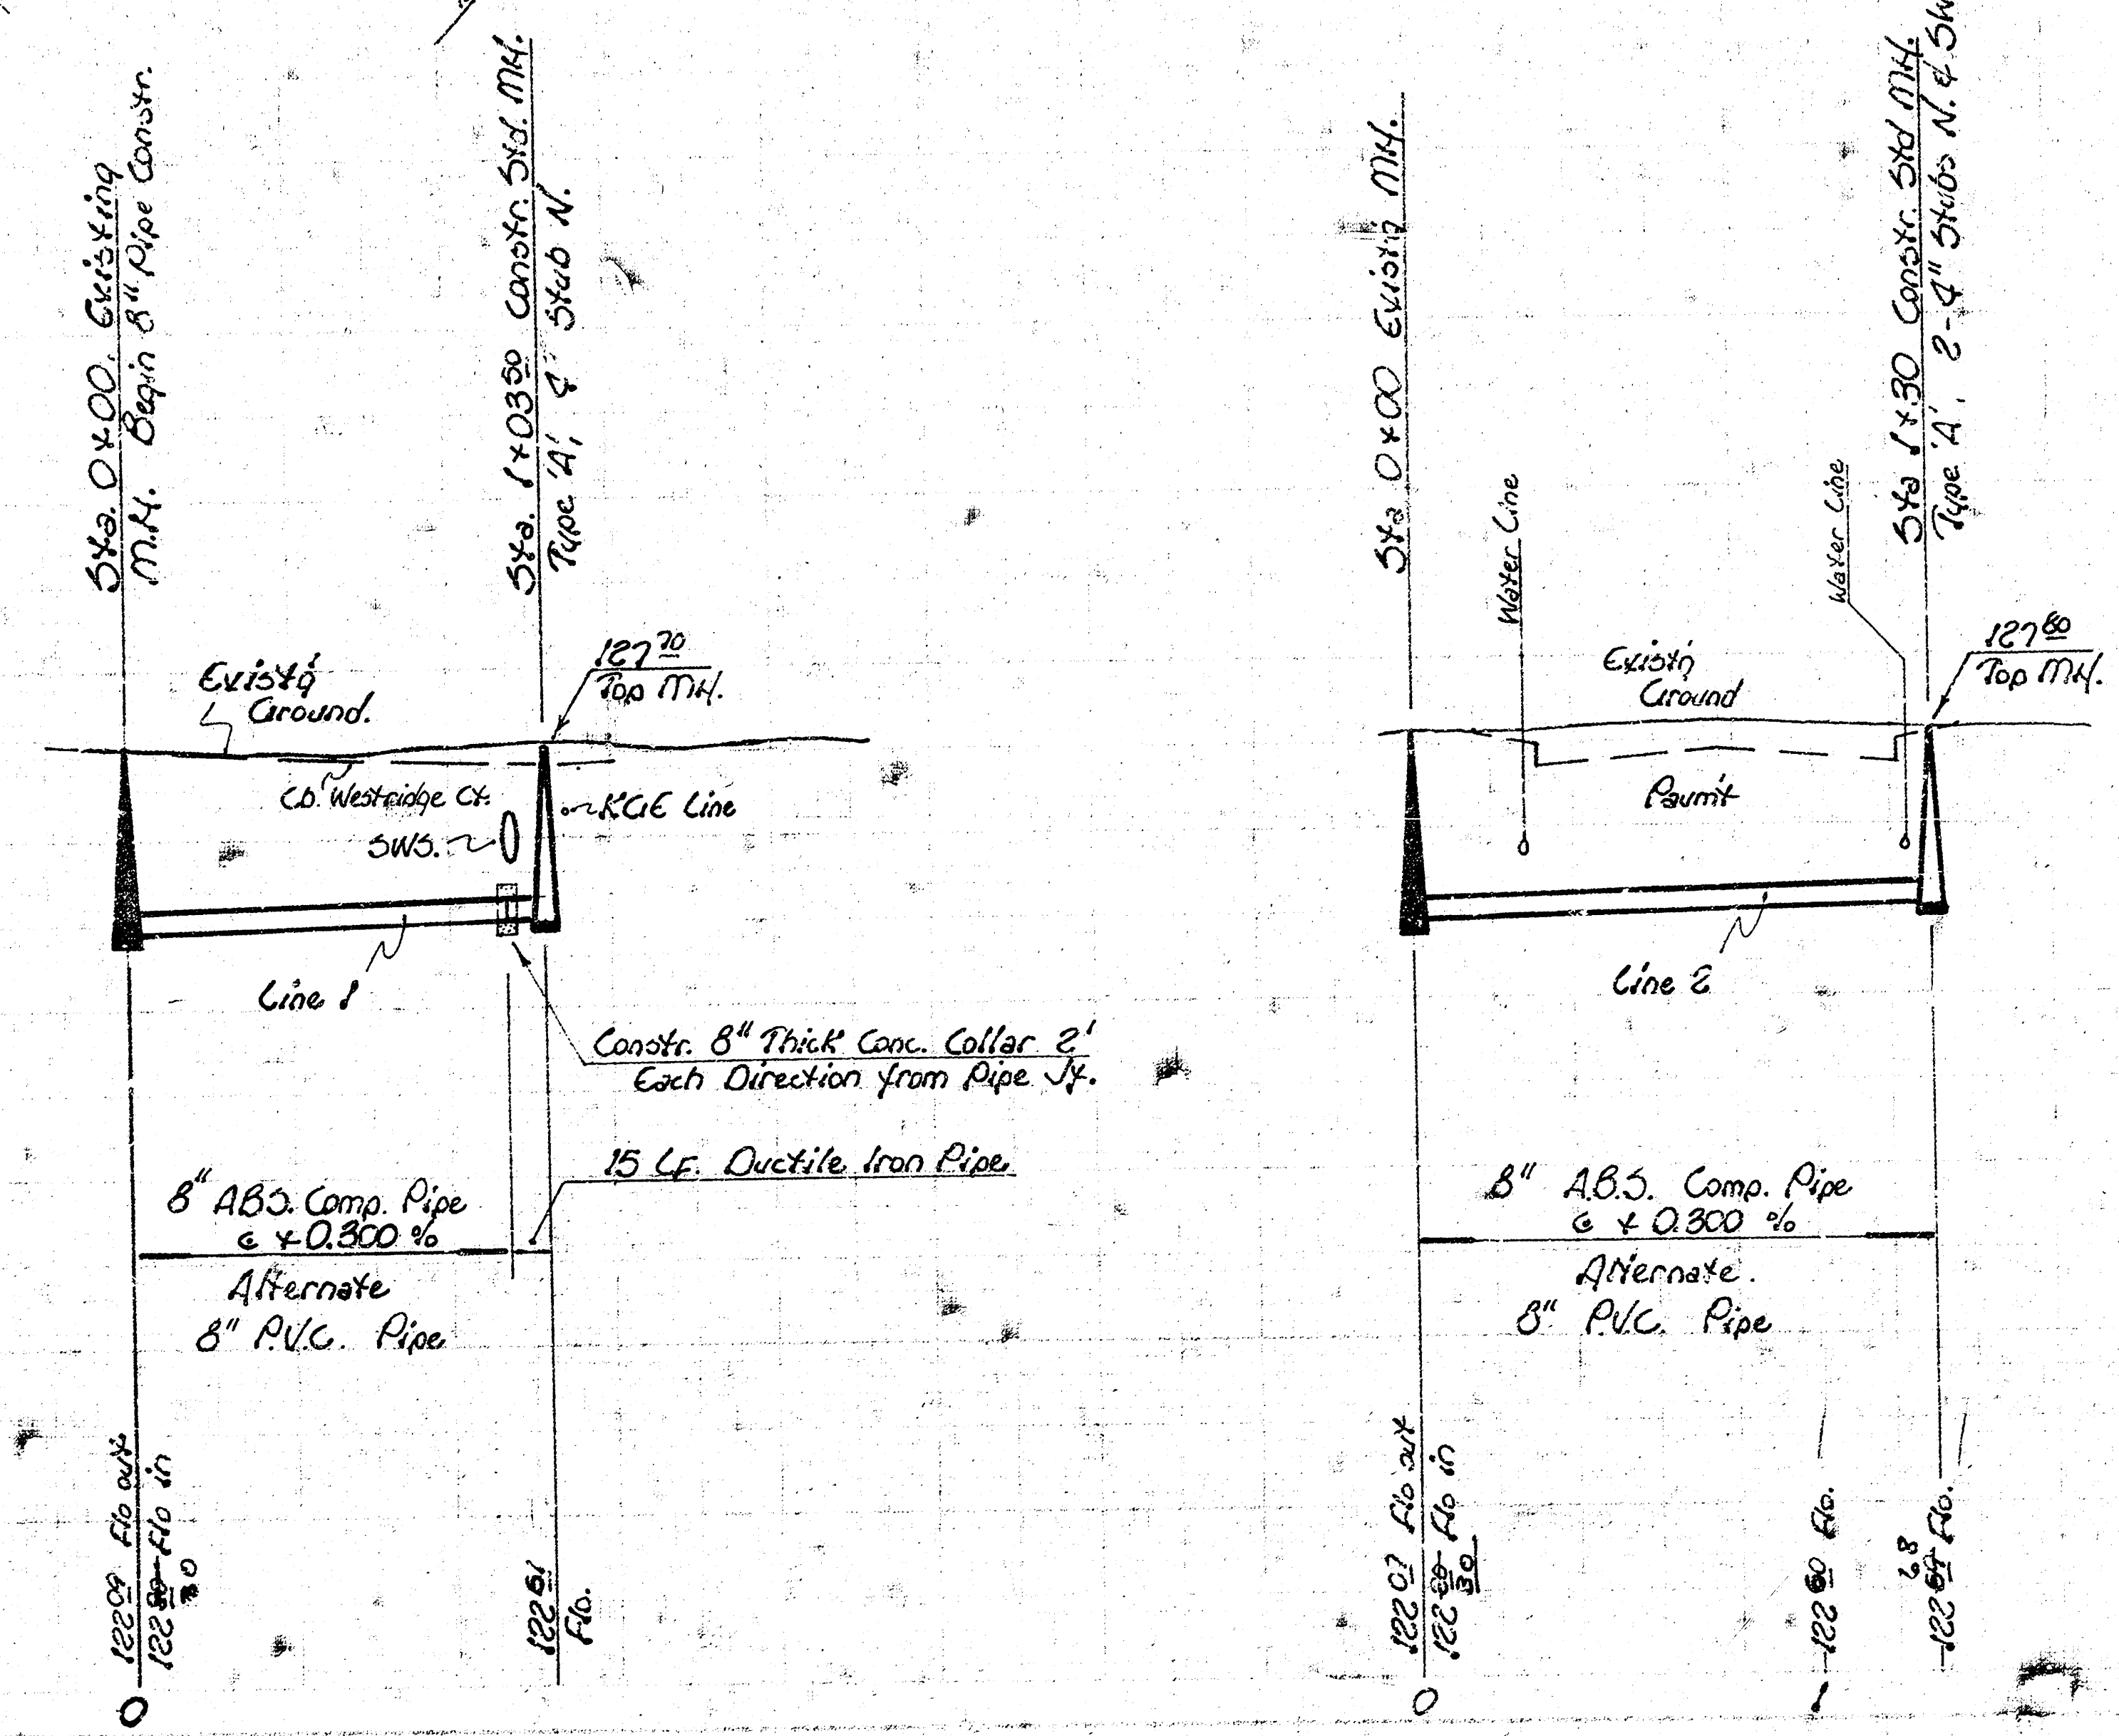

LAT. 35, MAIN 10, S.S. 22
CITY OF WICHITA, KS.
 R. W. Linn _____ City Engineer
 Project No. _____
 468-76-245-80698-000-000-001
 Date _____

14 10 1 8