B.M. 130.45 "□" cut in top of West curb at South Line of 19th Street North.

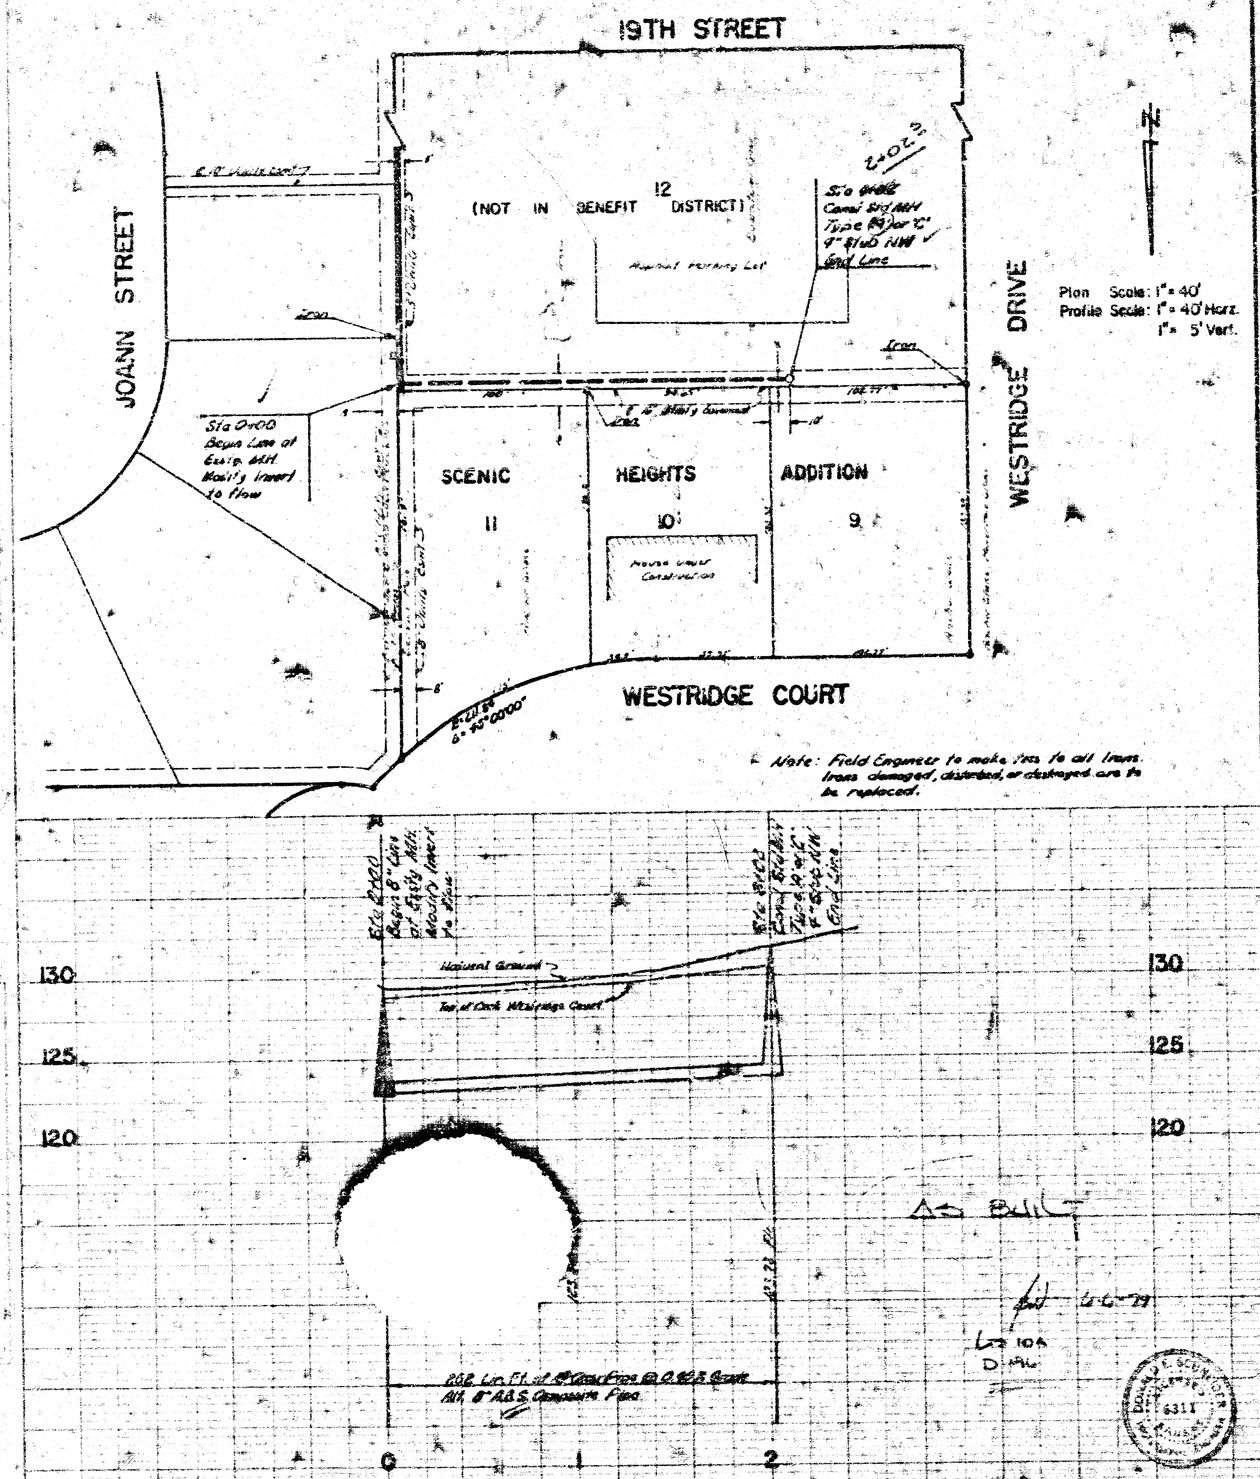

As Built

LAT 36, MAIN 10, SANITARY SEWER NO. 22
CITY OF WICHITA, KANSAS
R. W. L[illegible] — CITY ENGINEER
DATE:_____ PROJ. NO. 46876-245-80699-000-000-00[illegible]

14 - 8 - 2 - 18