

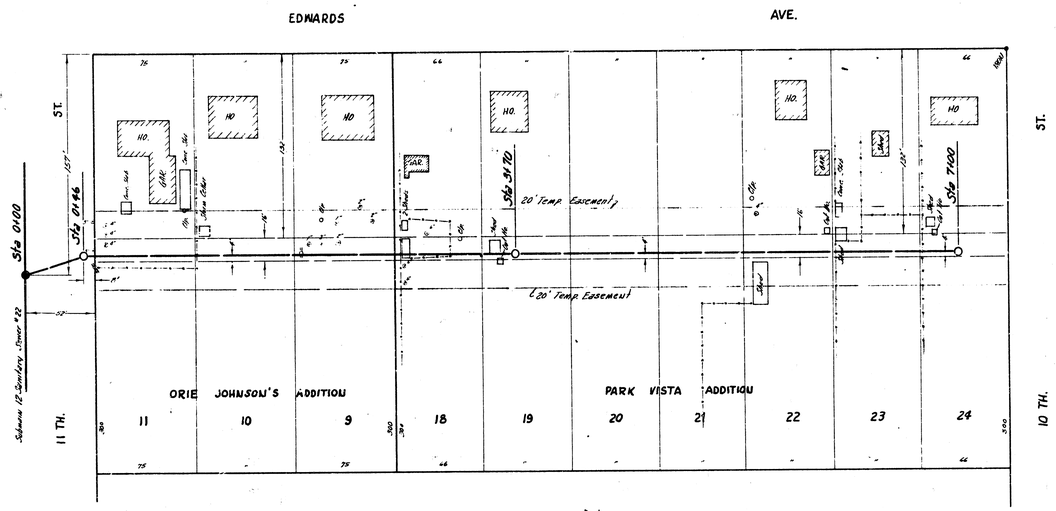


B.M. 113.35 SO. RIM M.H. 157' N. & W.L. EDWARDS ON THE W.L. 11TH.

PLAN SCALE 1"= 40'
PROFILE SCALE 1"=40' HOR, 1"=4' VERT.

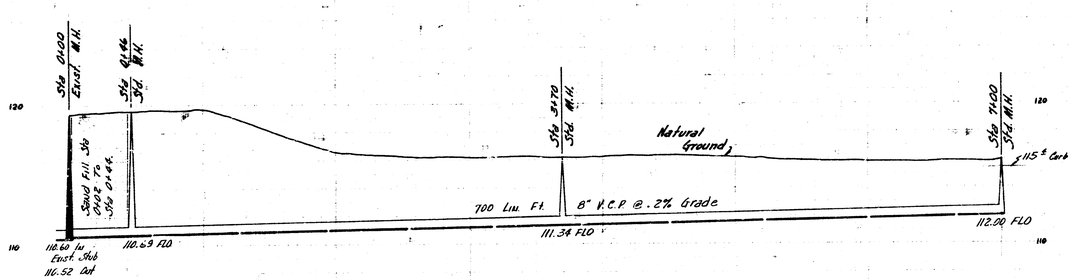

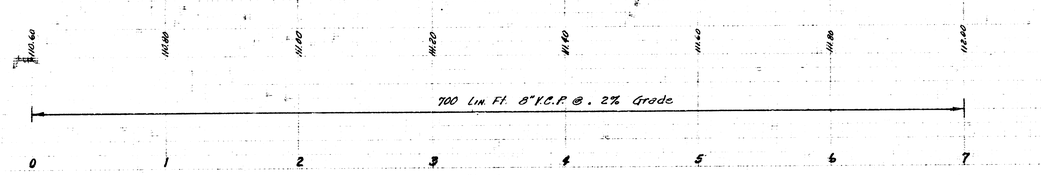

LAT. 4 SUB. 12 SAN. SEWER 22
CITY OF WICHITA, KANSAS
B.E. SMITH CITY ENGINEER
PROJ. NO C26-45 DATE- DEC. 1956