SURVEY BY KRUGER
DRAWN BY CAD
CHECKED BY
DATE

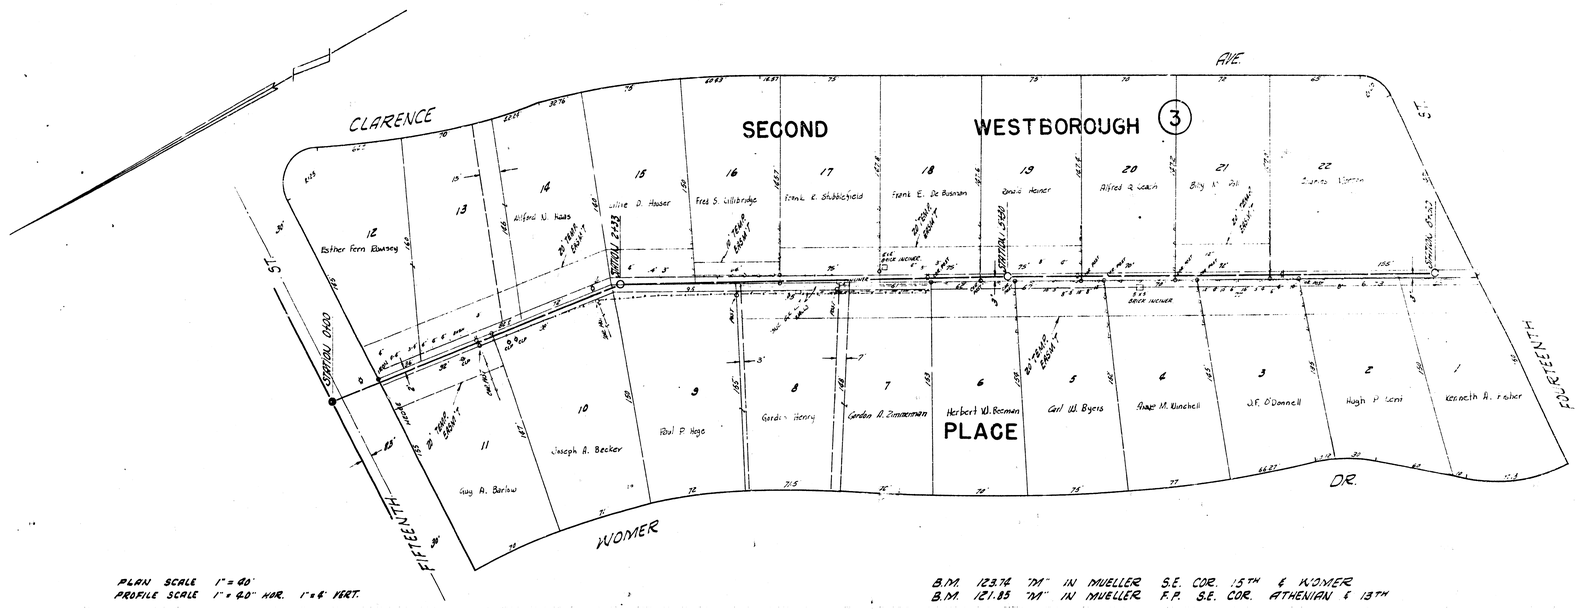

PLAN SCALE 1" = 40'
PROFILE SCALE 1" = 40' HOR. 1" = 6' VERT.

B.M. 123.74 "M" IN MUELLER S.E. COR. 15TH & WOMER
B.M. 121.85 "M" IN MUELLER F.P. S.E. COR. ATHENIAN & 13TH

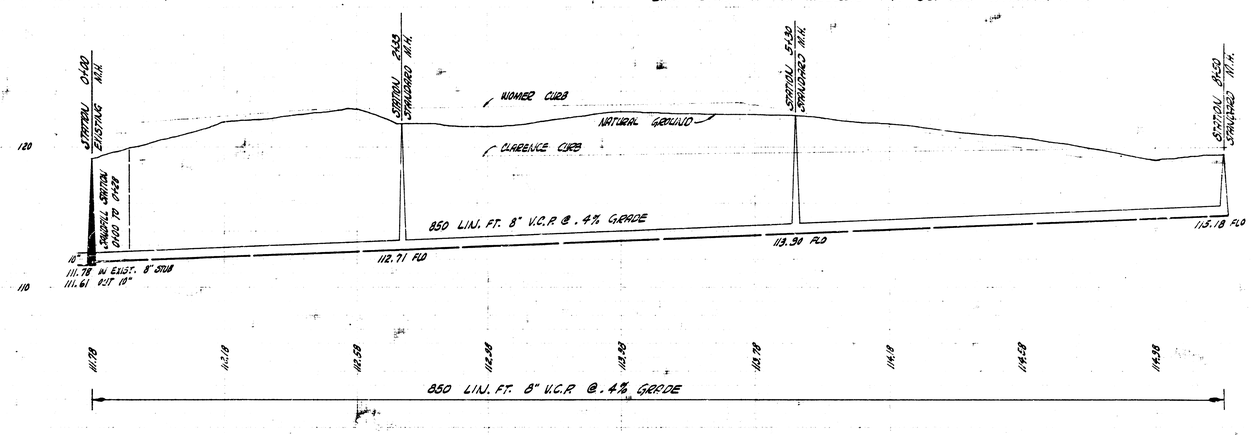

8

LATERAL 12 SUB 13 S.S.22
CITY OF WICHITA, KANSAS
B. E. SMITH, CITY ENGINEER
PROJ. NO. C27-40 SEPT. 1953

0 1 2 3 4 5 6 7