2.28 "□" Chisel mark in Northeast corner of concrete sidewalk at South enterance to Plastics Fab. Co. Inc. at 1650 McComas.

12.23 "□" Chisel mark in top of curb at West end of return on the Southwest corner of the intersection of Dora Ave. and Kessler Ave.

09.43 Top of bolt in the Southwest corner of the sign base at 3600 West Esthner Ave. in front of Construction Machinery Inc. building.

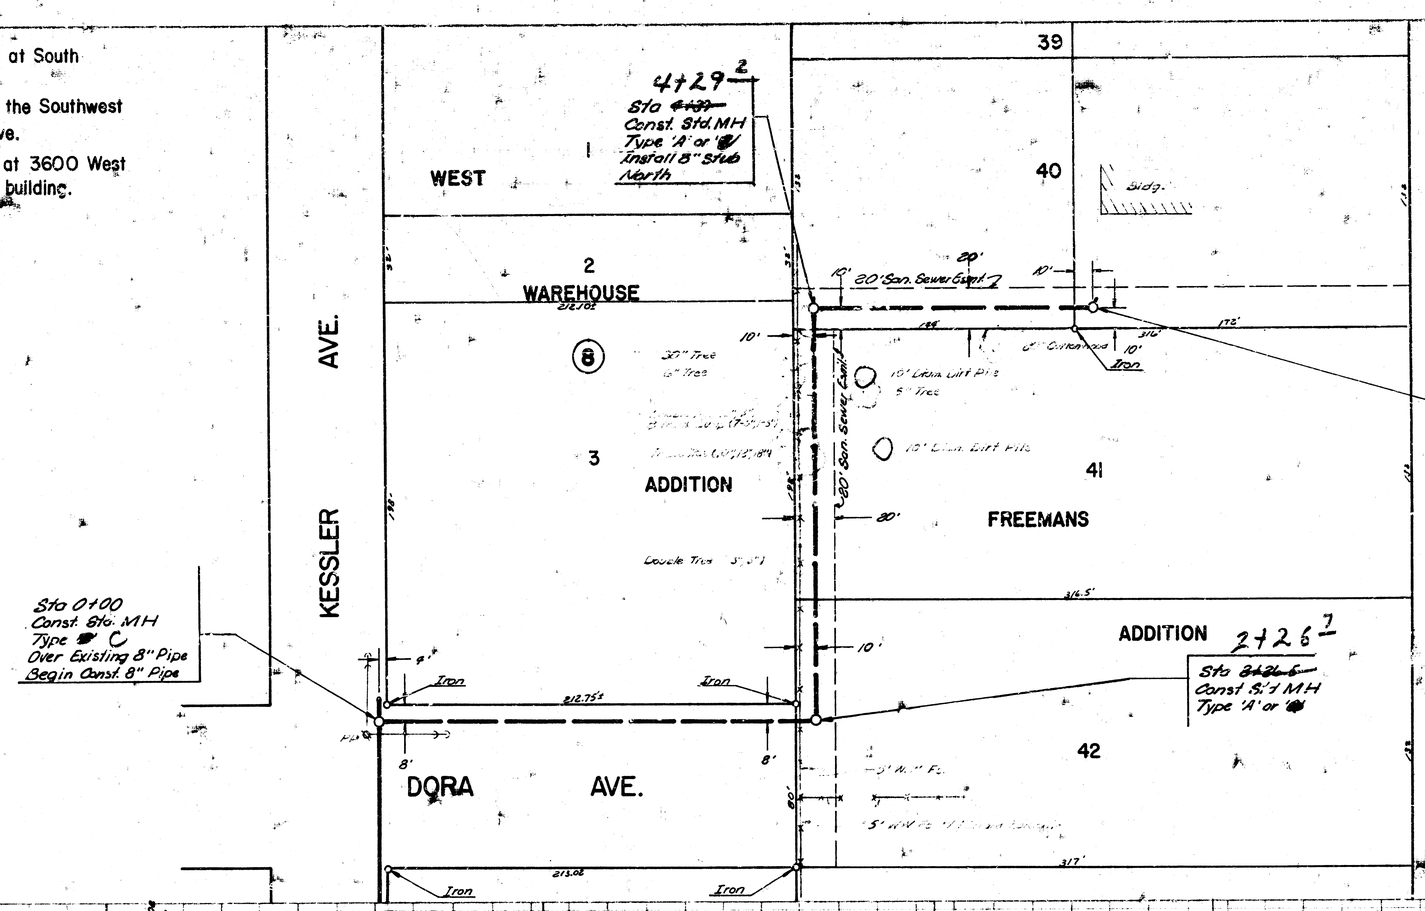

Plan Scale: 1" = 40'
Profile Scale: 1" = 40' Horz.
1" = 5' Vert.

 

As Built 6-28-78

LAT 7	MAIN 14	S.S. 22

CITY OF WICHITA, KANSAS

R.W. LINN — CITY ENGINEER

DATE: _____ PROJECT NUMBER: DRKL 577097