



Survey by Henry B. Smith
 11-20-91
 11-20-91

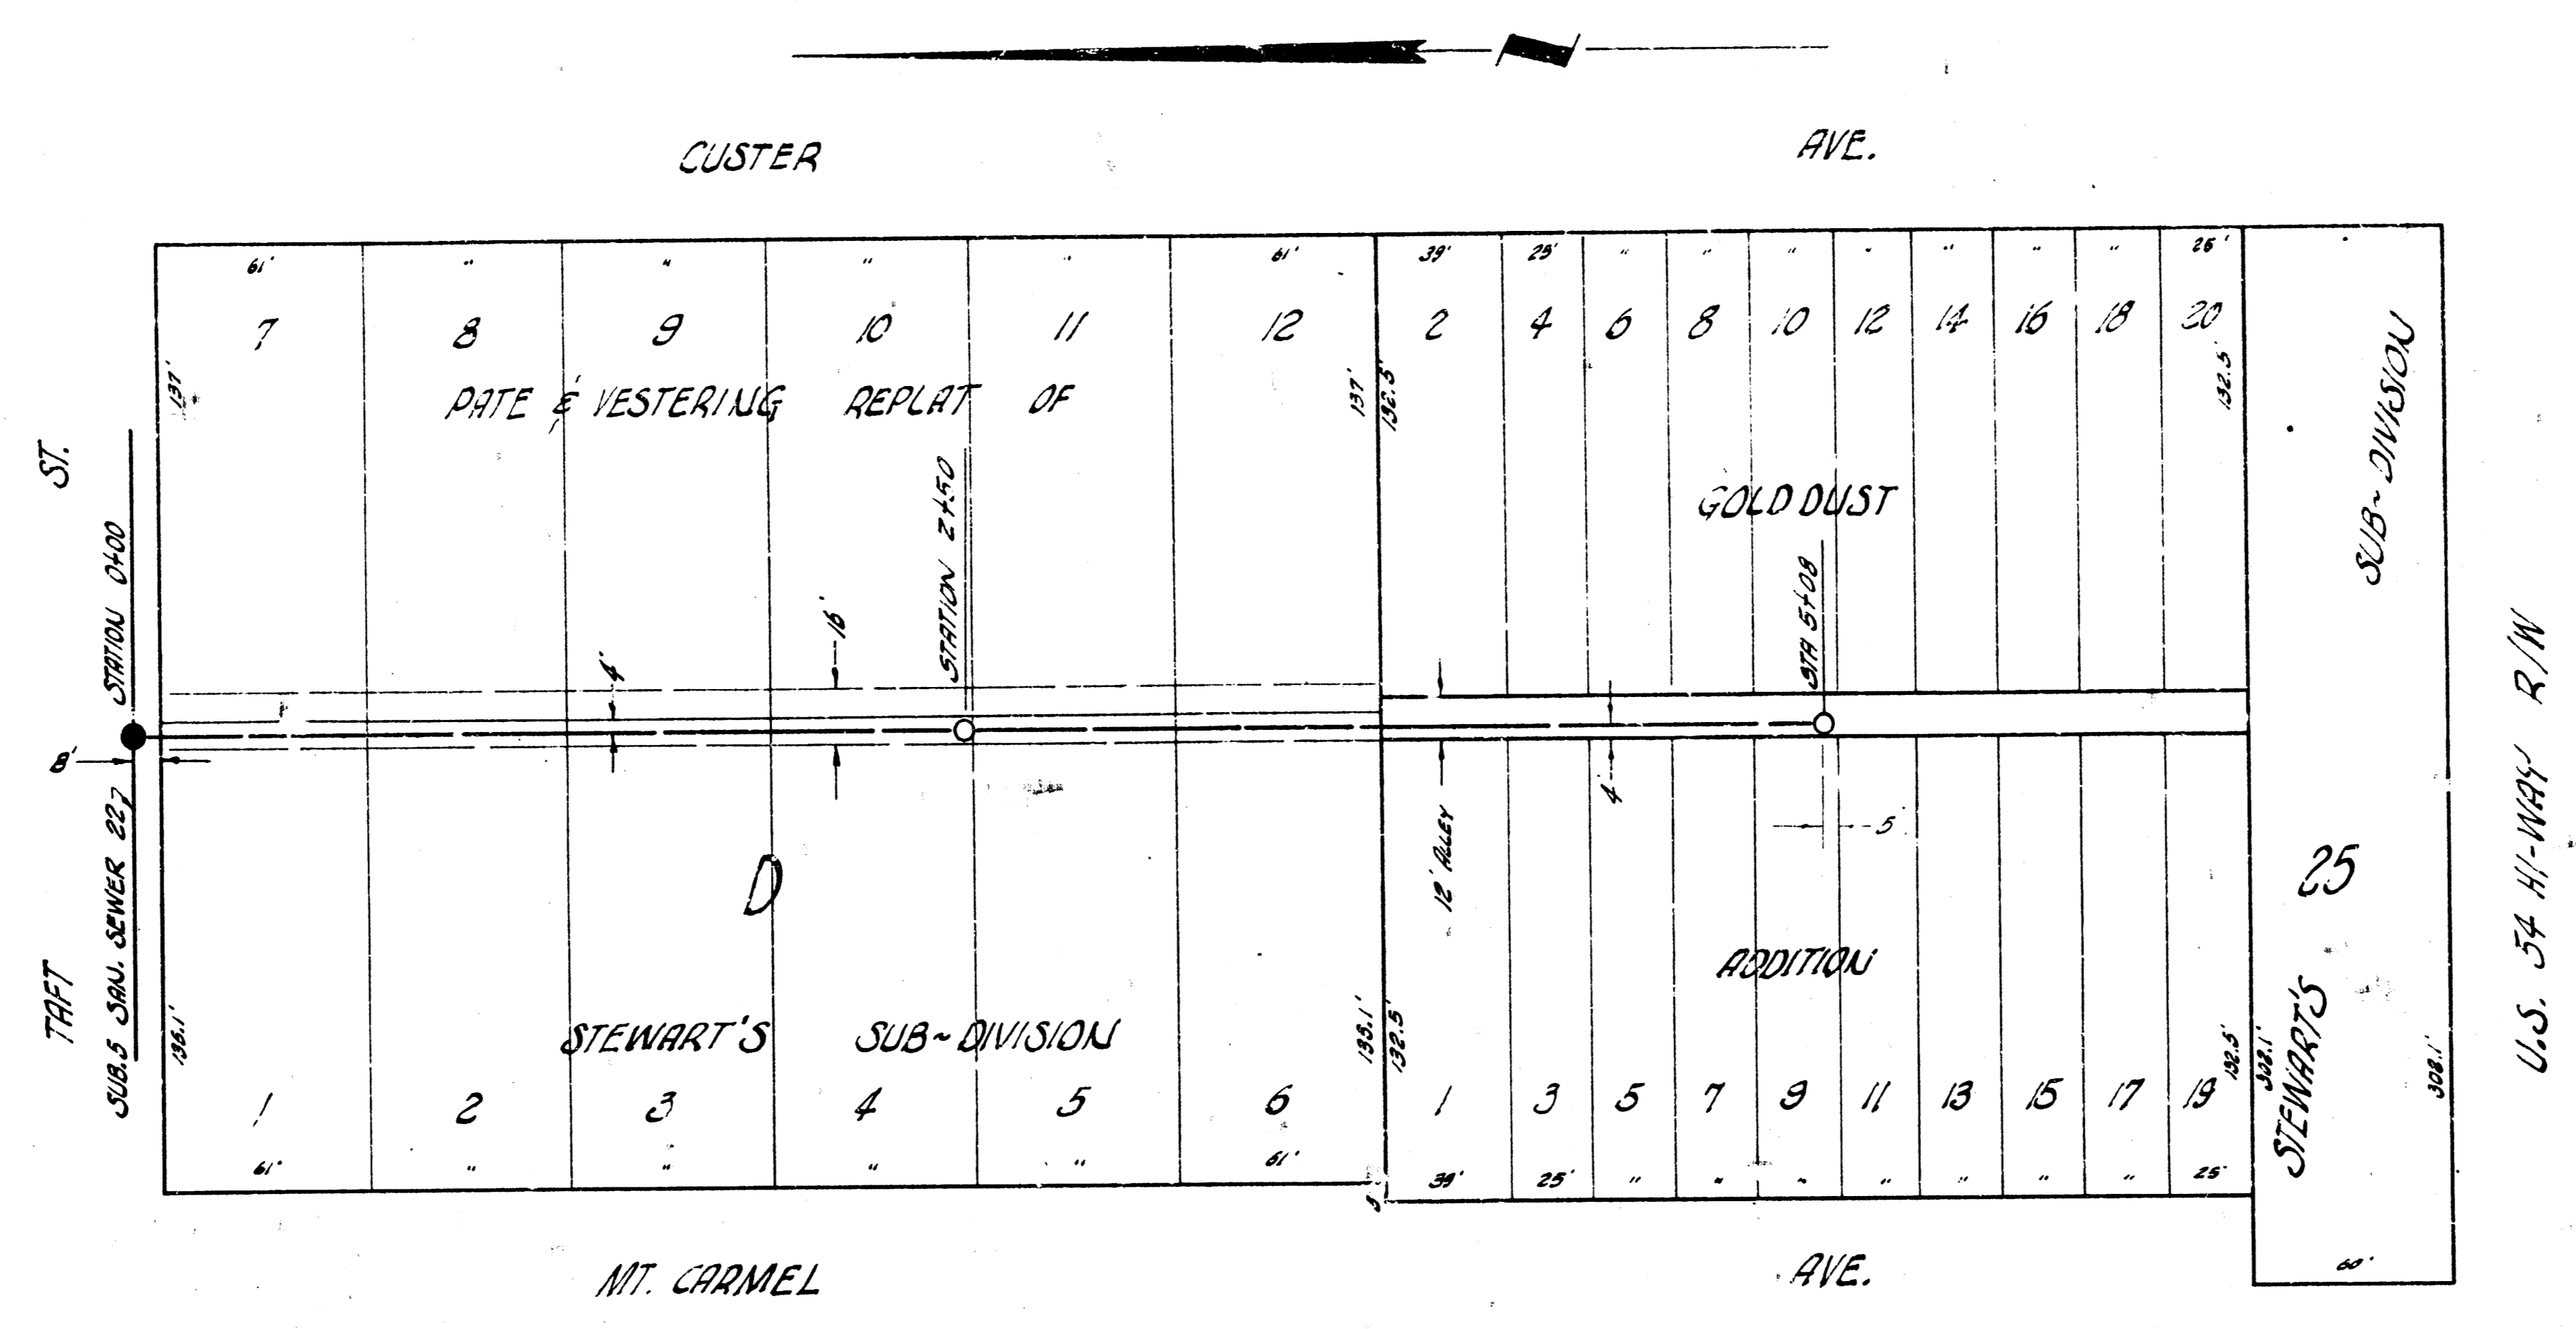

B.M. 112.86 SPIKE E. SIDE P. POLE SW COR SHERIDAN & UNIVERSITY (WEST)

PLAN SCALE 1"=40'
 PROFILE SCALE 1"=40' HOR., 1"=4' VERT.

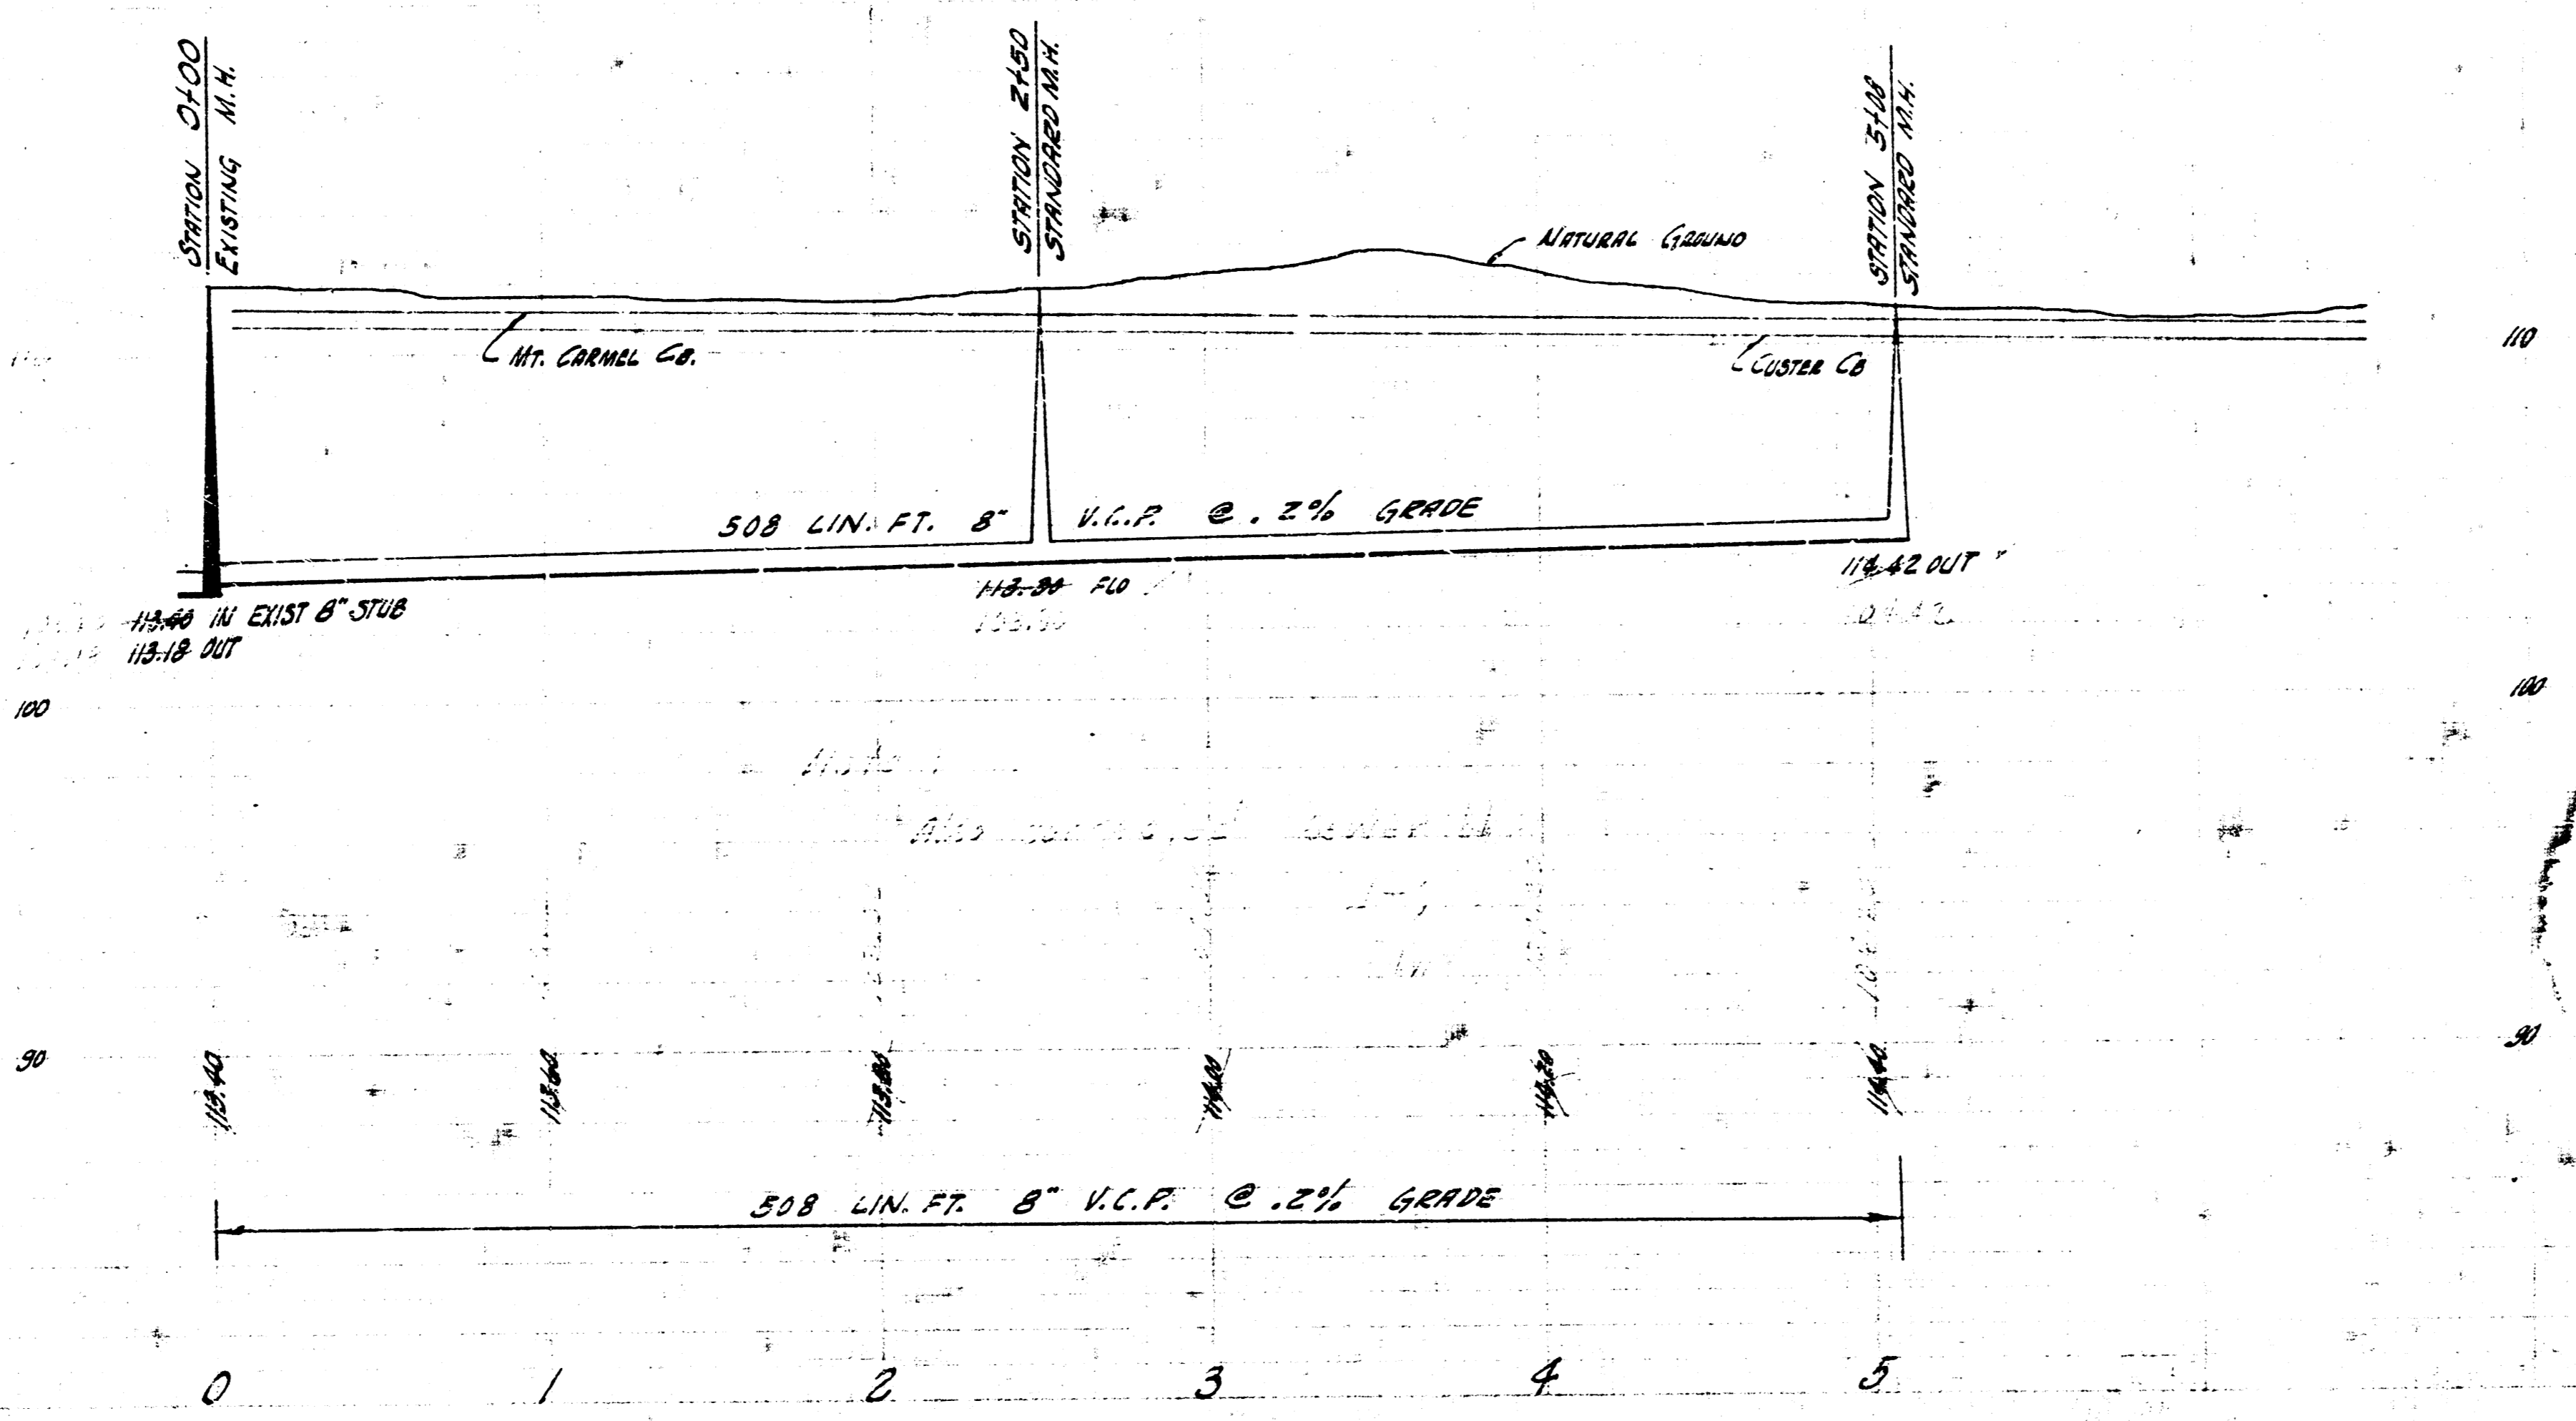

LAT. 4 SUB. 15 SAN. SEWER 22
 CITY OF WICHITA, KANSAS
 B.E. SMITH CITY ENGINEER
 PROJ. NO. C27-91 - DATE-