BM 101.63 R.R. Spike N. Face P.P. S. Side Pawnee 25'E of El Edwards.

SOUTHWEST INDUSTRIAL ADDN.

3

7 8 9 10 11 12

0-07.2
Sta 0+00
Const. Std MH Type "A"
Over Existing 8" Line

2+97.2
Sta 3+00
Const. Std. M.H.
Type "A"

5+97.2
Sta 6+00
Const. Std M.H.
Type "A"

8+97.2
Sta 9+00
Const. Std. M.H.
Type "A"

Builders Inc.
200 W. Douglas

13.2'
45°
4'
20'
200'
10'
100'
140'
102.6
100.95
-.14 %
Sta 11+00

AVE.
EDWARDS
AVE.
PAWNEE
LYDIA
AVE.

NOTE: ALL EXCESS MATERIAL EXCAVATED FROM TRENCH FOR SEWER SHALL BE SPREAD OVER THE SEWER TO PROVIDE ADDITIONAL COVER.

NOTE: MINIMUM COVER OF 2.5' TO BE MAINTAINED THROUGHOUT PROJECT.

Plan Scale 1"=40'
Profile Scale 1"=4' Horiz.
1"=5' Vert.

Sta 0+00 MH Type "A" Const Std Over Existing 8" Line

Sta 3+00 Const Std M.H. Type "A"

Sta 6+00 Const Std M.H. Type "A"

Sta 9+00 Const Std M.H. Type "A"

Set Top of M.H. @ 101.35

Set Top of MH @ 101.62

Proposed W. Co. Edwards Ave.

Set Top of M.H. @ 101.86

Set Top of M.H. @ 101.88

100

90

Rec Out Existing Line 96.68±
Rec In New Line 96.80

97.00 97.20 97.40 97.60 97.80 98.00 98.20 98.40 98.60 98.80 99.00

1100 Lin. Ft. of 8" Clay Pipe @ 0.10 % Grade

0 1 2 3 4 5 6 7 8 9 10 11

"As Built" Final Measm. 55"/2 J.K.

LARRY W. LAURSEN LICENSED 5363 KANSAS PROFESSIONAL ENGINEER


DEAN S. SALYERS LICENSED 3683 KANSAS PROFESSIONAL ENGINEER

LAT 5. MAIN 16, S.S. No. 22
City of Wichita, Kansas
R.W. Linn — City Engineer
Date: JAN. 1973 Sheet 1 of 3
Project No. DBKL 5720 55


1/3

16 sets — Engr.
" " — Water


BM 102.07 City Standard 42° S. & 52½ E. of ℄ Principle & Meridian

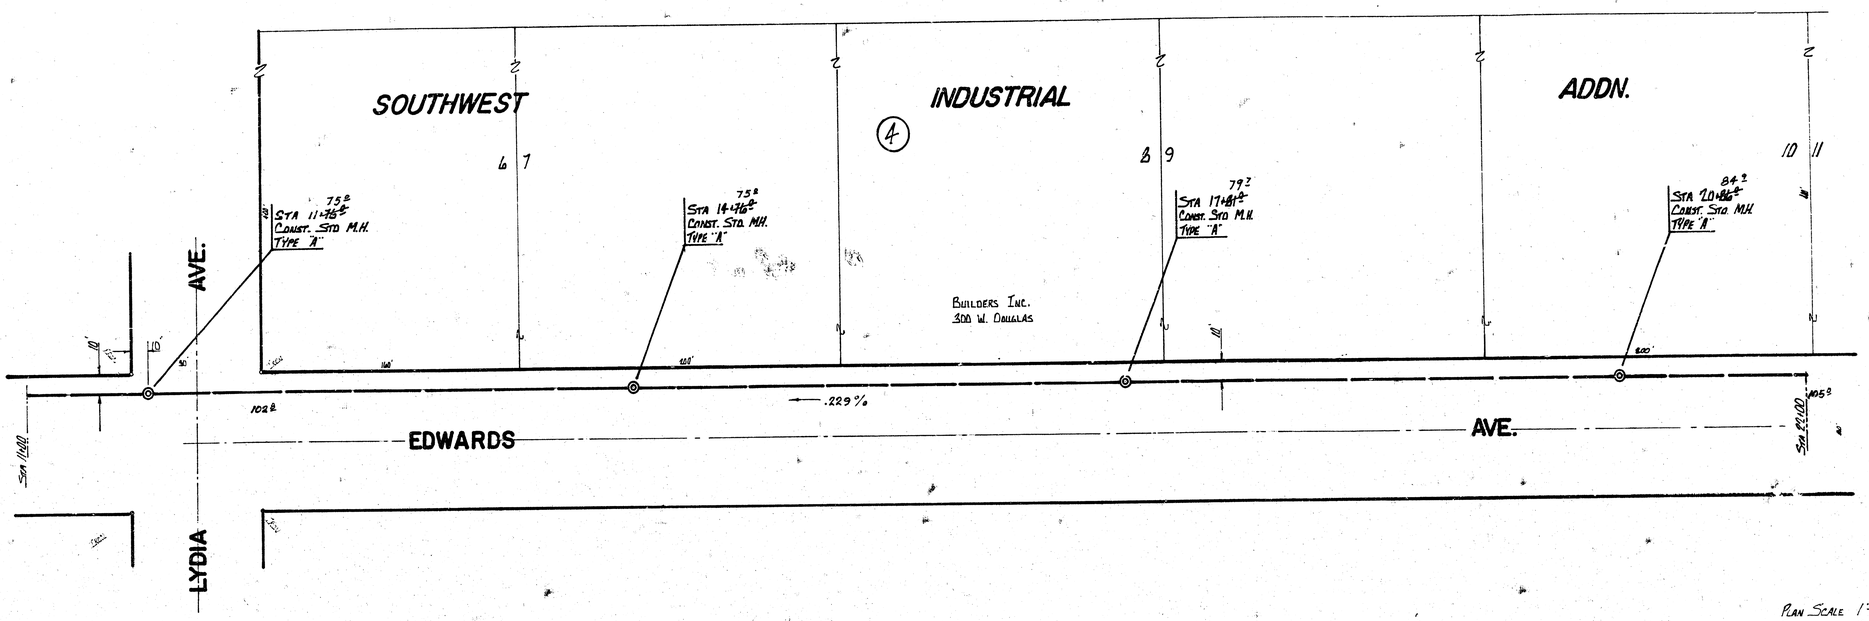

Plan Scale 1"=40'
Profile Scale 1"=40' Horiz.
1"=5' Vert.

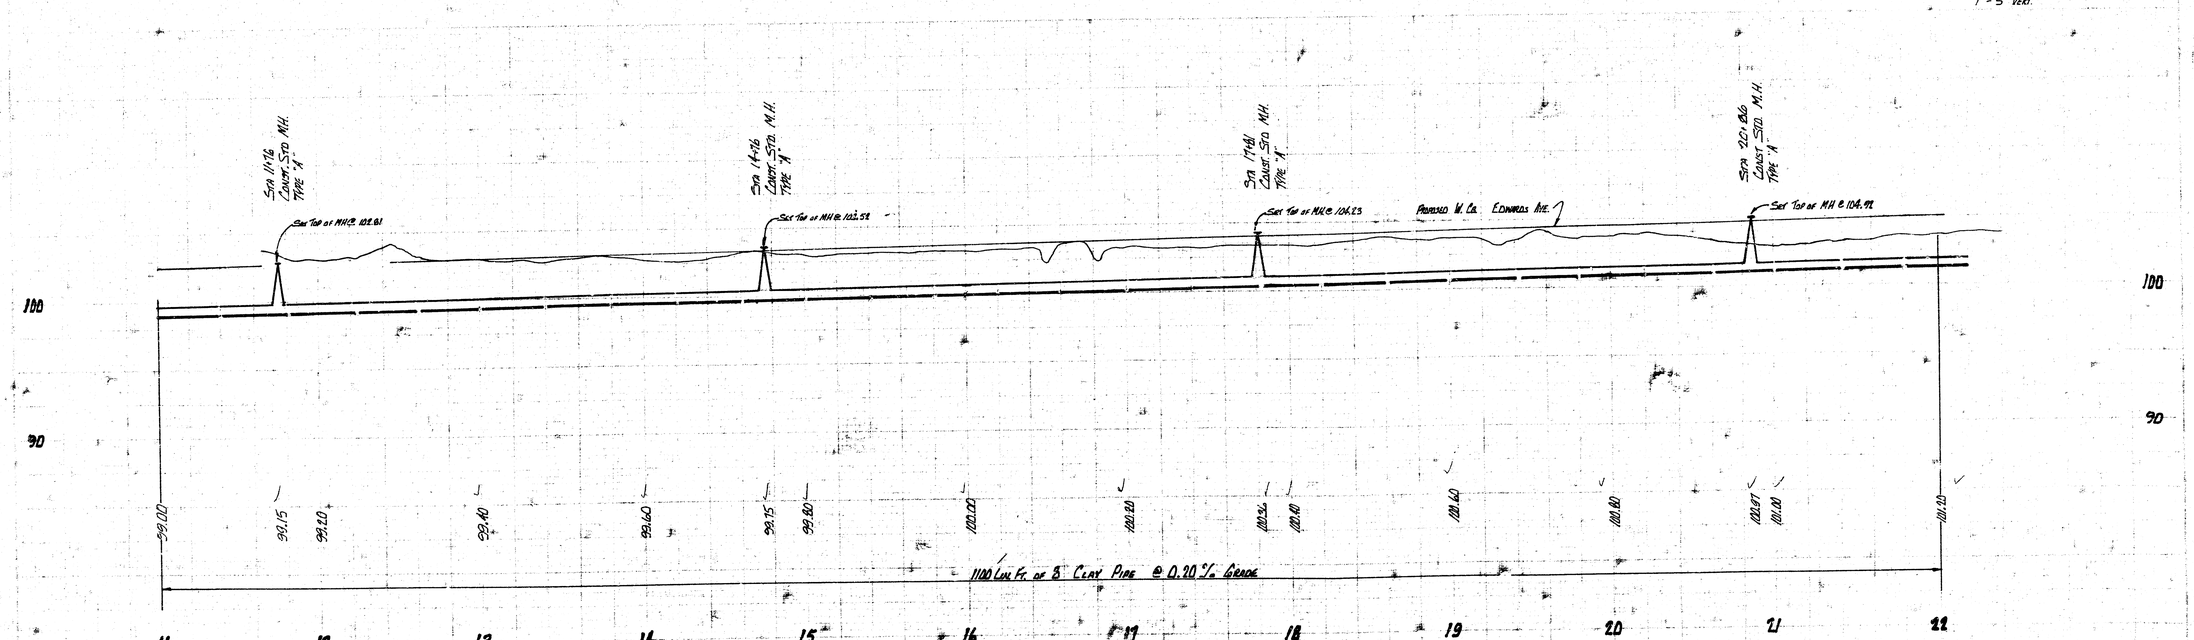


Lat 5, Main 16, S.S. No 22
Project No DBK1572055
Sheet 2 of 3

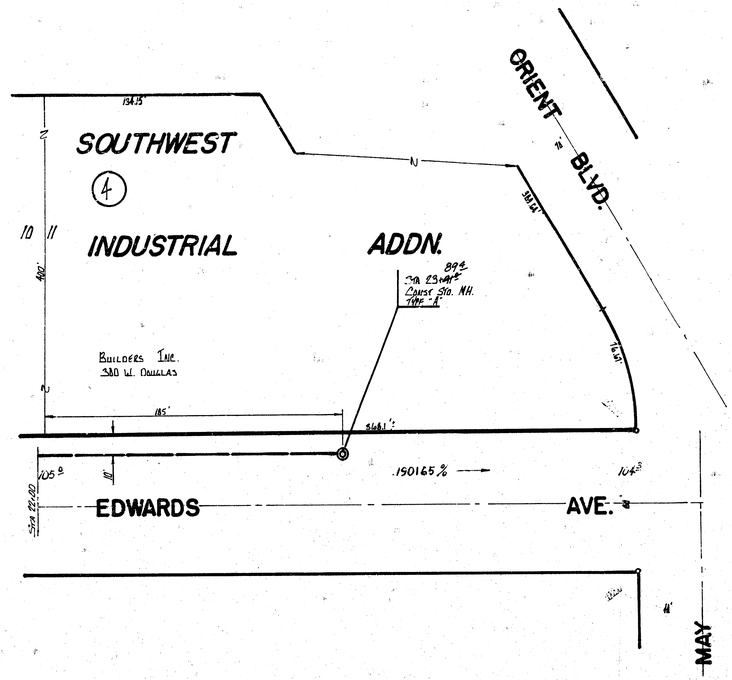

N

BM 105.15 R.R. SPIKE S-SIDE H.P. S-SIDE MAY 125'± E OF EL EDWARDS

PLAN SCALE 1"=40'
PROFILE SCALE 1"=40' HORIZ.
1"=5' VERT.

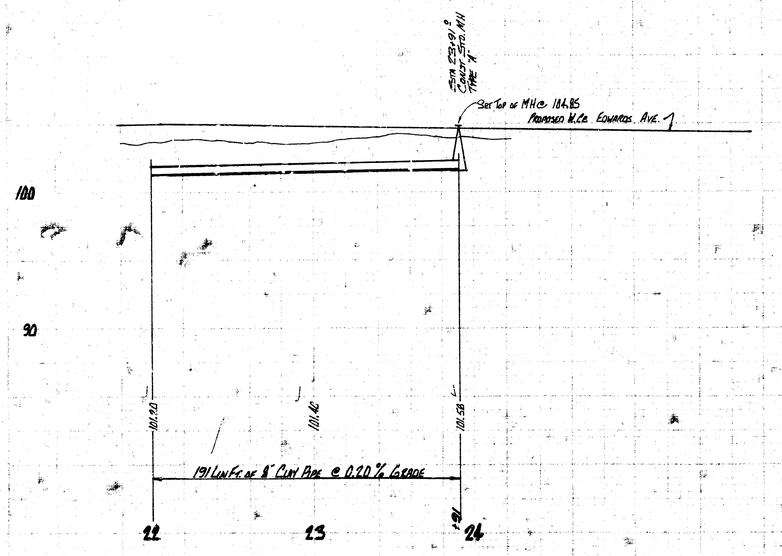

LAT 5, MAIN 16, S.S. NO. 22
PROJECT NO. DBKLS72055
SHEET 3 OF 3

3/13

13