BM 101.63 R.R. Spike N. Face P.P. S. Side Pawnee 25'E of El Edwards.

SOUTHWEST INDUSTRIAL ADDN.

7 8 9 10 11 12

3

Builders Inc.
203 W. Douglas

0-07 ℄
Sta 0+00
Const. Std. MH Type 'A'
Over Existing 8" Line

2+97 ℄
Sta 2+00
Const. Std. M.H.
Type 'A'

5+97 ℄
Sta 5+00
Const. Std. M.H.
Type 'A'

8+97 ℄
Sta 8+00
Const. Std. MH.
Type 'A'

AVE.

132'

742.95

1145'±

102'

EDWARDS AVE.

PAWNEE

LYDIA AVE.

NOTE: ALL EXCESS MATERIAL EXCAVATED FROM TRENCH FOR SEWER SHALL BE SPREAD OVER THE SEWER TO PROVIDE ADDITIONAL COVER.

Note:
Minimum cover of 2.5' to be maintained throughout project.

Plan Scale 1"=10'
Profile Scale 1"=4' Horiz
1"=5' Vert.

Sta 0+00 MH Top of Const. Std. MH Over Existing 8" Line

Sta 2+00 Const. Std. M.H. Type 'A'

Sta 5+00 Const. Std. M.H. Type 'A'

Sta 8+00 Const. Std. M.H. Type 'A'

Set Top of M.H. @ 1099.35

Set Top of MH @ 1101.62

Proposed W. Co. Edwards Ave.

Set Top of MH @ 1098.84

Set Top of MH @ 1100.88

Exc. and Existing Line Rec. 60.5'
To be new Line 96.80'

97.20' 97.20' 97.60' 97.40' 97.80' 98.00' 98.20' 98.40' 98.60' 98.80' 99.00'

1100 Lin. Ft. of 8" Clay Pipe @ 0.20% Slope

100 90


0 1 2 3 4 5 6 7 8 9 10 11

"As Built" Final Measm. 55°12 U.K.


LAT 5, MAIN 16, S.S. No. 22
City of Wichita, Kansas
R.W. Linn — City Engineer
Date: JAN. 1973 Sheet 1 of 3
Project No. OBKL 5720 55


Harry W. Laudeen
Licensed
Kansas
Registered Engineer
8303

Olen S. Lacy
Licensed
Kansas
Registered Engineer
5961

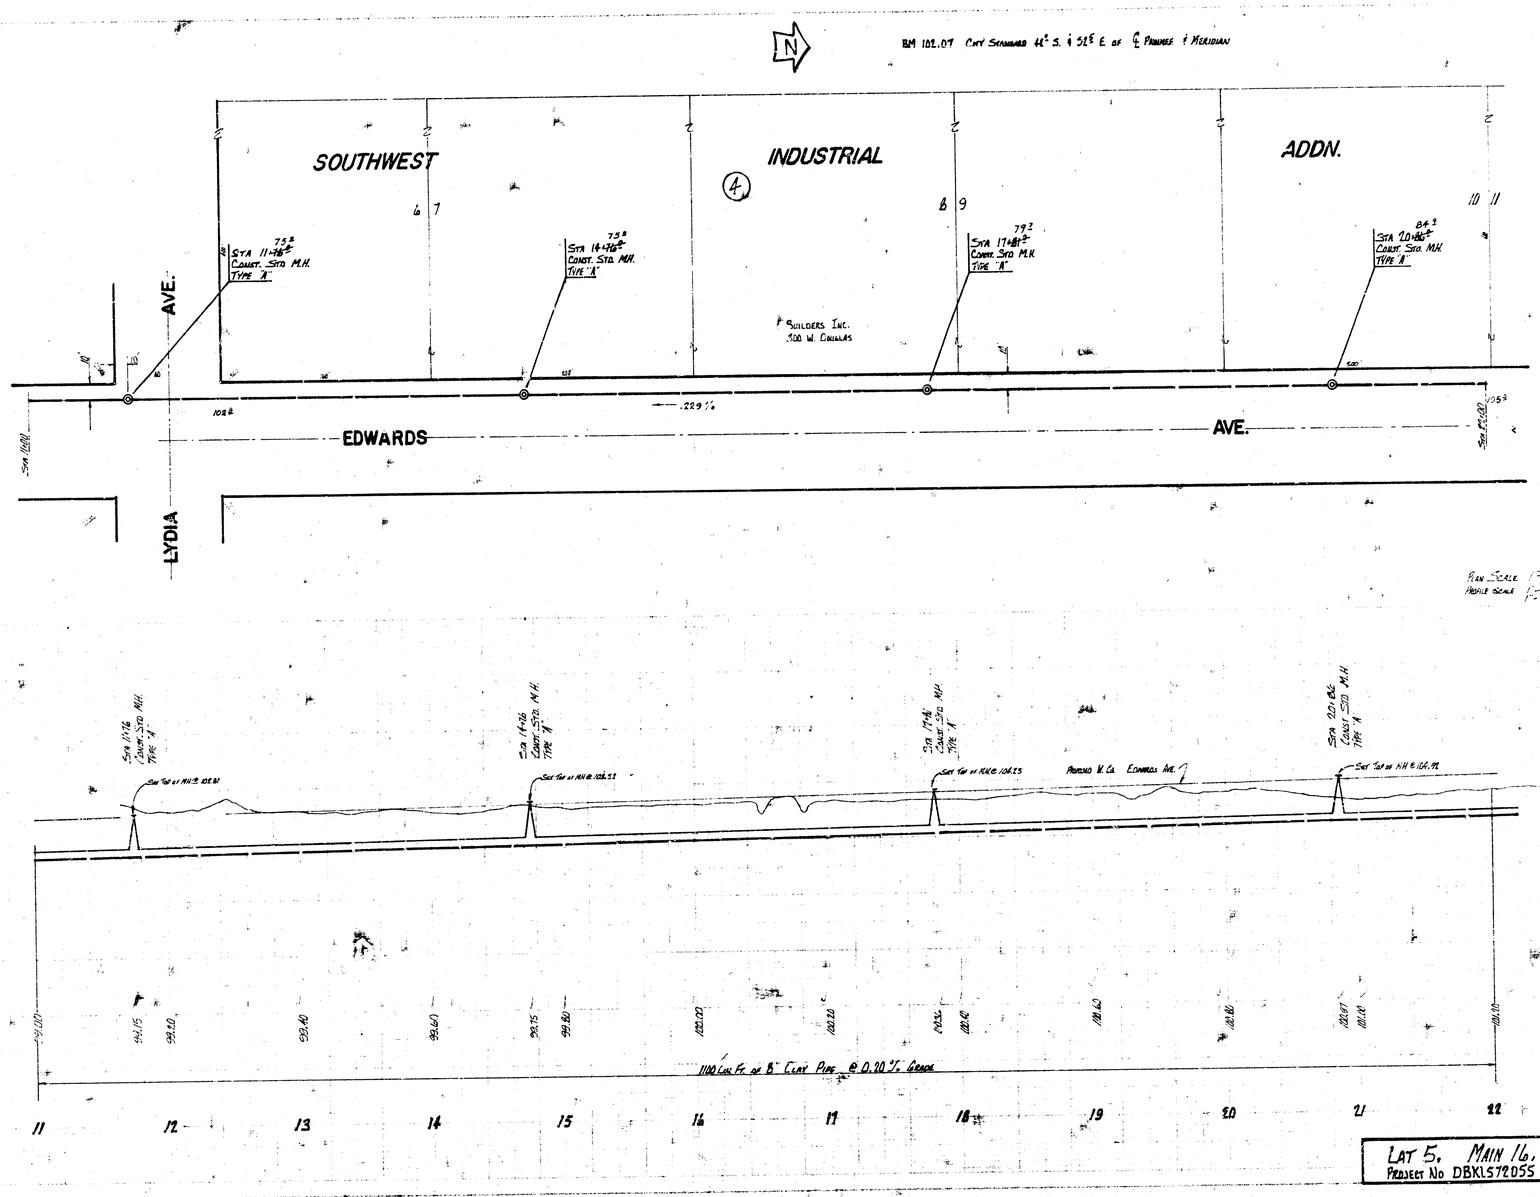

LAT 5, MAIN 16, S.S. NO 22
PROJECT NO DBKLS72055 SHEET 2 OF 3

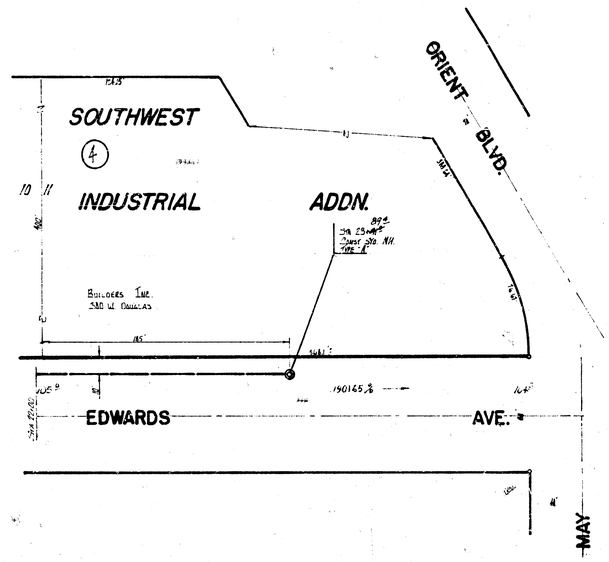

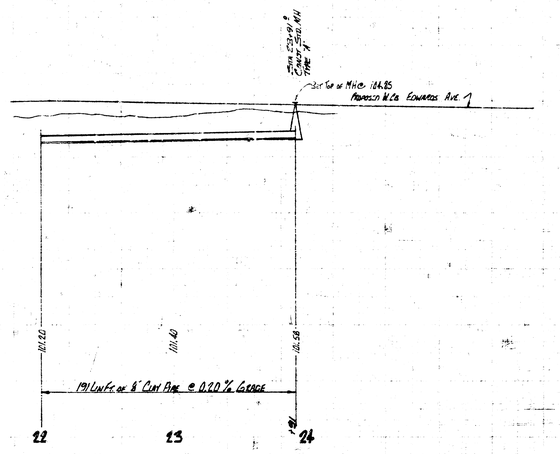

Lot 5, Main Ln. S.S. No 22
Project No DBKLS72055 Sheet 3 of 3