RIVERDALE

E. W. KEITH REPLAT OF PART OF RUSSELL TRACTS

WHEELERS REPLAT

RIVERDALE ADDN.

PORTER AVE.

32ND. ST. NO.

LINE NO. 1

LINE NO. 2

LINE NO. 3

Marion A. Bunn 3331 Riverdale

Lee W. Ferguson 3316 Porter

R.A. Galloway 3309 Porter

C.F. Himebaugh 3315 Riverdale

I.J. Ancestaver 3301 Porter

James Siggerty 3301 Coolidge

Ralph W. Fitzgerald 3310 Riverdale

Cecil M. Cole 3318 Riverdale

Robt. E. Wilson 3314 Riverdale

U.P. Murphy 3382 Riverdale

Harold O. Sharp 3321 Riverdale

Alfred J. Gallitty 3342 Riverdale

STA. C162 CONST. STD. M.H. TYPE "A" CONST. 4"STUB W. F.N.

STA. 7165 CONST. STD. M.H. TYPE "A" STA. 0100 LN. #3

STA. 0100 LN. #1 STD. M.H.

STA. 2100 EX. STD. M.H.

STA. 1378 BEGIN PROJ.

STA. 0100 LN. #2

STA. 0130 LN. #3

STA. 7165 LN. #1

STA. 0142 CONST. STD. M.H. TYPE "A" CONST. 4"STUB W.F.N.

GENERAL NOTES:

#1 - Replace all fences.
#2 - Repair Street with 6" Crushed rock & 2" Asphaltic conc.
#3 - Replace all culvert pipe.
#4 - 4" Stubs to be included in bid price of lin. Ft. 8" V.C.F.
#5 - Sandfill or Flush where indicated on plan.
#6 - Repair surface of drives with 6" Crushed rock.

B.M. 1309.95 Stp. Bench W. 3. P.P. E. S. Coolidge 1st Pole S of 32nd St. No.
B.M. 1310.27 E. Rim Mfd Hole Sta 0+00.
B.M. 1308.78 Find P. Nail & S.R.P. W.S. 33rd St. No. @ E.C. Riverdale Rd.
B.M. 1317.27 Stp. Bench W.S. P.P. 33 Riverdale Rd 200'S of E.C. Porter Ave.

Plan Scale 1" = 40'
Profile Scale 1" = 40' HOR. 1" = 4' V.

Sand Fill LINE NO. 2 or Flush

Sand Fill or Flush LINE NO. 3

75 LIN. FT. 8" V.C.P. @ 0.15% GRADE

323 LIN. FT. 8" V.C.P. @ 0.20% GRADE

42 LIN. FT. 8" V.C.P. @ 1.00% GRADE

LAT. 8 SUB. 17 S.S. 22
CITY OF WICHITA, KANSAS
BY E. SMITH CITY ENGINEER
PROJECT NO. C 23-15
DATE OCT. 1966

SHEET 1 OF 4

RIVERDALE

ADDN.

33 RD.

ROAD

RIVERD. E

LINE NO. 1

LINE #5

STR. 0+92 CONST. STD. M.H. TYPE "A" CONST. 4'-0" I.D. M.H. END LINE #5

STR. 11+88 CONST. STD. M.H. TYPE "A" CONST. 4'-0" I.D. M.H. STR. 0+00 LINE #5

STR. 13+88 CONST. STD. M.H. TYPE "A" CONST. 4'-0" I.D. M.H. NOTE: CONST. TOP OF M.H. TO CLEAR 18" R.R.

STR. 16+00 CONST. STD. M.H. TYPE "A" CONST. 4'-0" I.D. M.H. END LINE NO. 1

STR. 16+00 CONST. STD. M.H. TYPE "A" CONST. 4'-0" I.D. M.H. END LINE NO. 1

STR. 0+00 LINE #5 STR. 11+88 LINE NO. 1

STR. 0+92 CONST. STD. M.H. TYPE "A" CONST. 4'-0" I.D. M.H. END LINE #5

Chas. W. Berger 3378 Riverdale Rd.

Fay J. Grimes 3371 A Riverdale Rd.

W. Olin Bannon 3331 Riverdale Rd.

Lutherford V. Johnson 3339 Riverdale Rd.

Raymond T. Linden 3382 Riverdale Rd.

W. T. Filer 3362 Riverdale Rd.

Herschel B. Coat 1601 Woodrow

Arthur F. Sandhoff 3372 Riverdale Rd.

Clinton L. O'Dell 1125 W. 33rd St. No.

John Elmer Smith Jr.

Alfred J. Gadbelly 3362 Riverdale Rd.

Set top M.H. @ 128.20

Set top M.H. @ 128.83

Sand Fill or Flush

LINE NO. 1

LINE NO. 5

8" V.C.P. @ 0.20%

8" V.C.P. @ 1.00%

300 LIN. FT. 8" V.C.P. @ 0.20% GRADE

92 LIN. FT. 8" V.C.P. @ 1.00% GRADE

F/O out 123.50

F/O out 123.65 Line #5 out 123.66

F/O out 123.83 Line #5 out 123.76

F/O out 124.03

F/O out 124.18

F/O out 124.38

F/O out 124.58

F/O out 124.78

F/O out 124.98

F/O out 125.18

Line #5 out 125.66

Line #5 out 125.76

120


130

8 9 10 11 12 13 14 15 16 17 18

LAT. 8 SUB. 17 S.S. 22

C 23 - 15

SHEET 2 OF 4

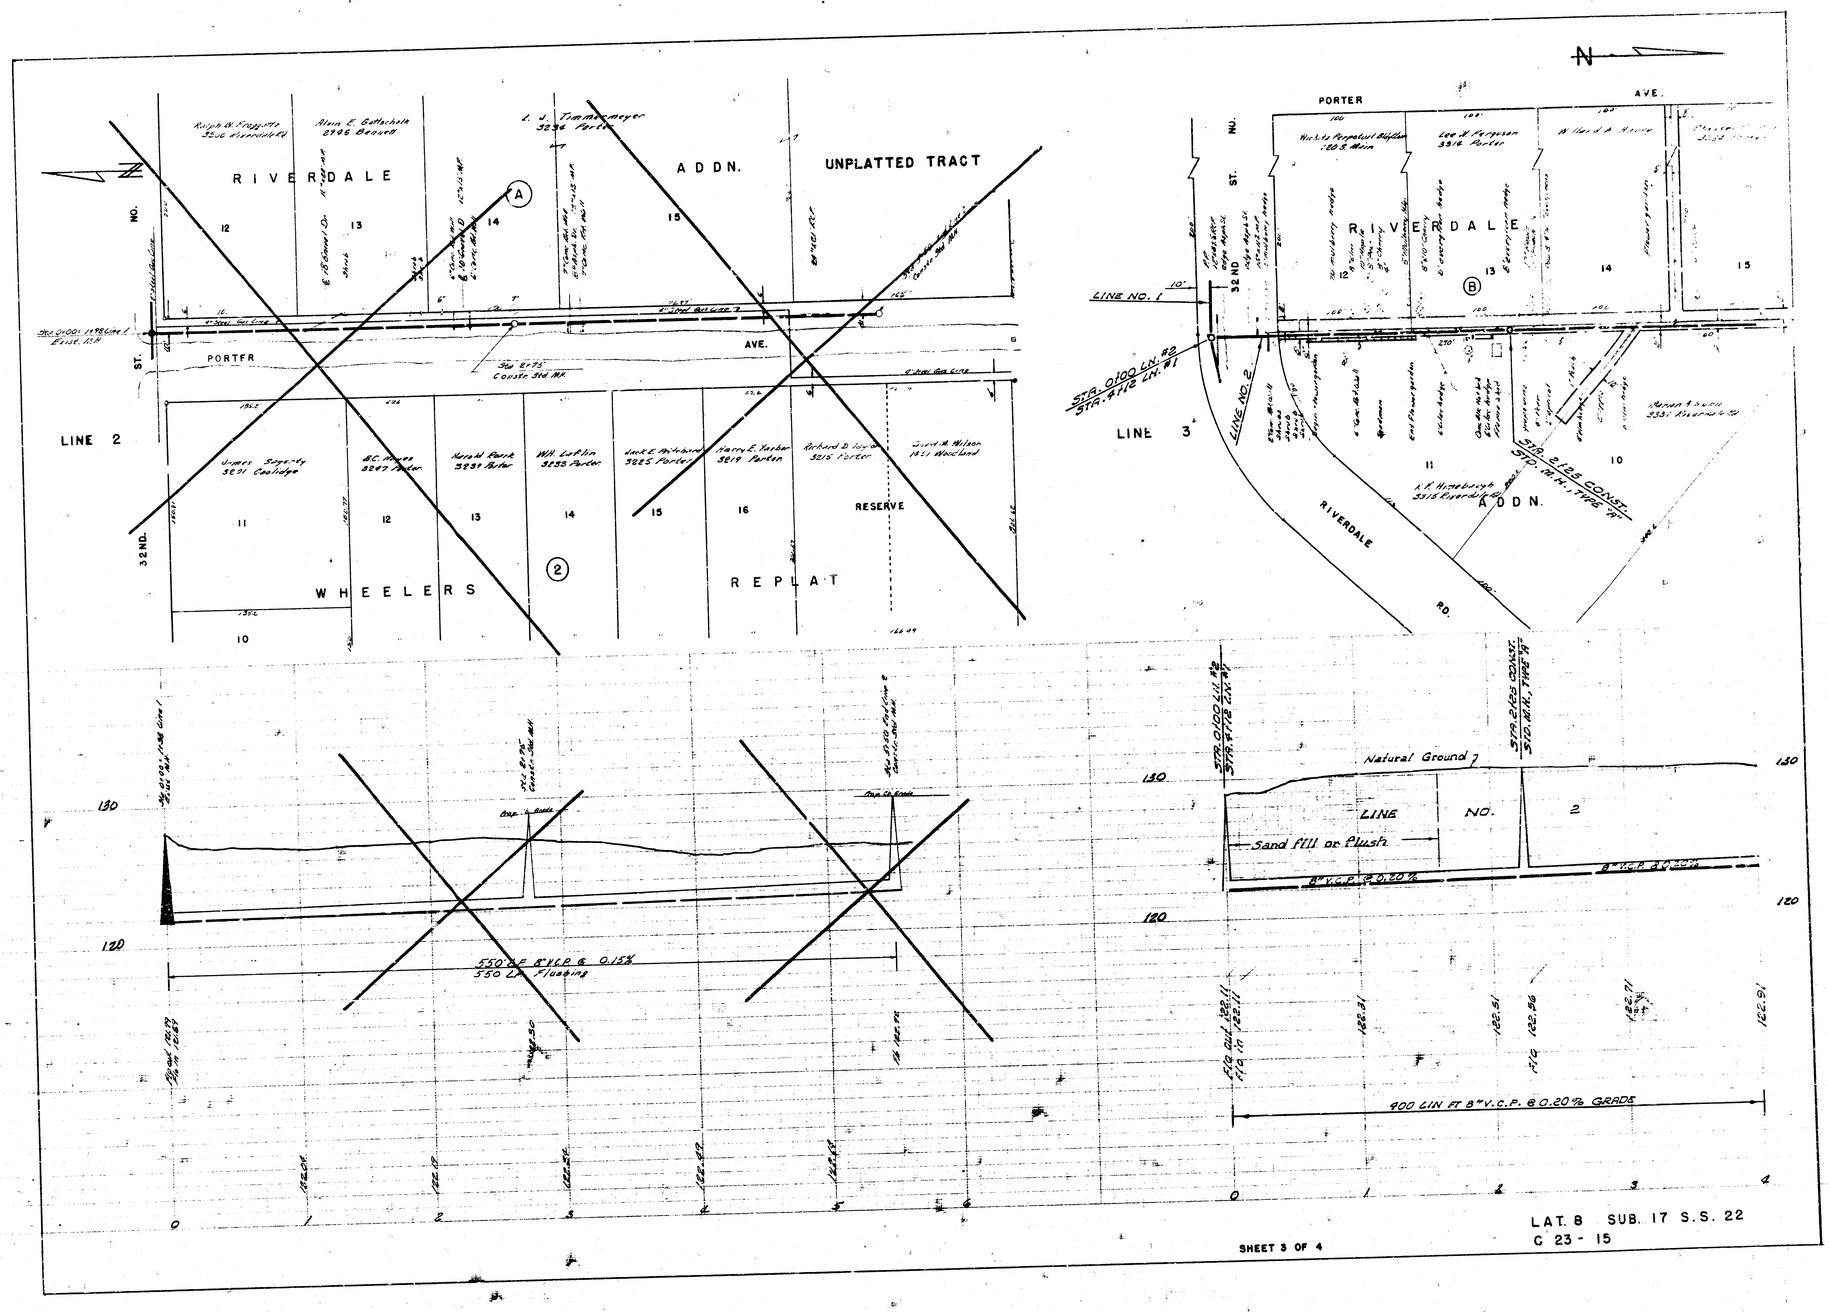

SHEET 3 OF 4

LAT. 8 SUB. 17 S.S. 22
C 23 - 15

PORTER AVE.

RIVERDALE

Chester F. Smith 3556 Porter

E. C. Gallogly 3543 Porter

Carl C. Hanson 3542 Porter

15 1 2

NO. ST. 33RD.

STA. 5+50 CONST. STA. 10+00 CONST. STA. 10+00 LINE NO. 2

LINE NO. 2

LINE NO. 3

B

Maurice A. Partington 1539 W. 33rd St. Rk.

11 10 3 4

Edgar A. Gunn 3551 Riverdale Rd.

9 4

R. J. Johnson 3339 Riverdale Rd.

Carl B. Rankin 1861 W. 33rd St. Rk.

A D D N.

33RD ST. NO.

RIVERDALE

Carl E. Morton 3542 Porter

Maurice A. Partington 1537 W. 33rd St. Rk.

Carl B. Rankin 1861 W. 33rd St. Rk.

Norman M. Brearley 1829 W. 33rd St. Rk.

Chas. H. Hopson 3379 Riverdale Rd.

Fred J. Brears 3371 Riverdale Rd.

1 2 3 4 5 6 7

R.D.

E. C. Gallogly 3542 Porter

50' TEMP. CONST. EASEMENT

LINE #4

B

STA. 1+93 CONST. STD. M.H. TYPE 'A' CONST. 8" V.C.P. 2ND LN. STA. 1+93 N.E. 15.5

LINE #4

15 9 8

STA. 0+00 LIN. #2 STA. 1+58 LN. #2

LINE #2

R. J. Johnson 3339 Riverdale Rd.

W. Otto Brunow 3353 Riverdale Rd.

RIVERDALE

10 14 11

Marion A. Gunn 3551 Riverdale Rd.

A D D N.

STA. 1+58 CONST. STD. M.H. TYPE 'A' CONST. 8" V.C.P. 2ND LN. STA. 5+50 CONST. STD. M.H. TYPE 'A' CONST. 8" V.C.P. 2ND LINE NO. 2

Natural Ground

LINE NO. 2

8" V.C.P. @ 0.20%

8" V.C.P. @ 0.40%

130 120 4 5 6

123.52 F/O

196 LIN. FT. 8" V.C.P. @ 0.40% GRADE

34 LIN. FT. 8" V.C.P. @ 0.20% GRADE

STA. 0+00 LIN. #4 STA. 1+58 LN. #2

STA. 1+93 CONST. STD. M.H. TYPE 'A' CONST. 8" V.C.P. 2ND LN. N.E. 15.5

Natural Ground

LINE NO. 4

8" V.C.P. @ 0.60%

140 130 0 1 2 3 4

123.02 F/O 123.02

123.42

F/O 123.28

193 LIN. FT. 8" V.C.P. @ 0.40% GRADE

140 150

LAT. 8 SUB. 17 S.S. 22

C 23 - 15

SHEET 4 OF 4

8 15 3 4