


B.M. 129.60 NE cor. conc. step Ho # 2811 No. Amidon.

Plan Scale 1" = 40' Horiz.
Profile Scale 1" = 4' Vert.

GENERAL NOTES:

- #1 Contractor to replace all fences.

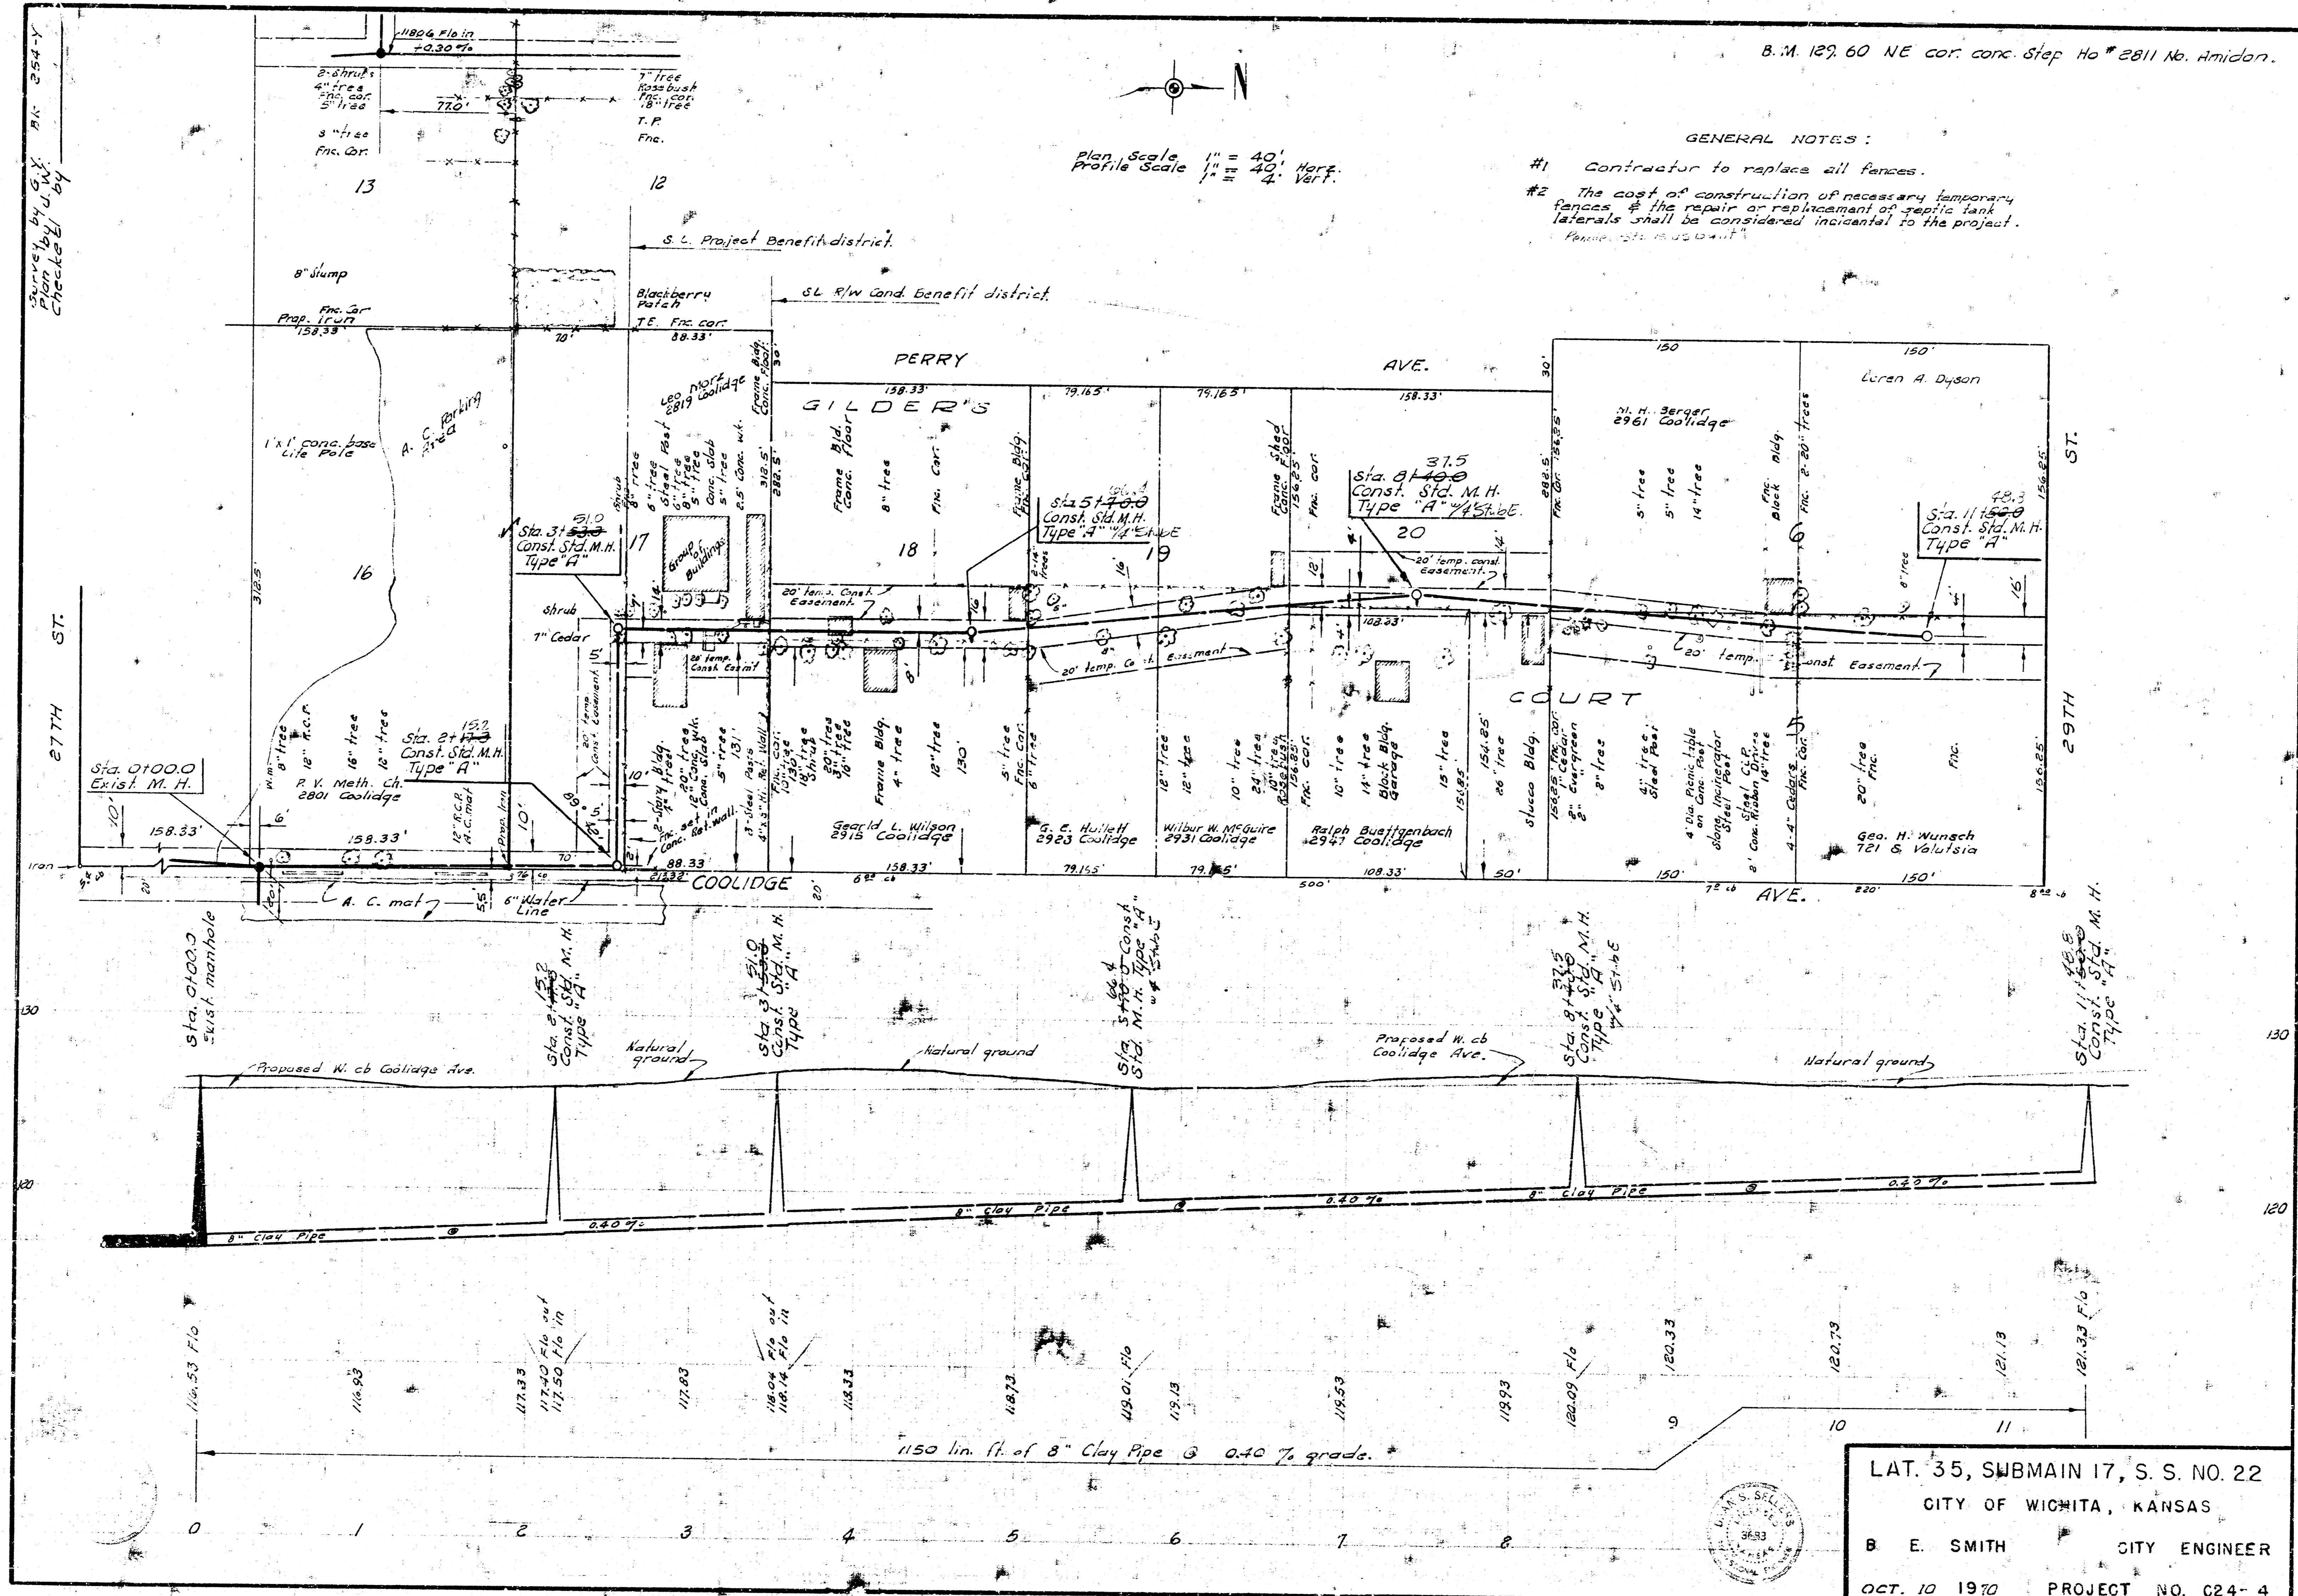

LAT. 35, SUBMAIN 17, S. S. NO. 22
 CITY OF WICHITA, KANSAS
 B. E. SMITH CITY ENGINEER
 OCT. 10 1970 PROJECT NO. C24-4

Checked by

27TH ST.

130

120

150









29TH ST.









