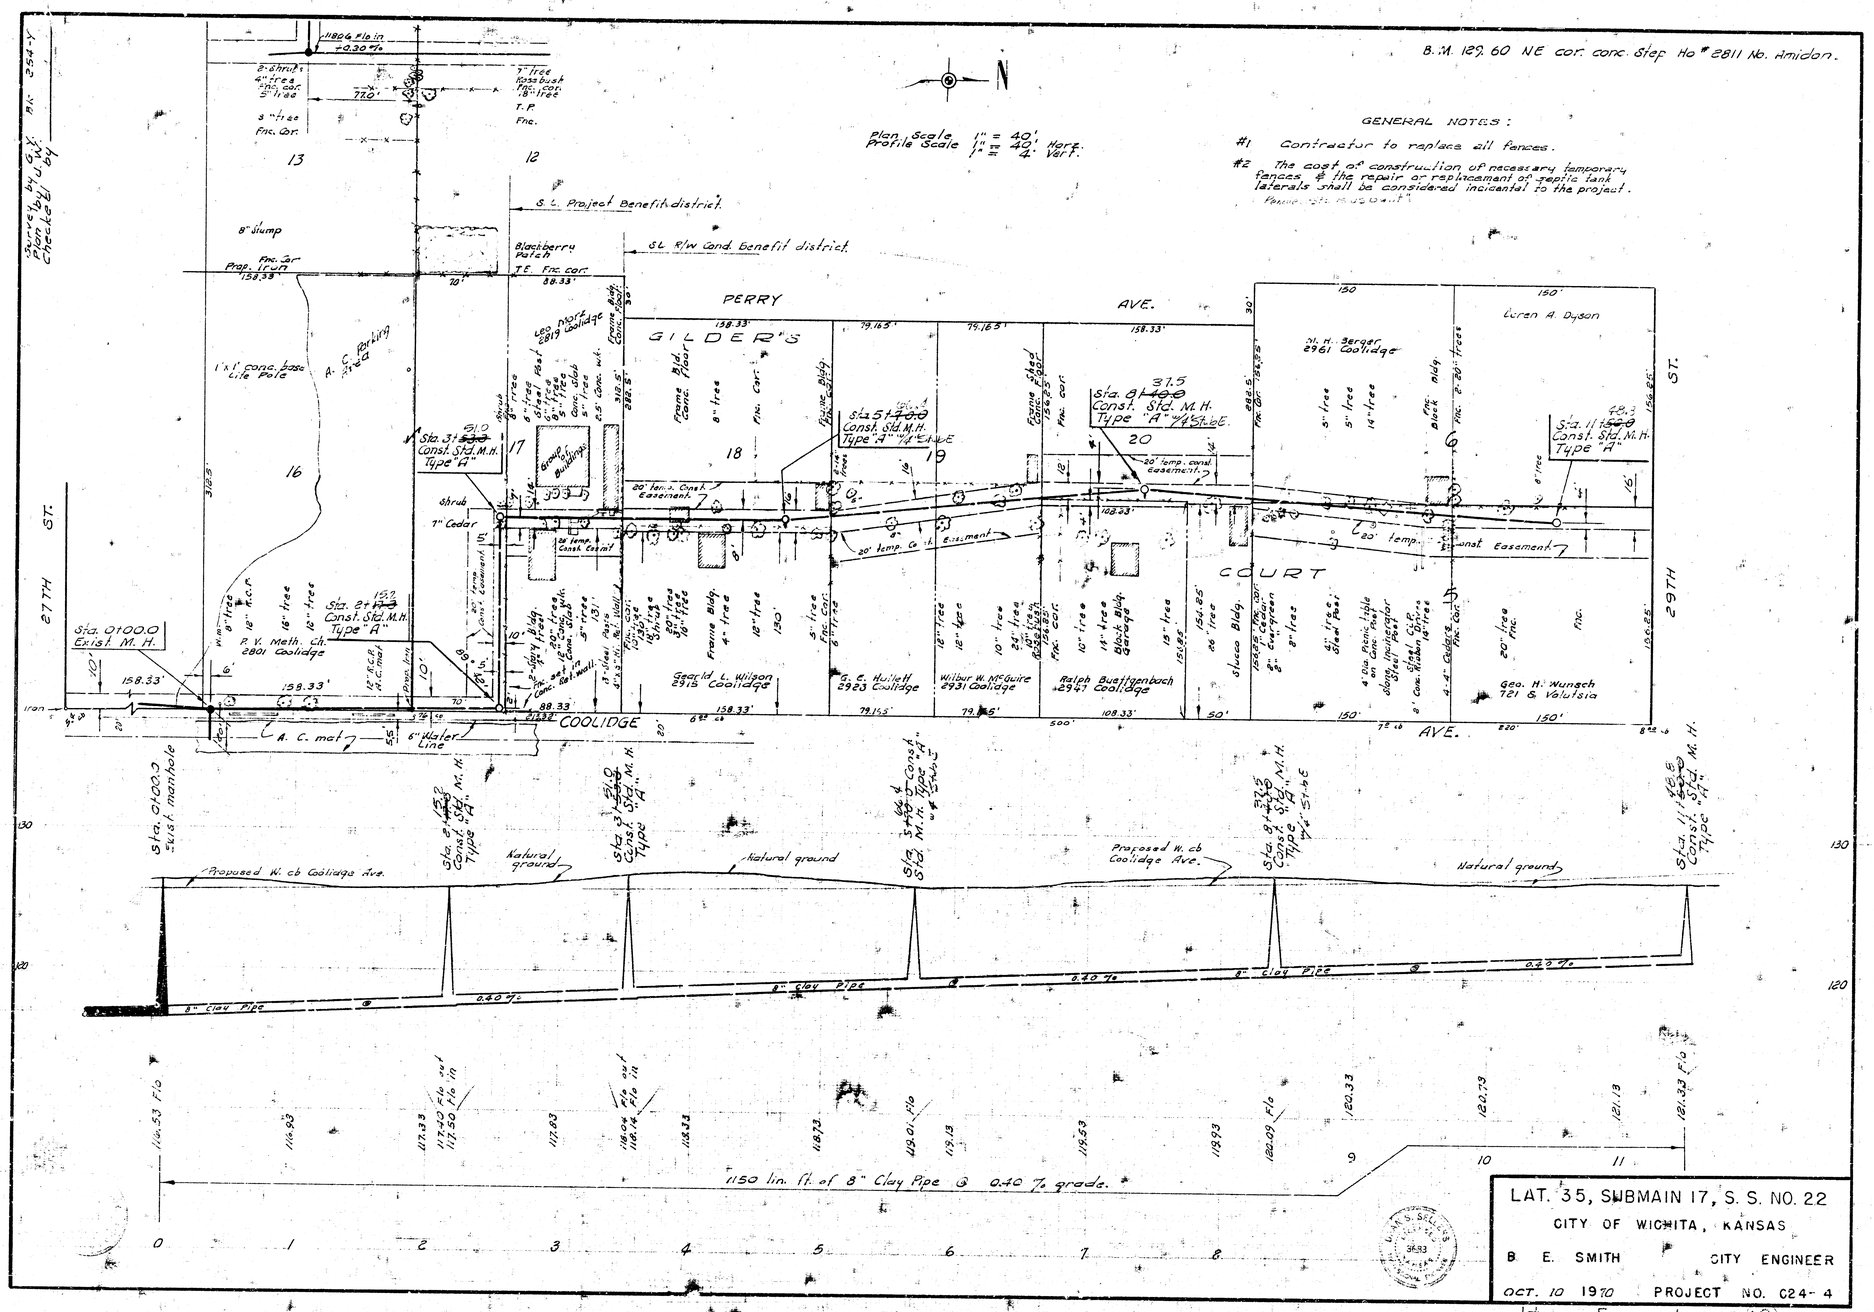
B.M. 129.60 NE cor. conc. Step Ho # 2811 No. Amidon.
GENERAL NOTES:
#1 Contractor to replace all fences.
#2 The cost of construction of necessary temporary fences & the repair or replacement of septic tank laterals shall be considered incidental to the project.
Plan Scale 1" = 40'
Profile Scale 1" = 40' Horz. 1" = 4' Vert.
S.L. Project Benefit district.
SL R/W Cond. Benefit district.
PERRY AVE.
GILDER'S COURT
COOLIDGE AVE.
27TH ST.
29TH ST.
Sta. 0+00.0 Exist. M.H.
Sta. 3+51.0 Const. Std. M.H. Type "A"
Sta. 5+70.0 Const. Std. M.H. Type "A" w/4" Stub E
Sta. 8+37.5 Const. Std. M.H. Type "A" w/4" Stub E
Sta. 11+48.3 Const. Std. M.H. Type "A"
Sta. 0+00.0 Exist. manhole
Proposed W. cb Coolidge Ave.
Natural ground
8" Clay Pipe @ 0.40 %
1150 lin. ft. of 8" Clay Pipe @ 0.40 % grade.
LAT. 35, SUBMAIN 17, S. S. NO. 22
CITY OF WICHITA, KANSAS
B. E. SMITH CITY ENGINEER
OCT. 10 1970 PROJECT NO. C24-4