

Survey King
Plat Laurent
Ex.
Check&c

Bk 7514-177

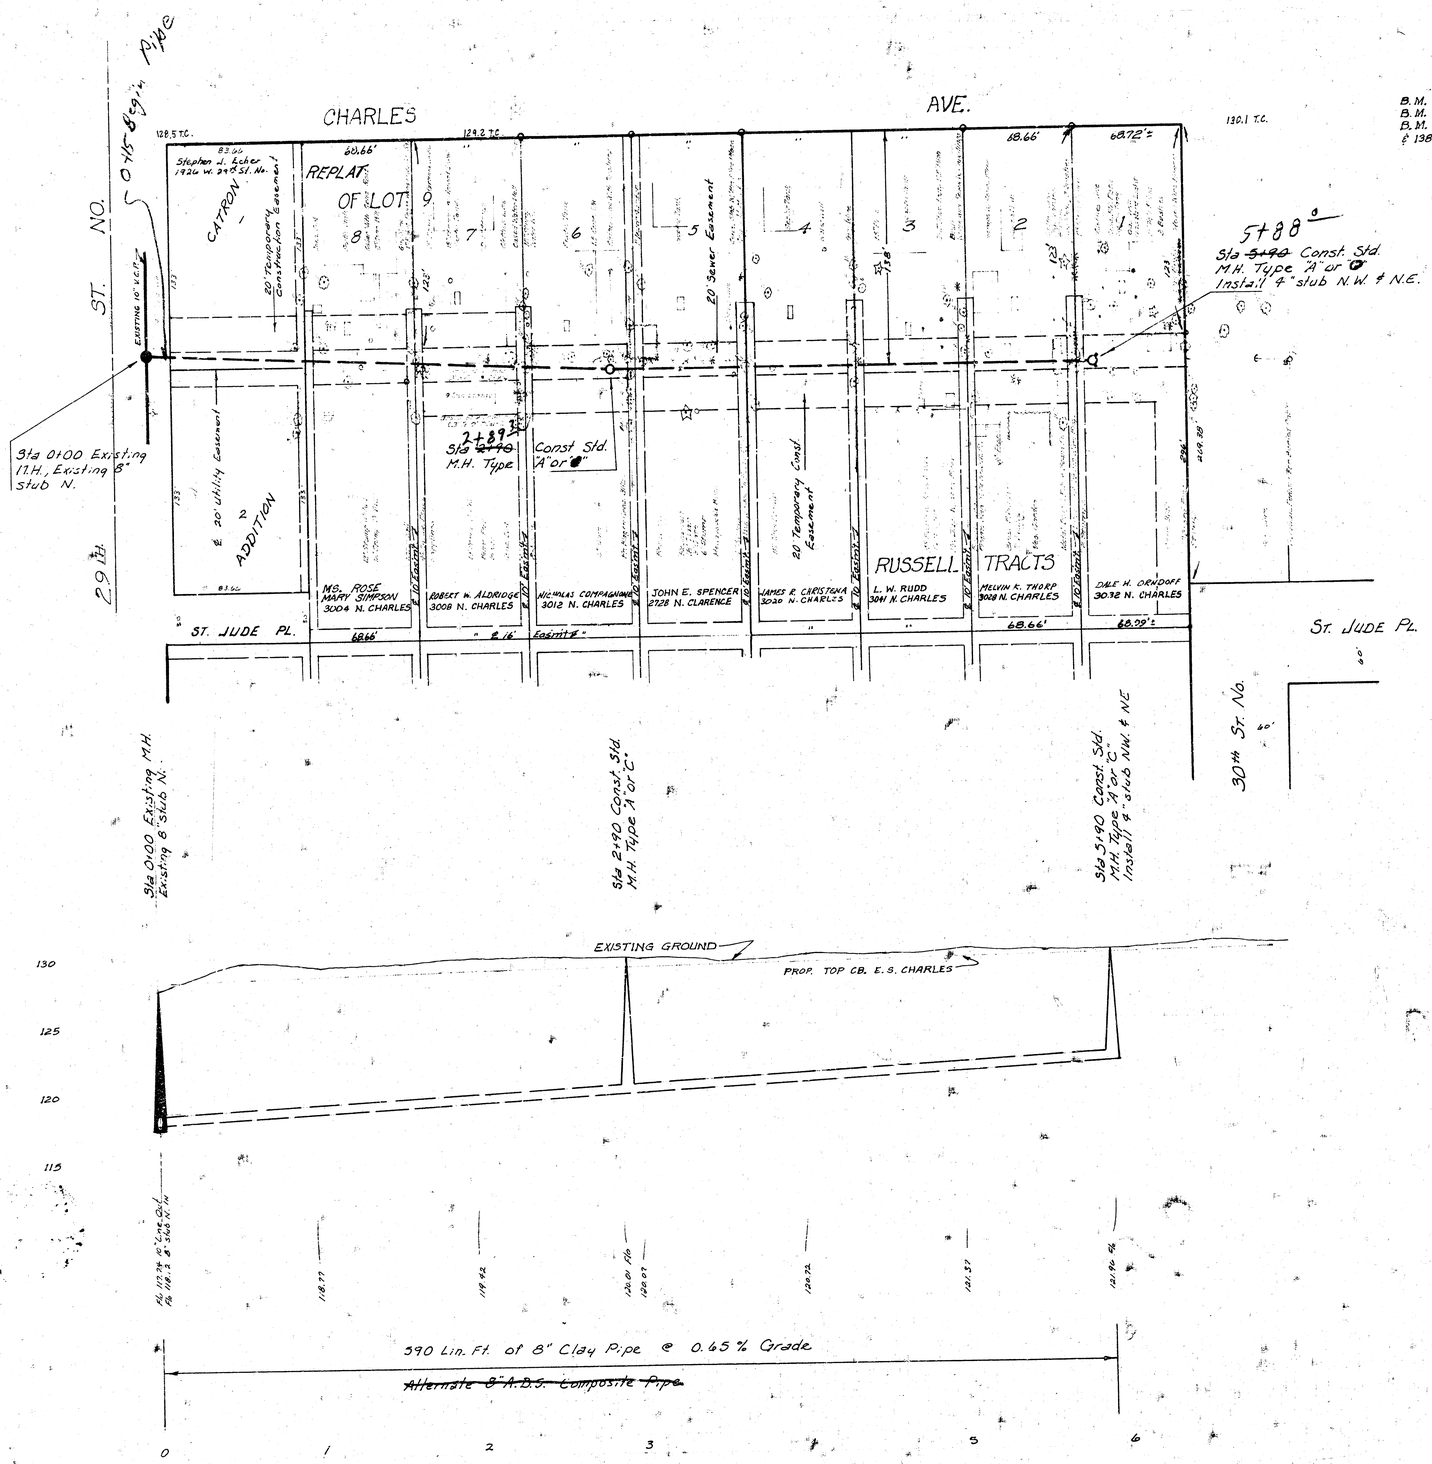

B.M. 12'±.22 CITY STANDARD 6' N. & 2' W. OF S. W. COR. 29TH & AMIDON.
B.M. 128.07 R.R. SPIKE S. FACE P.P. N.S. 29TH & 397' W. OF E. AMIDON.
B.M. 130.49 R.R. SPIKE S. FACE P.P. 62'± N. OF SL. 30TH ST. EXTENDED & 138'± E. OF E.L. CHARLES.

Scale Plan 1"=40'
Profile 1"=40' Horz.
1"=5' Vert.

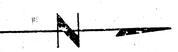

GENERAL NOTES

1. CONTRACTOR SHALL GIVE PROPERTY OWNERS AFFECTED BY THE CONSTRUCTION OF THIS PROJECT A MINIMUM OF 24 HOURS ADVANCE NOTICE PRIOR TO THE START OF CONSTRUCTION.
2. CONDITIONS WERE MADE AS A RESULT OF RIGHT OF WAY ACQUISITION AND SHALL BE ADHERED TO BY THE CONTRACTOR AS FOLLOWS:

   LOT 1, REPLAT OF LOT 9, RUSSELL TRACTS - CONTRACTOR TO RESET FENCE.

   LOT 2, REPLAT OF LOT 9, RUSSELL TRACTS - CONTRACTOR TO REPLACE FENCE.

   LOT 3, REPLAT OF LOT 9, RUSSELL TRACTS - CONTRACTOR TO RESET FENCE.

   LOT 4, REPLAT OF LOT 9, RUSSELL TRACTS - CONTRACTOR TO RESET FENCE.

   LOT 5, REPLAT OF LOT 9, RUSSELL TRACTS - CONTRACTOR TO RESET FENCE.

   LOT 6, REPLAT OF LOT 9, RUSSELL TRACTS - CONTRACTOR TO RESET FENCE AND CLOTHESLINE POLE.

   LOT 7, REPLAT OF LOT 9, RUSSELL TRACTS - CONTRACTOR TO RESET FENCE AND HAND DIG AROUND STORAGE BUILDING.

   LOT 8, REPLAT OF LOT 9, RUSSELL TRACTS - CONTRACTOR TO RESET FENCE.

   LOT 1, CATRON ADDITION - CONTRACTOR TO RESET FENCE.

DONALD E. SCHNEIDER
LICENSED
6311
KANSAS
PROFESSIONAL ENGINEER

As built 10-27-77

LAT. 56, MAIN 17, S. S. 22
CITY OF WICHITA, KANSAS
R. W. LINN, CITY ENGINEER
PROJ. NO. DBKL 572027
DATE: June, 1977

1/1