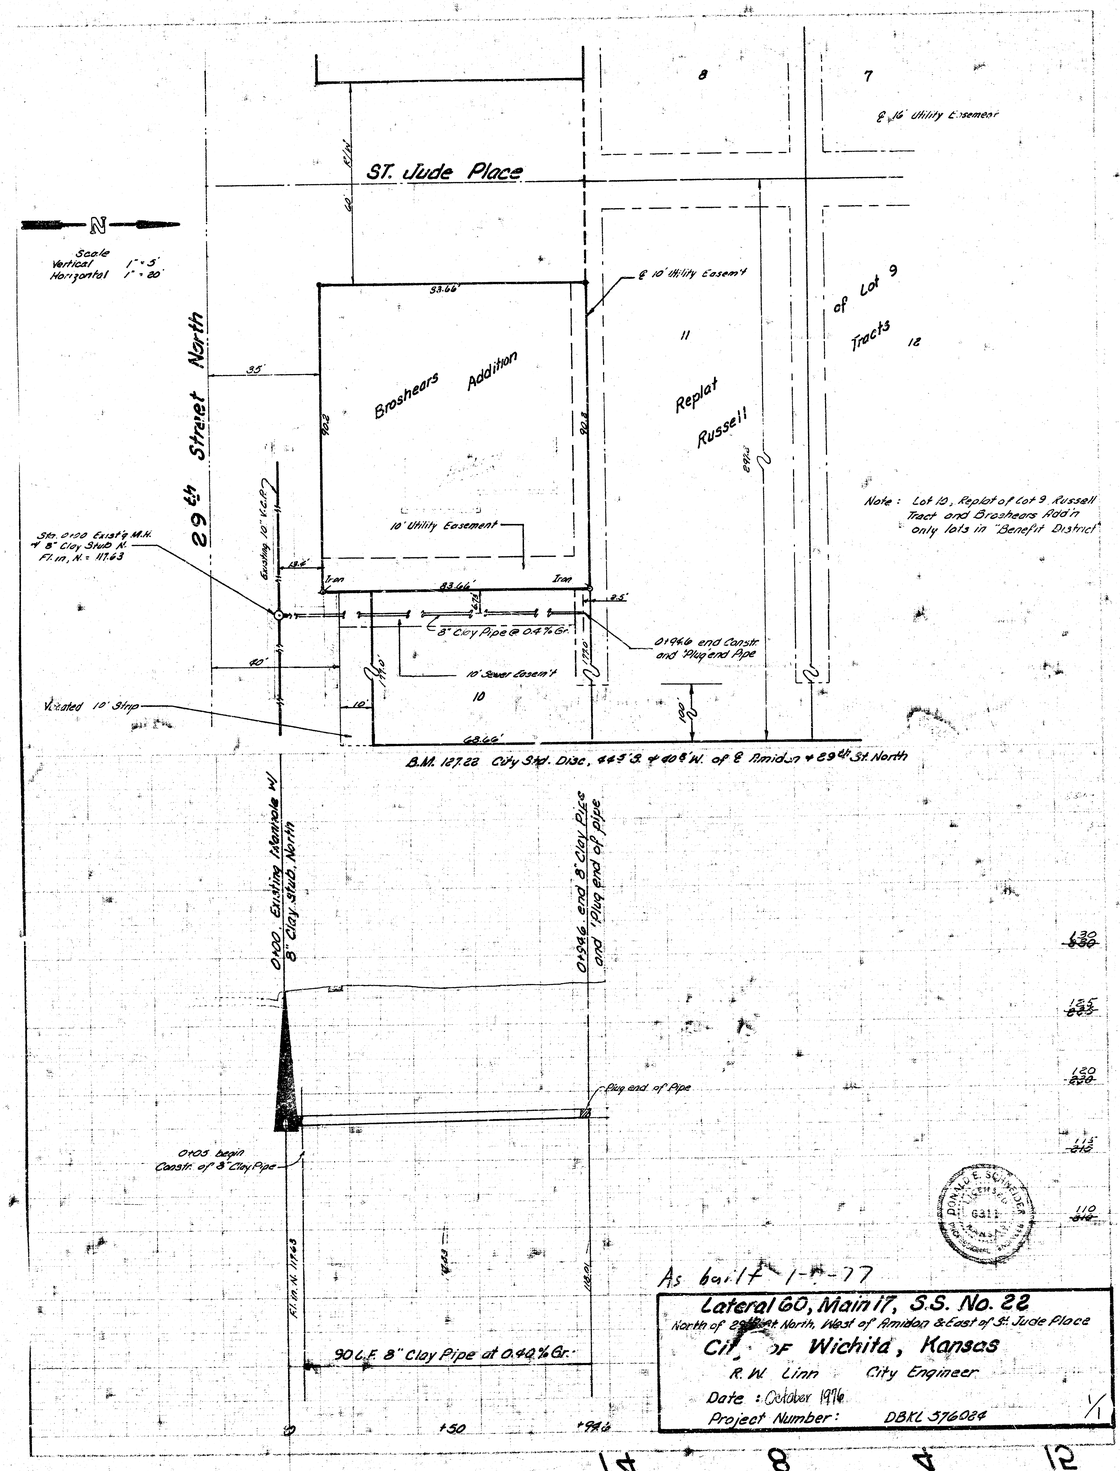

ST. Jude Place
29th Street North
Scale
Vertical 1"=5'
Horizontal 1"=20'
8
7
E 16' Utility Easement
E 10' Utility Easement
Broshears Addition
11
Replat
Russell
of Lot 9
Tracts
12
10' Utility Easement
Existing 10" V.C.P.
Sta. 0+00 Exist'g M.H.
& 8" Clay Stub N.
Flow. N.: 1117.63
83.66'
8" Clay Pipe @ 0.44% Gr.
01966 end Constr. and Plug end Pipe
10' Sewer Easement
10
Located 10' Strip
68.66'
B.M. 1127.22 City Std. Disc, 665'S & 40'W. of E Amidon & 29th St. North
Note: Lot 10, Replat of Lot 9 Russell Tract and Broshears Add'n only lots in "Benefit District"
0+00 Existing Manhole w/ 8" Clay Stub, North
01946 end 8" Clay Pipe and Plug end of pipe
Plug end of Pipe
0+03 begin Constr. of 8" Clay Pipe
Flow In. 1114.63
90 L.F. 8" Clay Pipe at 0.44% Gr.
0
+50
+94.6
As built 1-7-77
Lateral 60, Main 17, S.S. No. 22
North of 29th St. North, West of Amidon & East of St. Jude Place
City of Wichita, Kansas
R. W. Linn City Engineer
Date: October 1976
Project Number: DBKL 376024
1/1
14
8
4
12