

B.M. 129.04 City Std. Disc. 32' E. & 24' N. of ℄ of Meridian & 29th St No.

N

SCALE PLAN 1" = 40'
PROFILE 1" = 40' HORZ.
1" = 5' VERT.

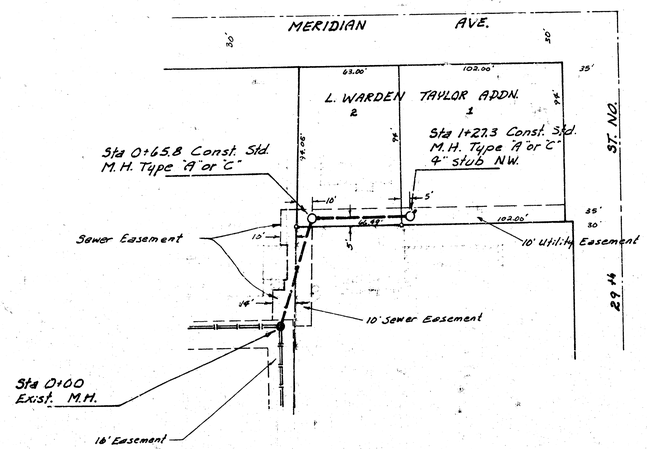


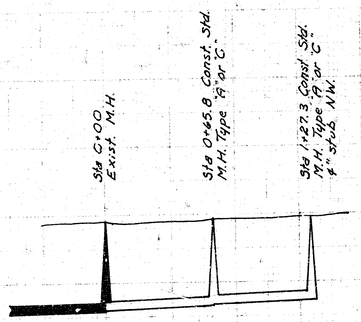


LAT 62, MAIN 17, SAN. SEW. #22
CITY OF WICHITA, KANSAS
R. W. LINN - CITY ENGINEER
PROJ. NO. 468-76-245-80453-000-000-001

Scale Plan 1" = 40'
Profile 1" = 40' Horz.
1" = 5' Vert.

N

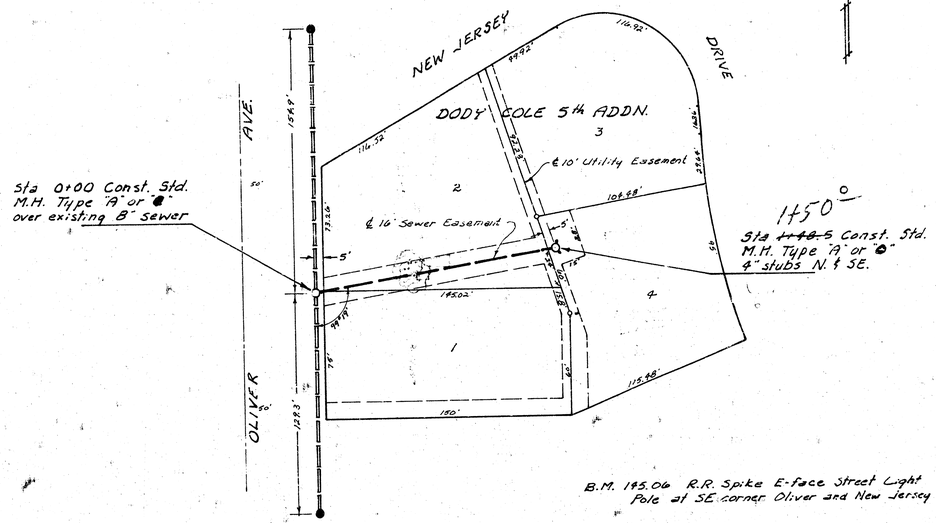

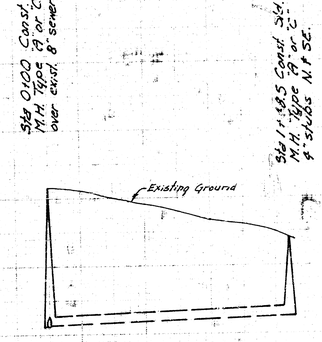

10-27-78 As Built

LAT 16, MAIN 10, WAR INDUSTRIES SEWER
CITY OF WICHITA, KANSAS
R. W. LINN — CITY ENGINEER
DATE PROJ. NO. 468-76-245-80514-000-000-001

14 3 3 18