PLAN SURVEYED ____ DRAWN ____ CHECKED ____ NOTE BOOK ____ NO ____ DATE ____ BY ____

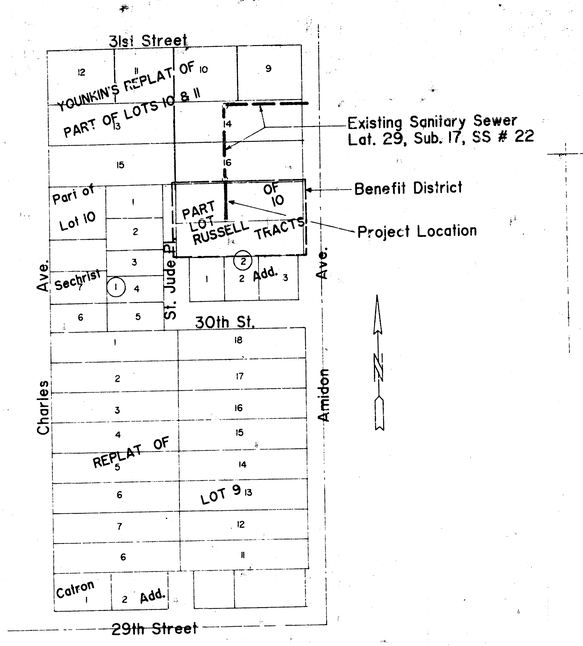

LOCATION MAP

Scale: 1" = 150

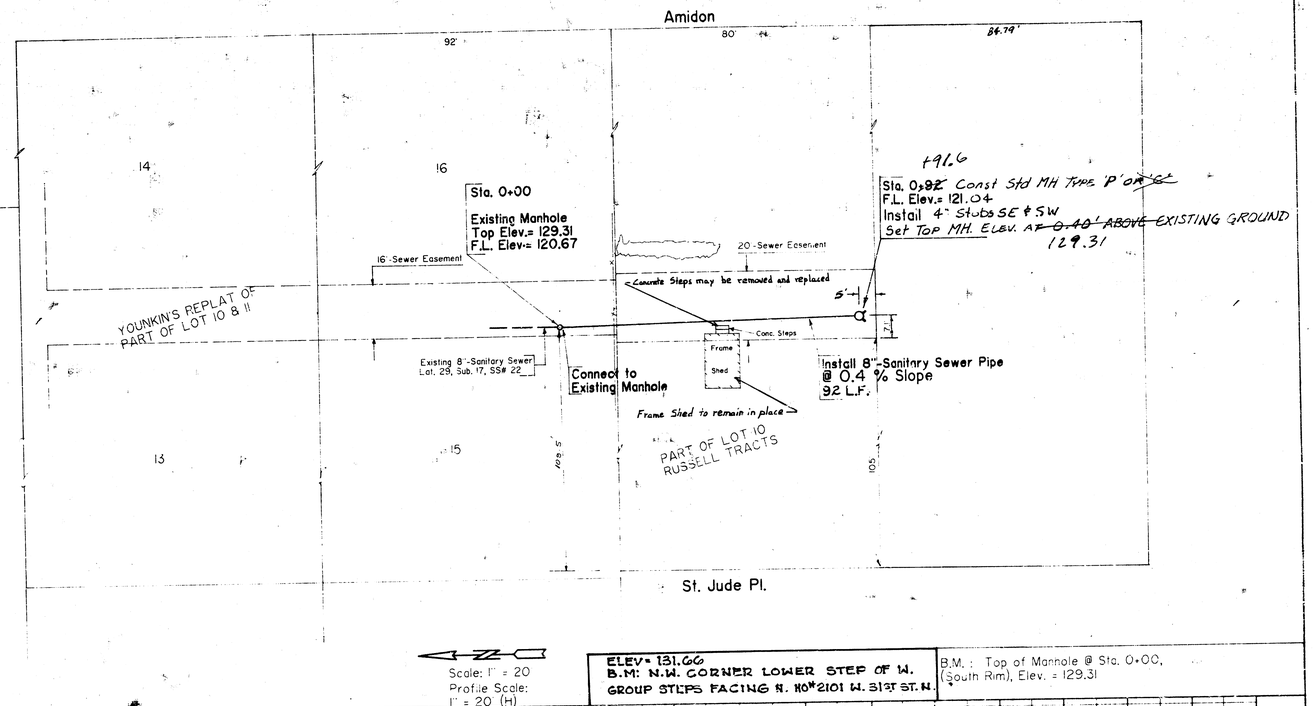

+91.6
Sta. 0+92 Const Std MH Type 'P' or 'G'
F.L. Elev.= 121.04
Install 4" Stubs SE & SW
Set Top MH. Elev. At ~~0.40'~~ ABOVE EXISTING GROUND
129.31

Scale: 1" = 20
Profile Scale:
1" = 20 (H)
1" = 5 (V)

ELEV= 131.66
B.M: N.W. CORNER LOWER STEP OF W. GROUP STEPS FACING N. 110'2101 W. 31ST ST. N.

B.M. : Top of Mannole @ Sta. 0+00, (South Rim), Elev. = 129.31

PROFILE SURVEYED ____ DRAWN ____ CHECKED ____ NOTE BOOK ____ NO ____ DATE ____ BY ____

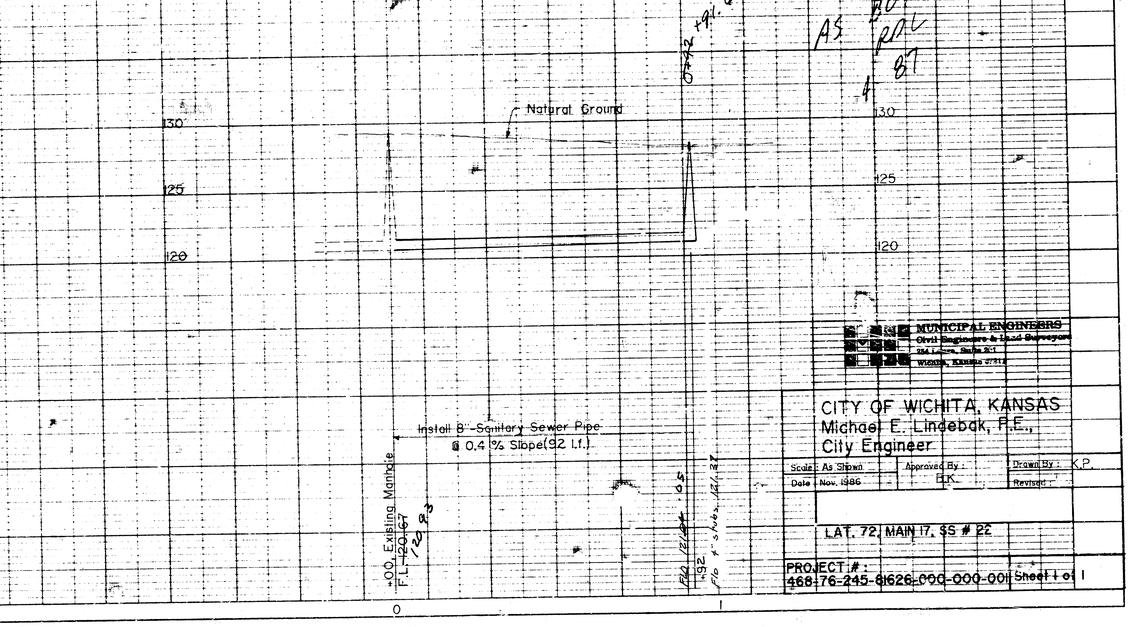

MUNICIPAL ENGINEERS
Civil Engineers & Land Surveyors
Wichita, Kansas 67211

CITY OF WICHITA, KANSAS
Michael E. Lindeback, P.E.,
City Engineer

Scale: As Shown	Approved By: B.K.	Drawn By: K.P.
Date: Nov. 1986		Revised:

LAT. 72, MAIN 17, SS # 22

PROJECT #: 468-76-245-81626-000-000-001 | Sheet 1 of 1

AS PER 87

FILMED FROM THE BEST AVAILABLE COPY....