
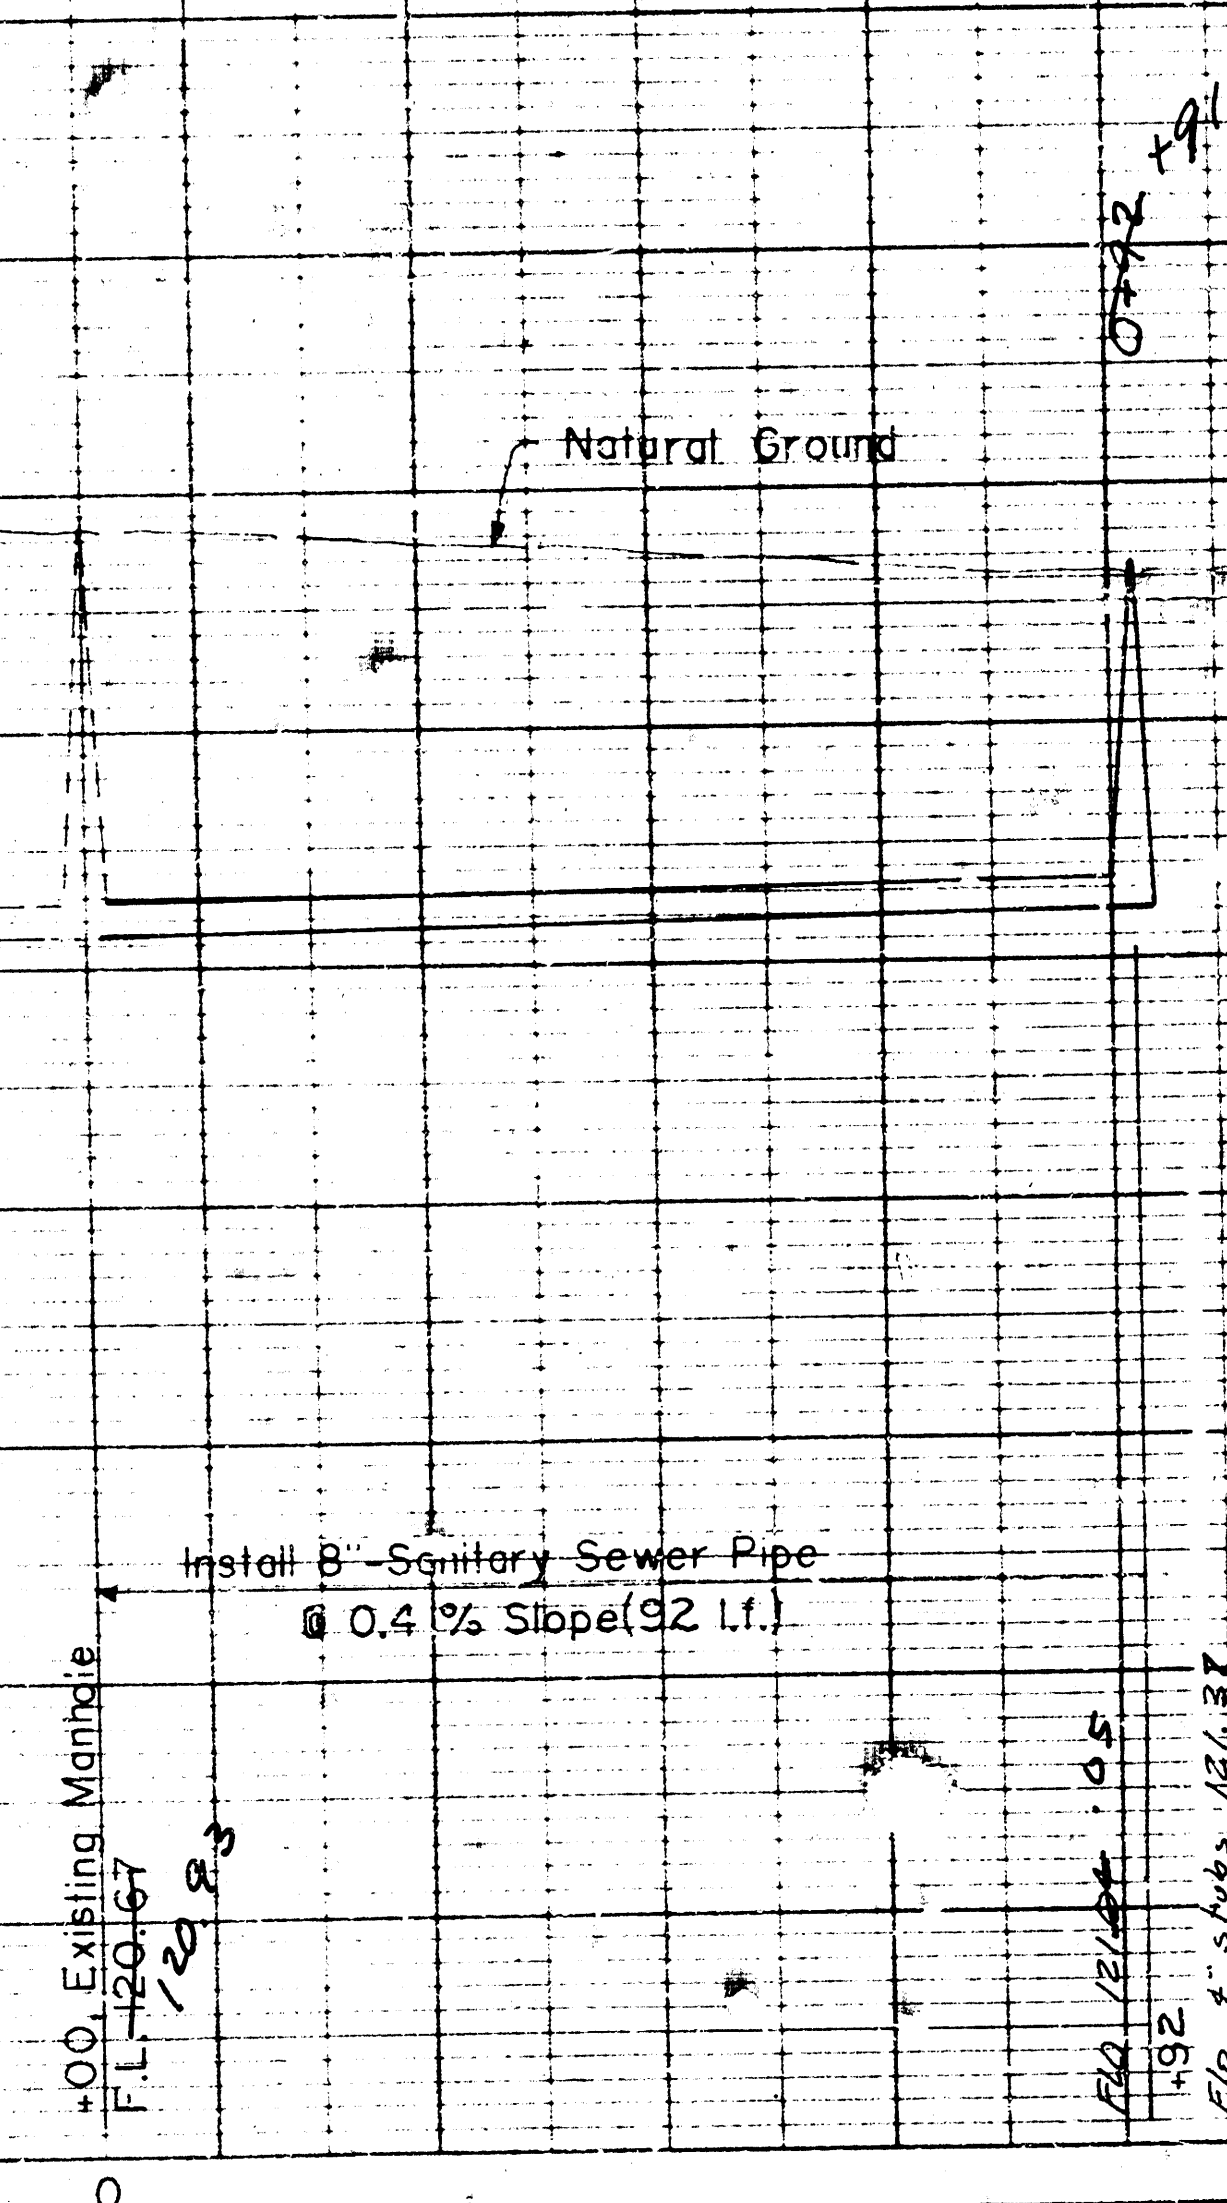
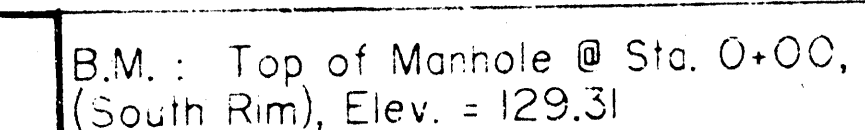
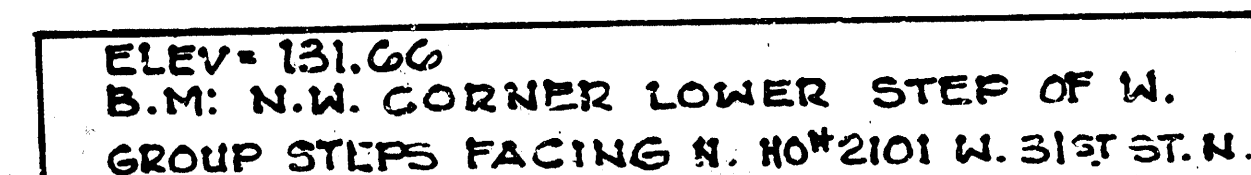
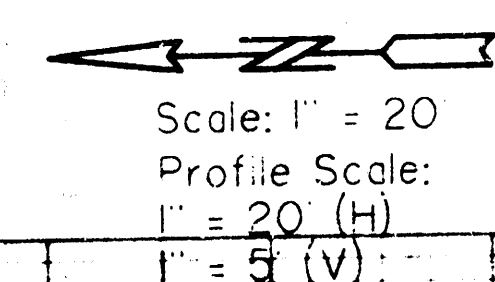
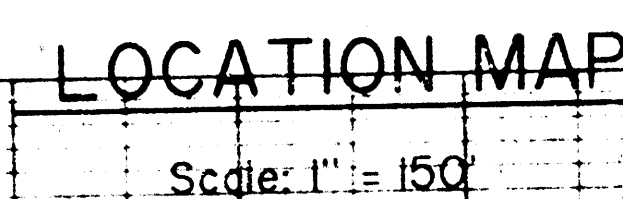
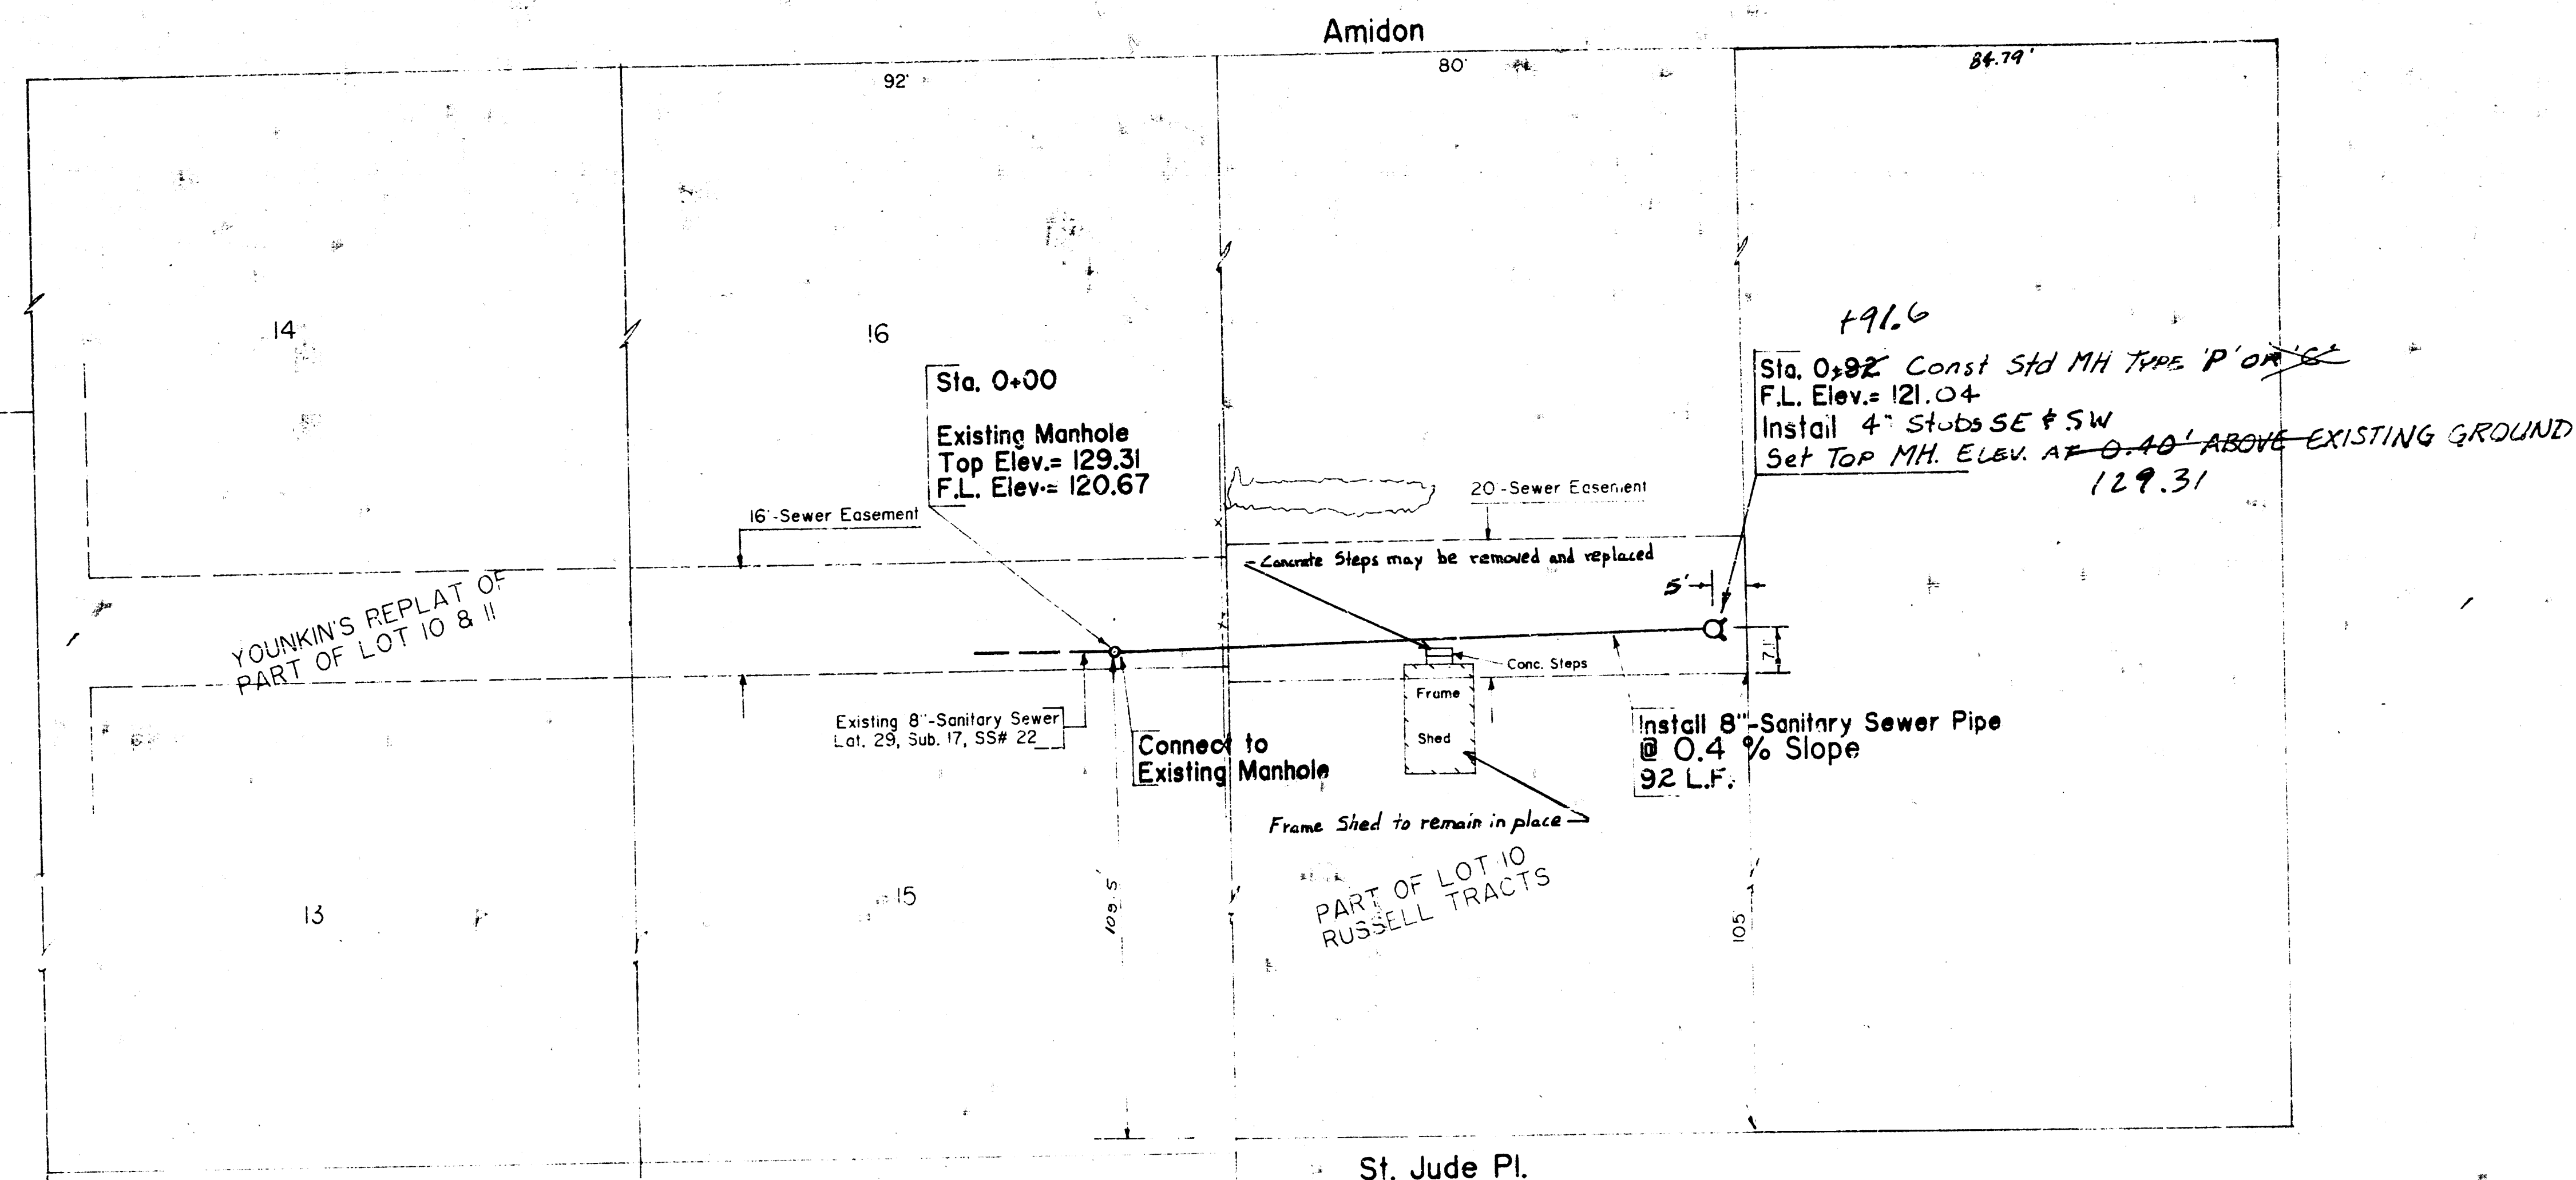


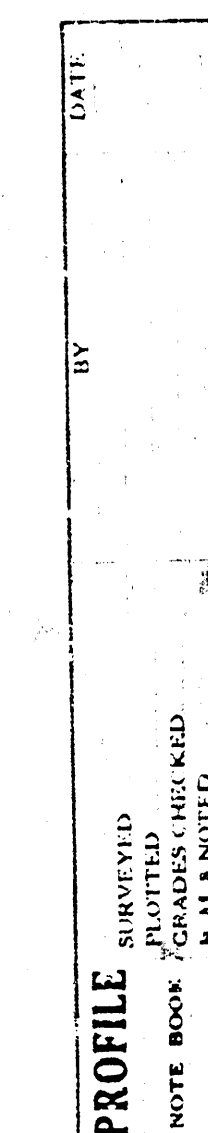

MUNICIPAL ENGINEERS
Civil Engineers & Land Surveyors
234 1/2 Ave. South 2nd
WICHITA, KANSAS 67211

CITY OF WICHITA, KANSAS
Michael E. Lindebak, P.E.,
City Engineer

Scale: As Shown	Approved By: <u>BK</u>	Drawn By: <u>K.P</u>
Date: <u>Nov 1986</u>		Revised: <u> </u>

LAT. 72. MAIN 17. SS # 22

PROJECT #:
468-76-245-81626-000-000-001 Sheet 1 of 1