B. M. 126.73 R. R. Spike on S. side P. Pole on N side 21st. St. at E. line River Park Addn.

B. M. 128.97 R. R. Spike on S. side P. Pole on N.W. cor. 21st St. and Hyacinth Lane.

B. M. 126.15 "□" cut top E. curb Hyacinth at S. L. Cornelison

B. M. 124.20 "□" cut top S. curb River Park Dr. 2' E. of W. L. Bullinger Dr.

Survey by J. F. G.
Plan by J. W.
Checked by

Book No. U.F.G. 109
Date

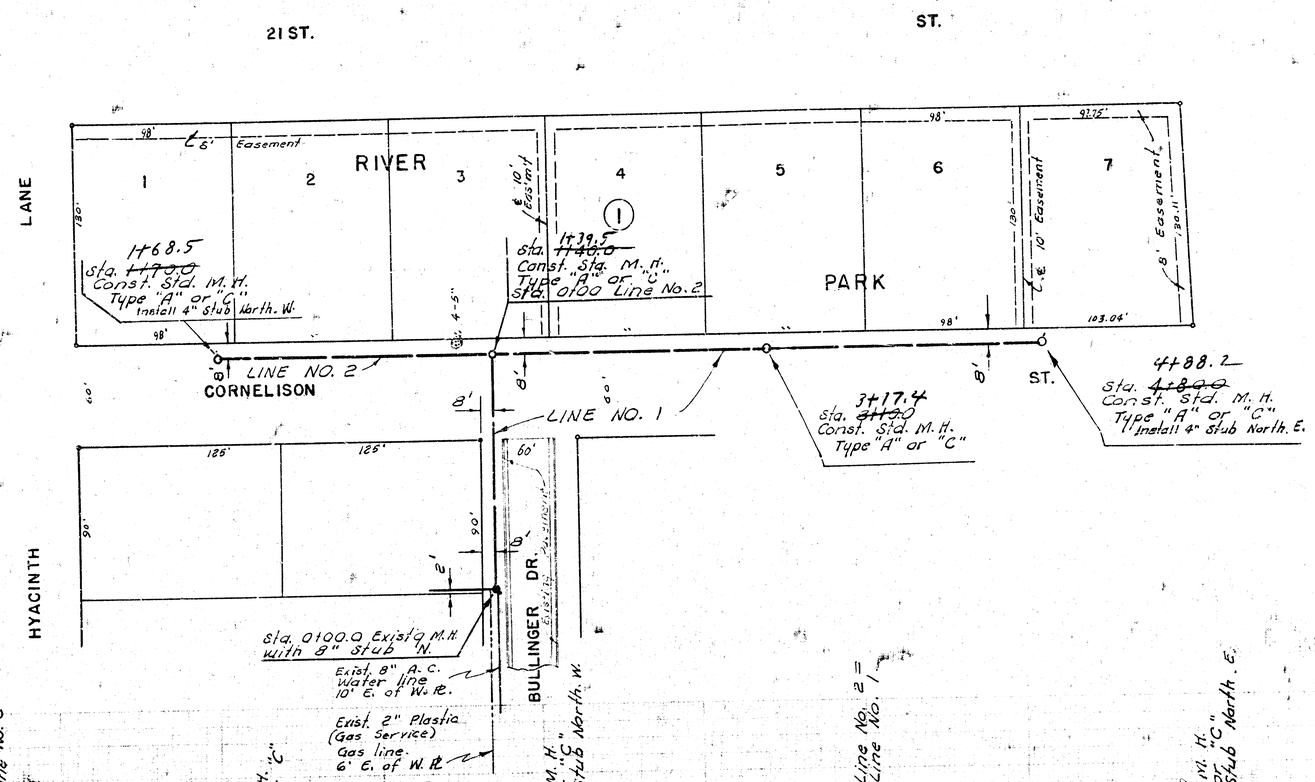


Plan Scale 1" = 40'
Profile Scale 1" = 40' Hor.
1" = 4' Ver.

As Built 9-9-75

LAT. 6, MAIN 19, S. S. NO. 22
CITY OF WICHITA, KANSAS
R. W. LINN — CITY ENGINEER
1975 PROJECT NO. DBKL564016