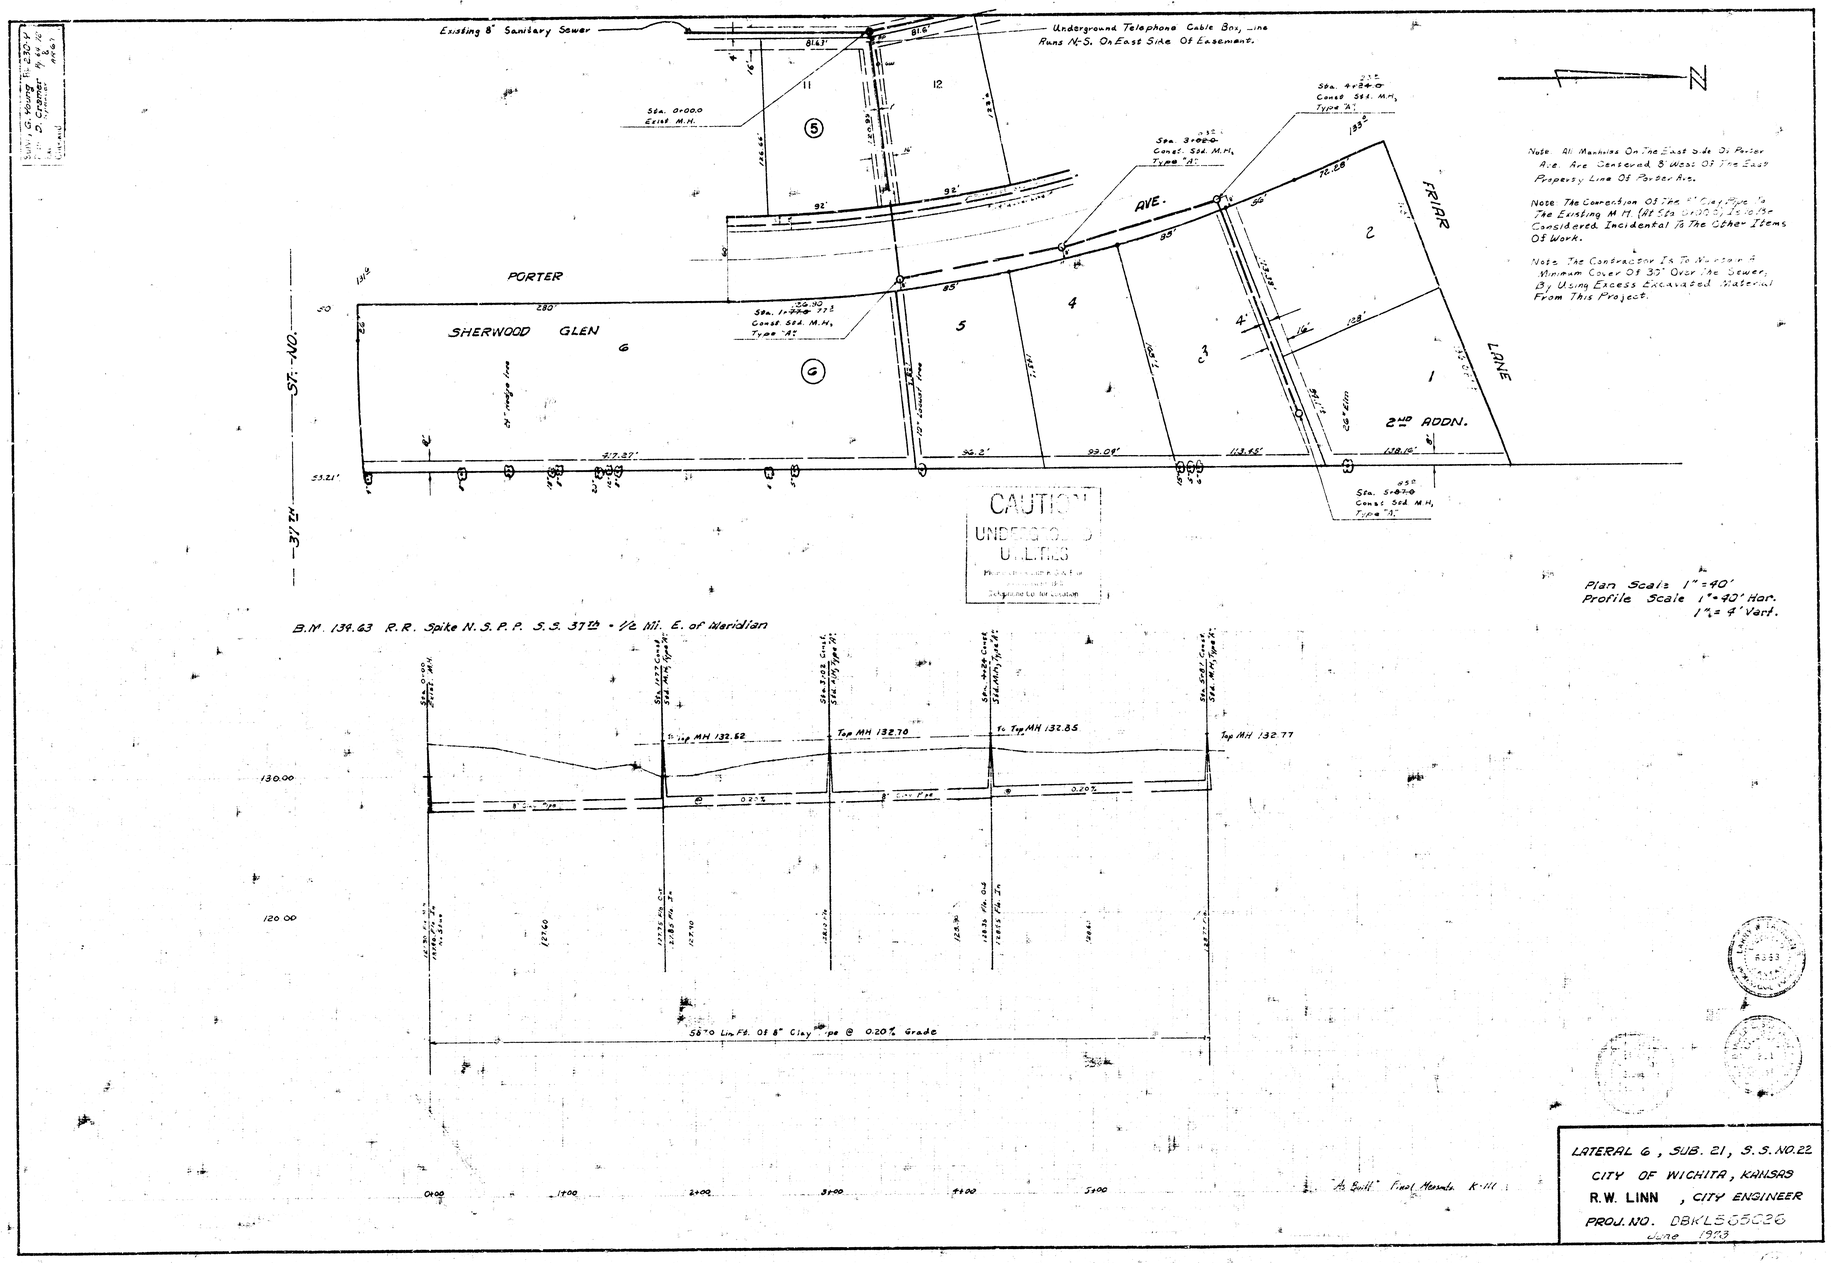

LATERAL 6, SUB. 21, S.S. NO. 22
CITY OF WICHITA, KANSAS
R.W. LINN, CITY ENGINEER
PROJ. NO. DBKLS05C28
June 1973