
3. M. 131.75 N. Rim M. H. in Woodrow Ave. north side of 37th St. No

B. M. 134.63 R. R. Spike N. S. P. P. S. S. 37th ~ ¼ mi E. of Meridian.

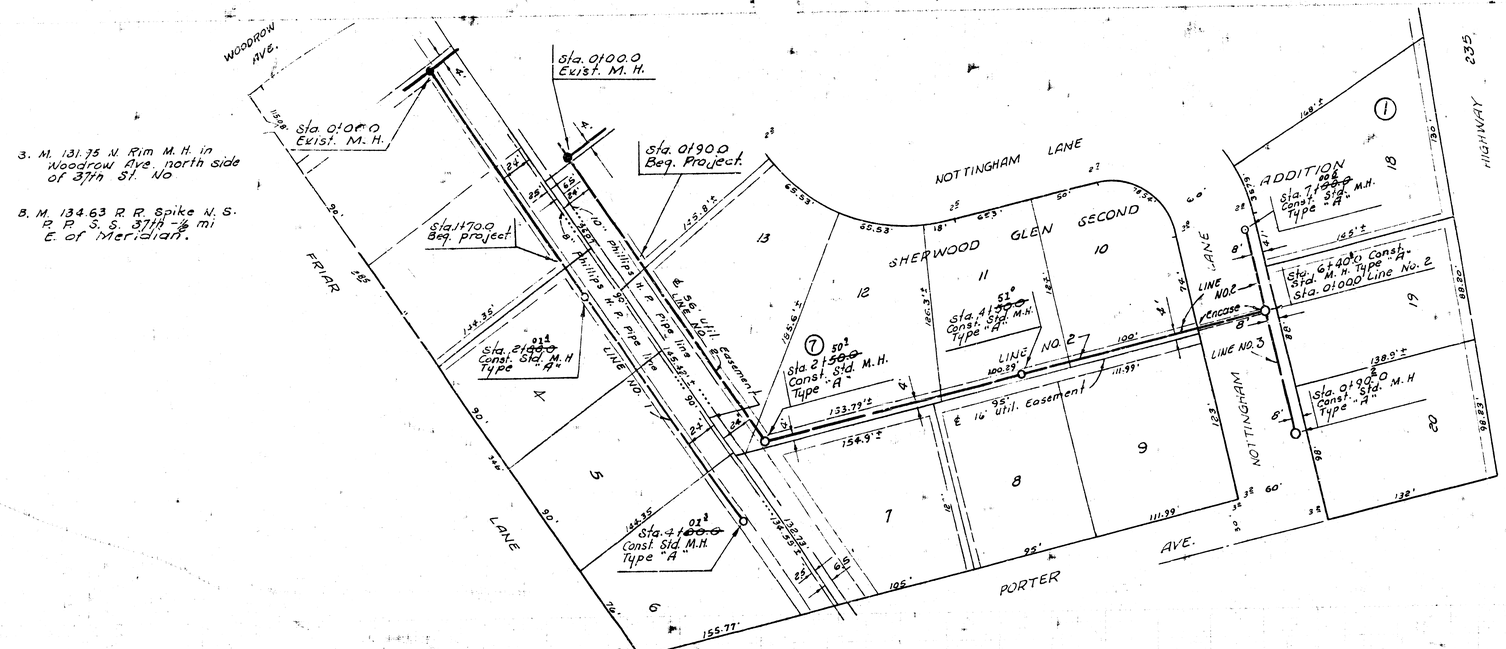

Plan Scale 1" = 40'
Profile Scale 1" = 40' Horz.
5' Vert

NOTE:
Contractor to provide a minimun of 30 inch cover over sanitary sewer.

AS BOOKED PER PLAN K-106

LAT. 7, SUBMAIN 21, S. S. NO. 22
CITY OF WICHITA, KANSAS
R. W. LINN — CITY ENGINEER
OCT. - 1973 PROJECT NO. DB-L 5 65027