

3. M. 131.75 N. Rim M.H. in Woodrow Ave. north side of 37th St. No.

8. M. 134.63 R. R. Spike N. S. P. P. S. S. 37th St. 1/2 mi. E. of Meridian.

Plan Scale 1" = 40'

Profile Scale 1" = 10' Horiz.

1" = 3' Vert.

NOTE:


Contractor to provide a minimum of 30 inch cover over sanitary sewer.

L.A.T. 7, SUBMAIN 21, S. S. NO. 22

CITY OF WICHITA, KANSAS

R. W. LINN — CITY ENGINEER

OCT. - 1973 PROJECT NO. DB-1565027

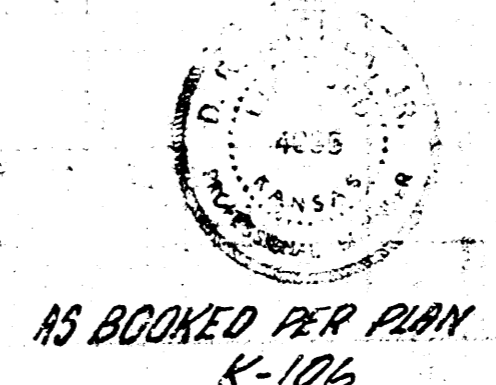

15 BOOKED PER PLAN K-106