
Survey G. Vaughn 230-4
Plan
Exc. D. Cramer
Check


B. M. 135.03. 60# Suiter E. S. R. P. W. S. Amidon @ S.L. 39th St. No. east.

B. M. 135.33 SE cor. Step No. # 3841 Friar Lane.

B. M. 131.95 N. Rim M. H. in Woodrow Ave. North Side of 37th St. North.

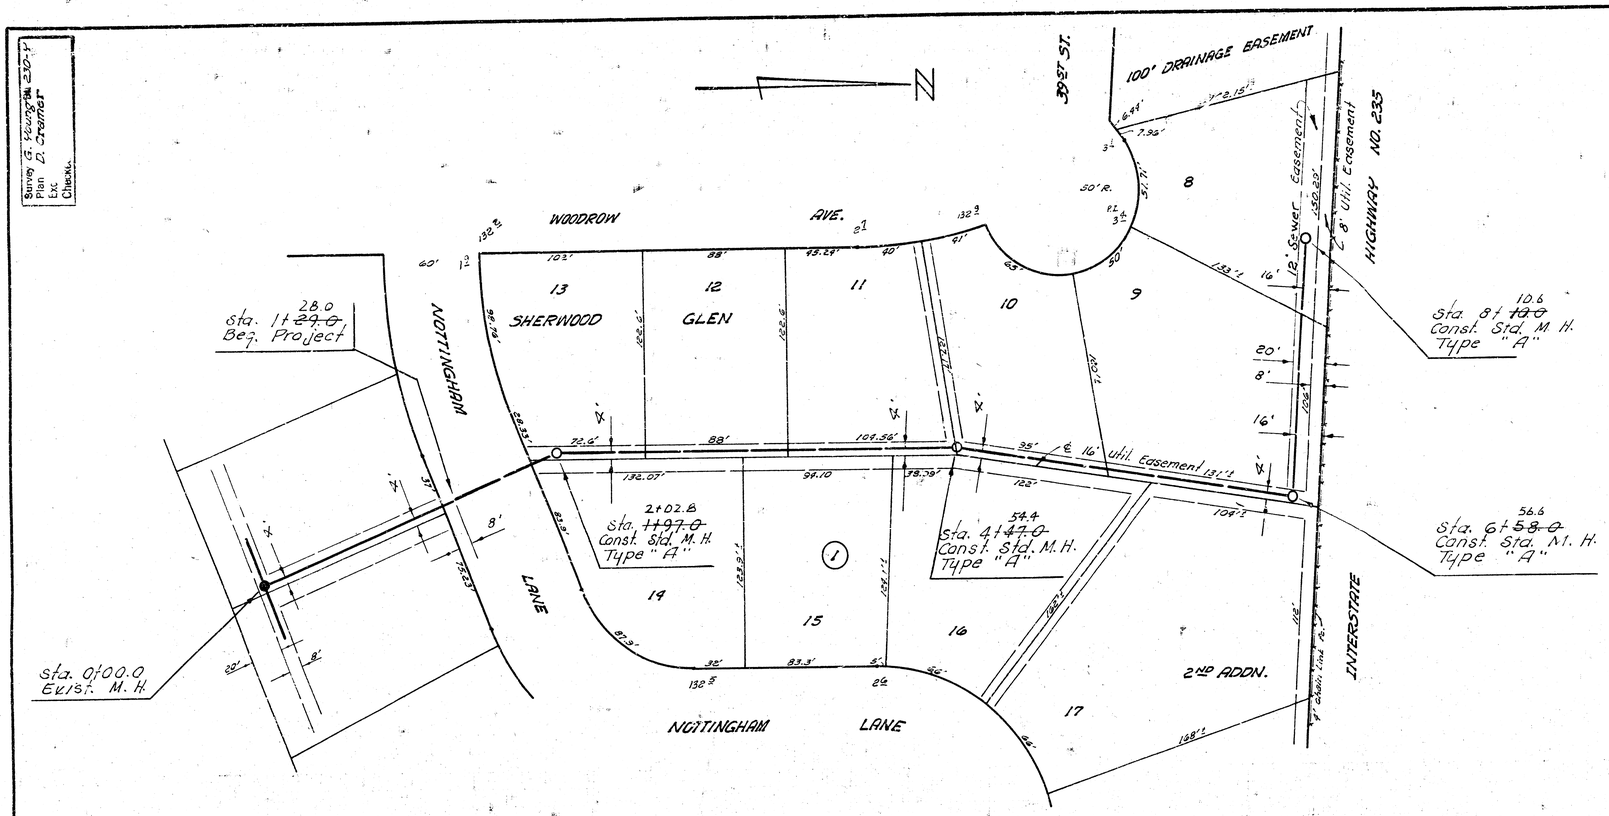

NOTE:
Contractor to construct fill over sewer as required to maintain a minimum of 30 inches of cover. All work necessary to provide a minimum of 30 inches of cover shall be considered as subsidiary.

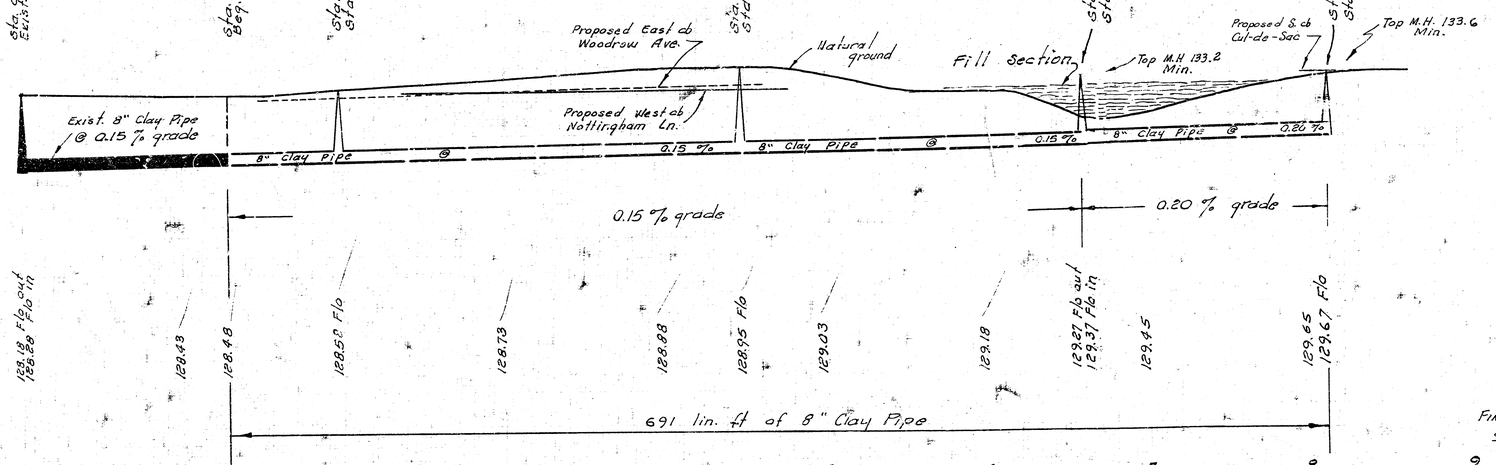

Plan Scale 1" = 90'
Profile Scale 1" = 90' Hor.
1" = 9' Vert.

"As Built"
FINAL MEASUREMENTS
SS J.K. '9

LATERAL 23, MAIN 21, S. S. NO. 22
CITY OF WICHITA, KANSAS
B. E. SMITH, CITY ENGINEER
PROJ. NO. DBKL571015
DATE: NOV. 1972

FILMED FROM THE BEST AVAILABLE COPY ····