
LATERAL 32 · MAIN 21 · S.S. NO. 22

468·76·245·80985·000·000·001

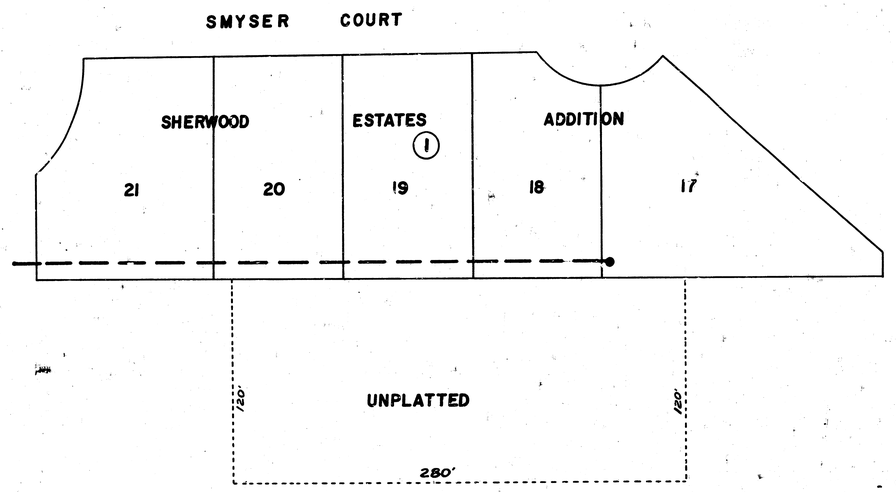

Improvement District Map

As Built
S.L.
9-84

ROBERT A. HARRINGTON LICENSED 9424 KANSAS PROFESSIONAL ENGINEER

CITY OF WICHITA
M. E. LINDEBAK CITY ENGINEER
LANDCO ENGINEERING CONSULTANT ENGINEER


1/2

FILMED FROM THE BEST AVAILABLE COPY

B.M. Elevation 132.90 "⊟" Cut on TC S-end Return SE-corner Smyser Ave. & Smyser Ct.

N

Scale Plan 1" = 40'
Profile 1" = 40' Horizontal
1" = 5' Vertical

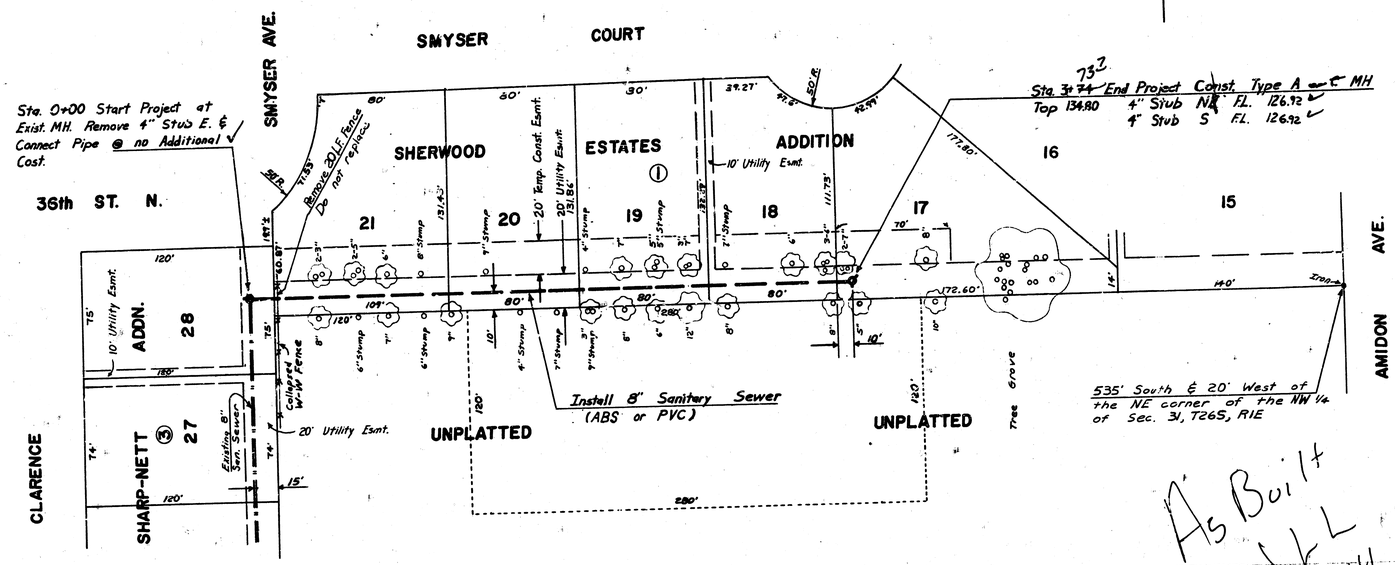

General Notes

1) All Block Corners, Control Points and Property Irons Shown on Plans Will be Protected. If Removed During Construction, Contractor will have them Replaced By a Licensed Engineer or Land Surveyor at his Expense.

2) Trees within Utility Esm't or Temporary Construction Esm't may be Removed at Contractor's Convenience. Cost of Tree Removal shall not be paid for Directly, but shall be Incidental to the Other Pay Items of Work

As Built
LL
2-84

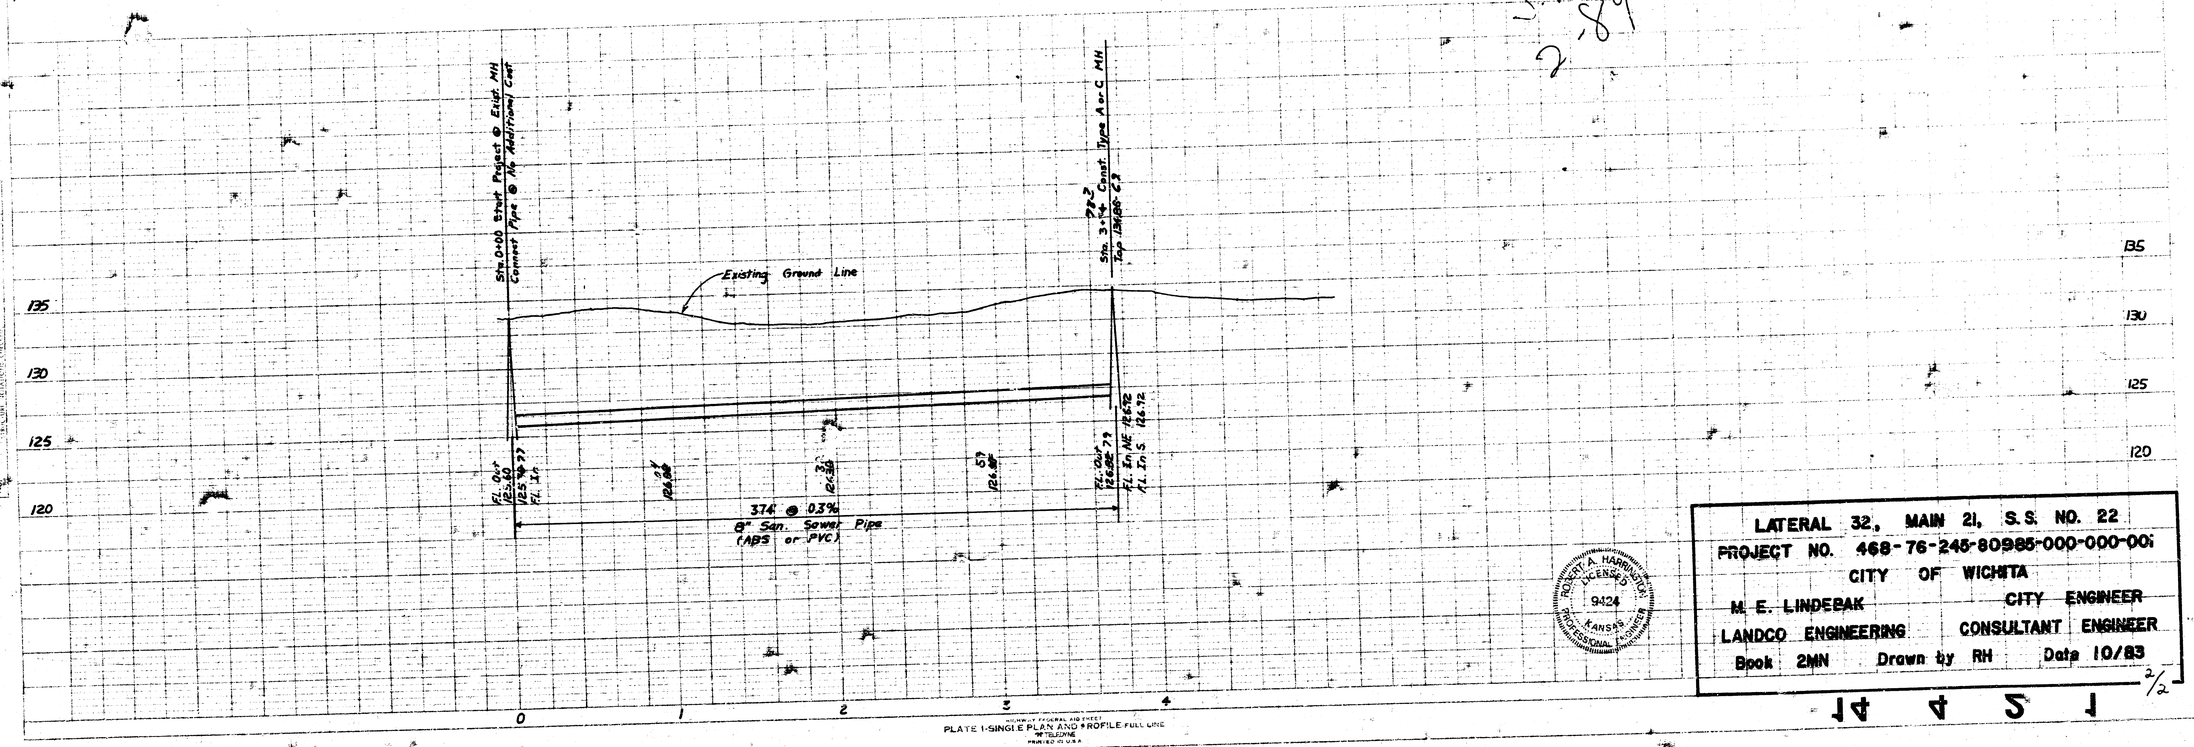


PLATE 1-SINGLE PLAN AND PROFILE FULL LINE

LATERAL 32, MAIN 21, S.S. NO. 22
PROJECT NO. 468-76-245-80985-000-000-001
CITY OF WICHITA
M. E. LINDEBAK CITY ENGINEER
LANDCO ENGINEERING CONSULTANT ENGINEER
Book 2MN Drawn by RH Date 10/83

ROBERT A. HARRINGTON LICENSED 9424 KANSAS PROFESSIONAL ENGINEER

FILMED FROM THE BEST AVAILABLE COPY...