

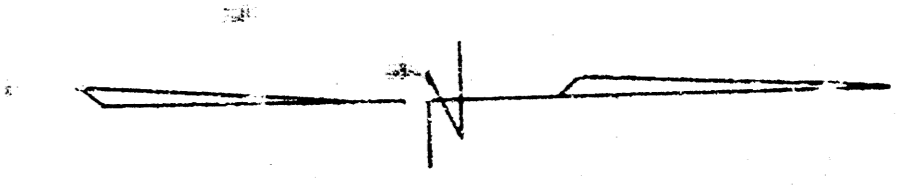


B.M. 98.51 "D" top of curb North-return
 N.E. corner 33rd St. So. & Leonine
 B.M. 100.68 "D" top of curb East-return
 S.E. corner 31st St. So. & Kessler
 B.M. 103.75 City Std. disc 52"E. & 93"N.
 of E of 31st St. So. & West St.




R.L.K. 217
 R. Loomis

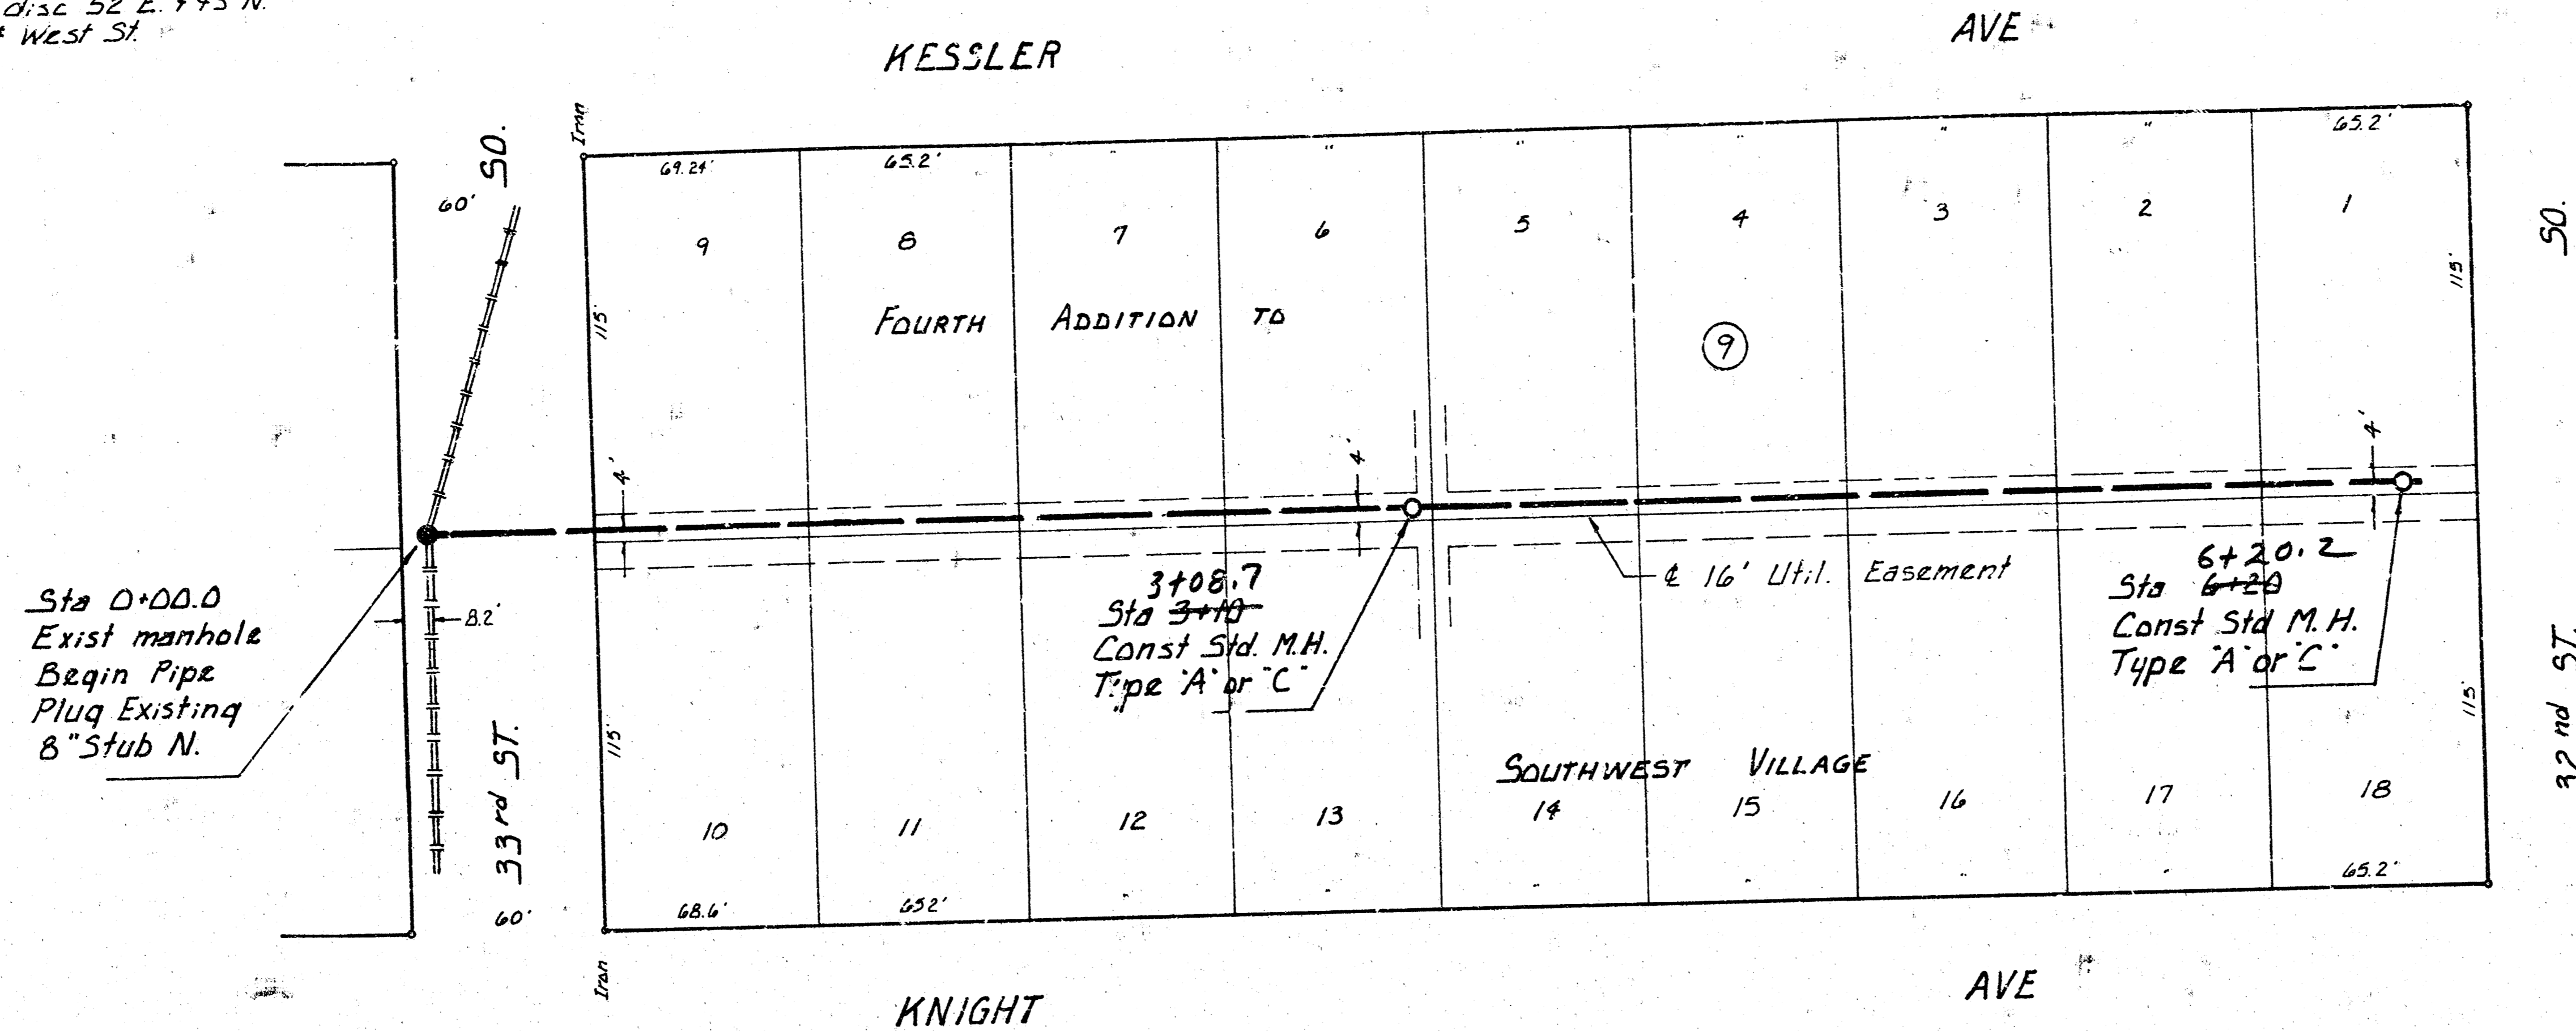

Plan Scale 1" = 40'
 Profile Scale 1" = 4' Horiz.
 1" = 5' Vert.

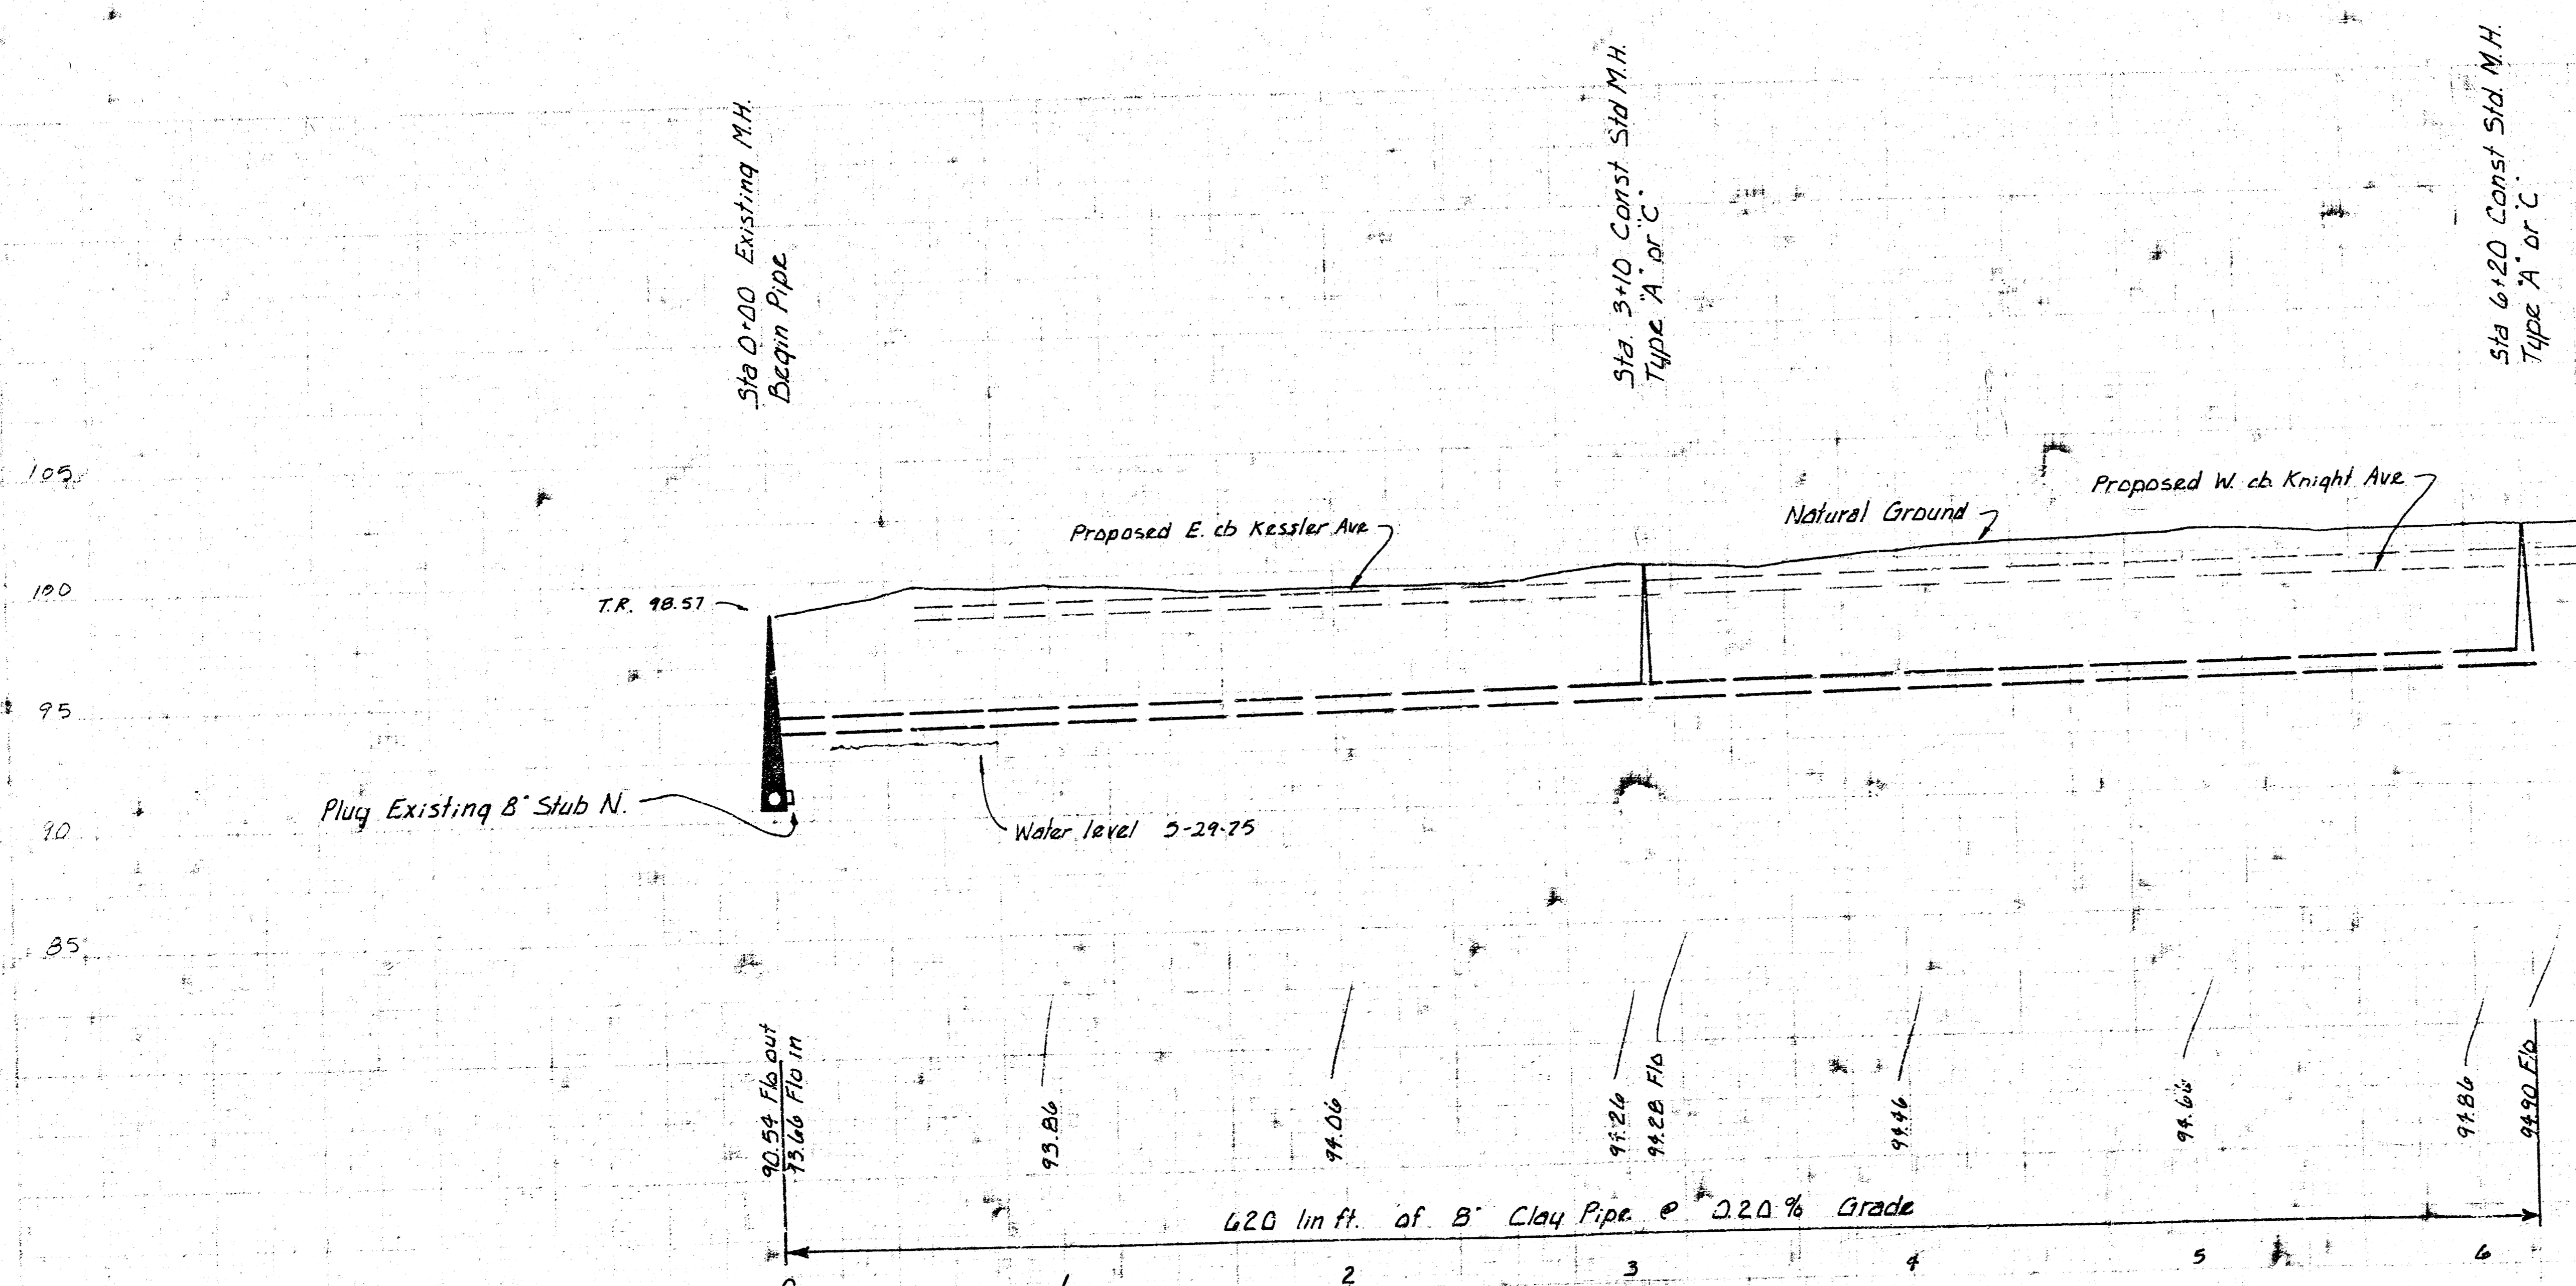

LAT. 3, MAIN 23, S.S. NO 22
 CITY OF WICHITA, KANSAS
 R. W. LINN — CITY ENGINEER
 PROJECT NO. DBKL574101 1/2

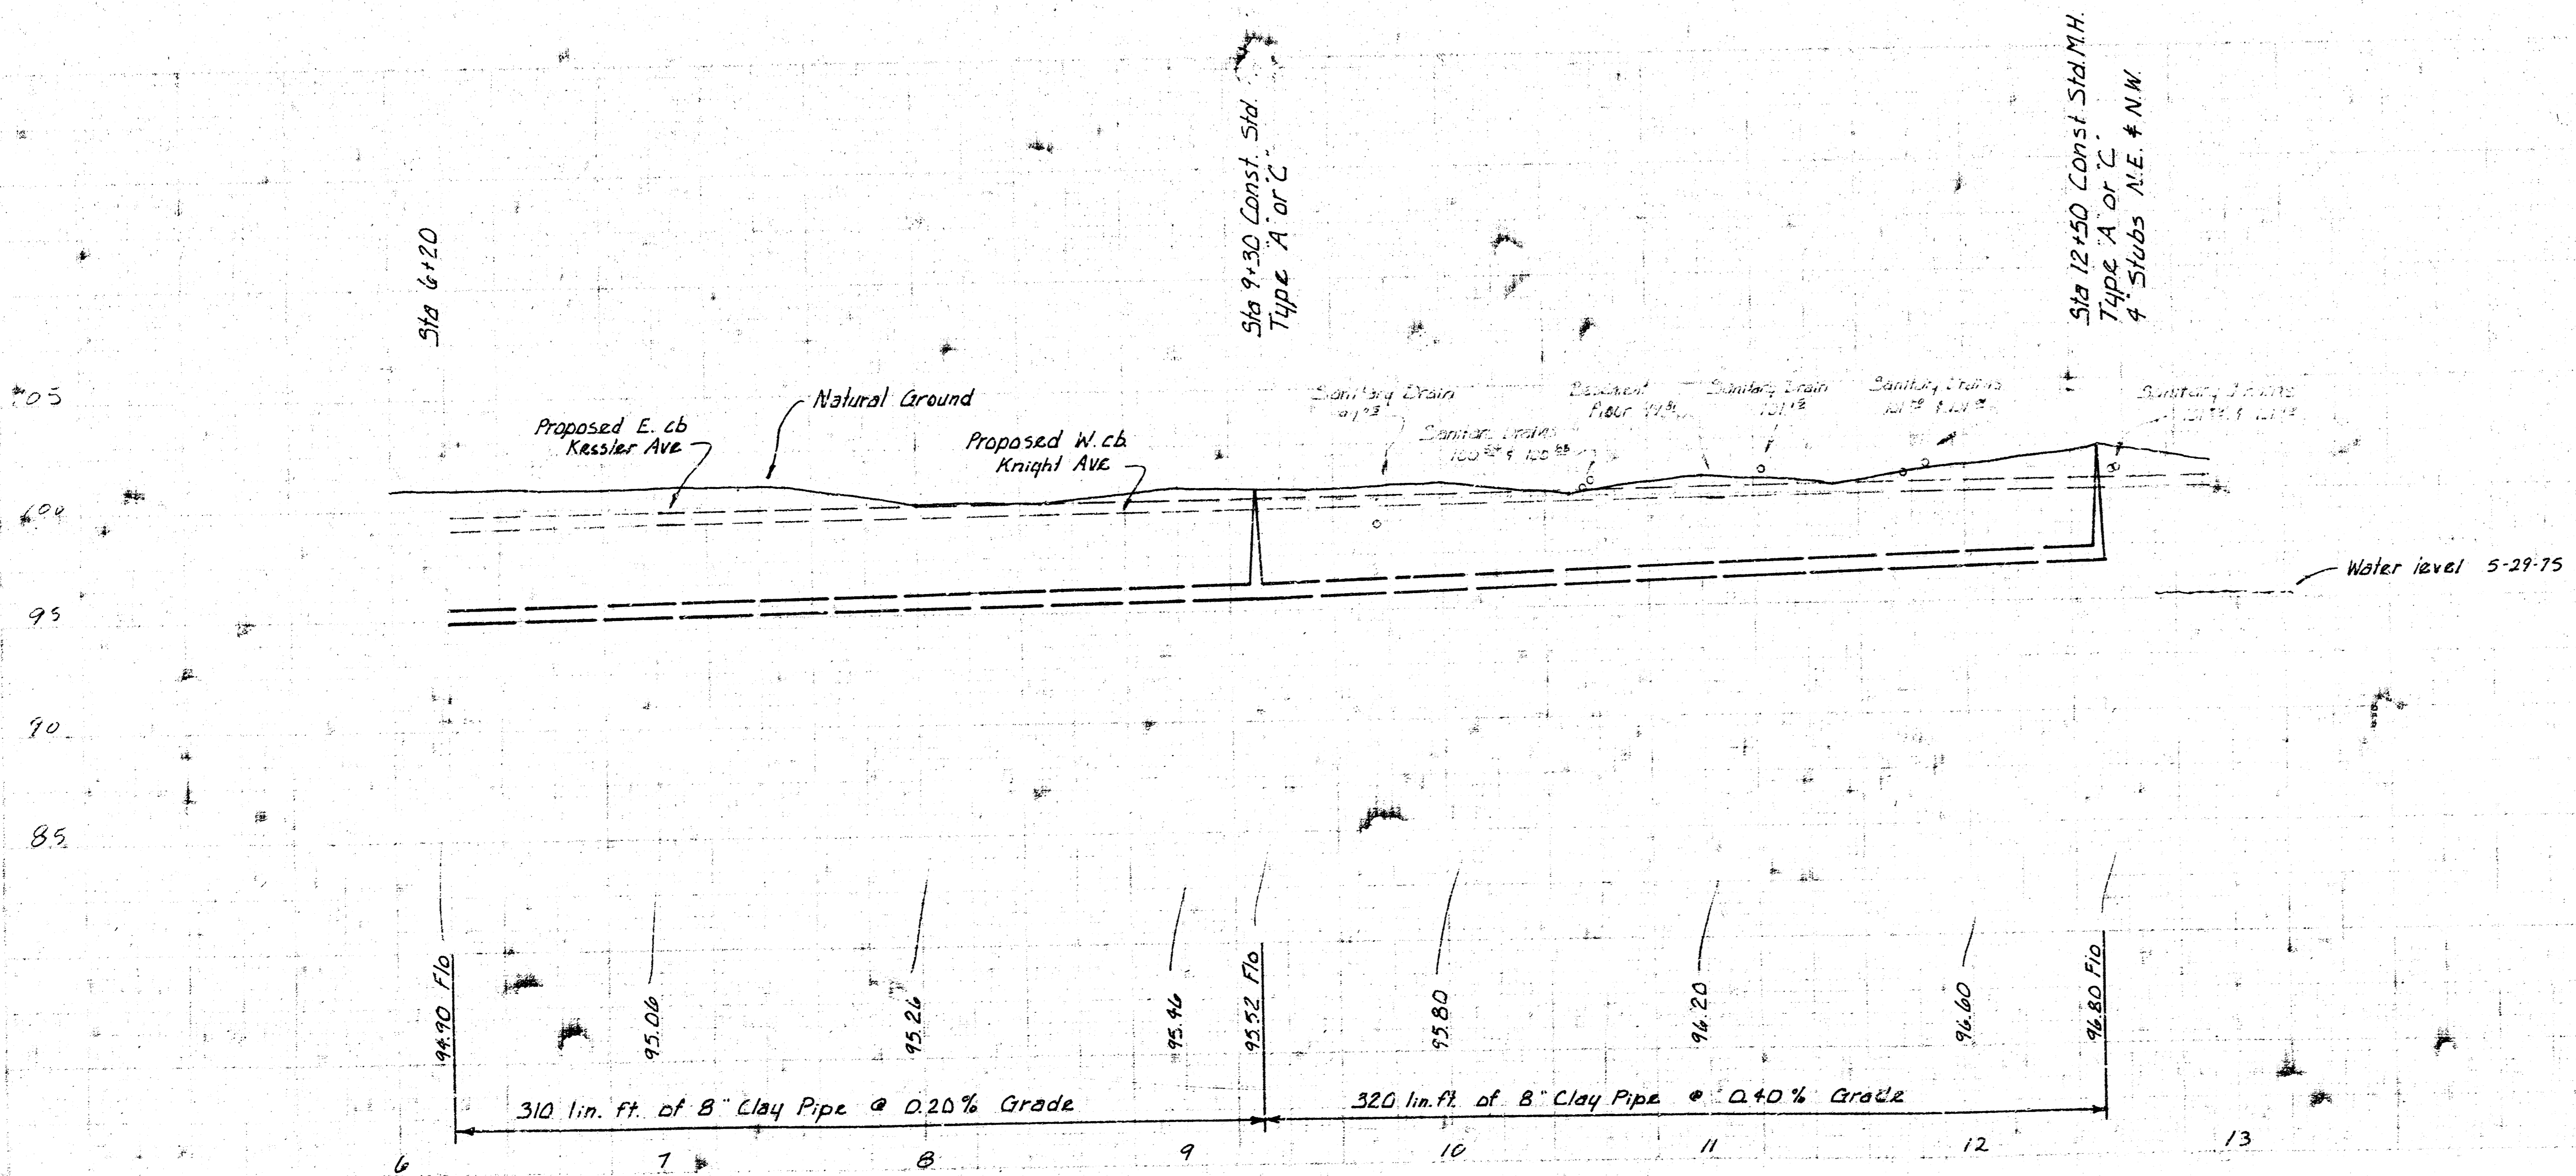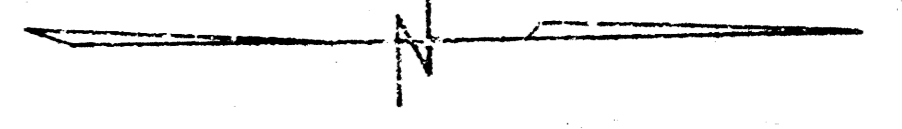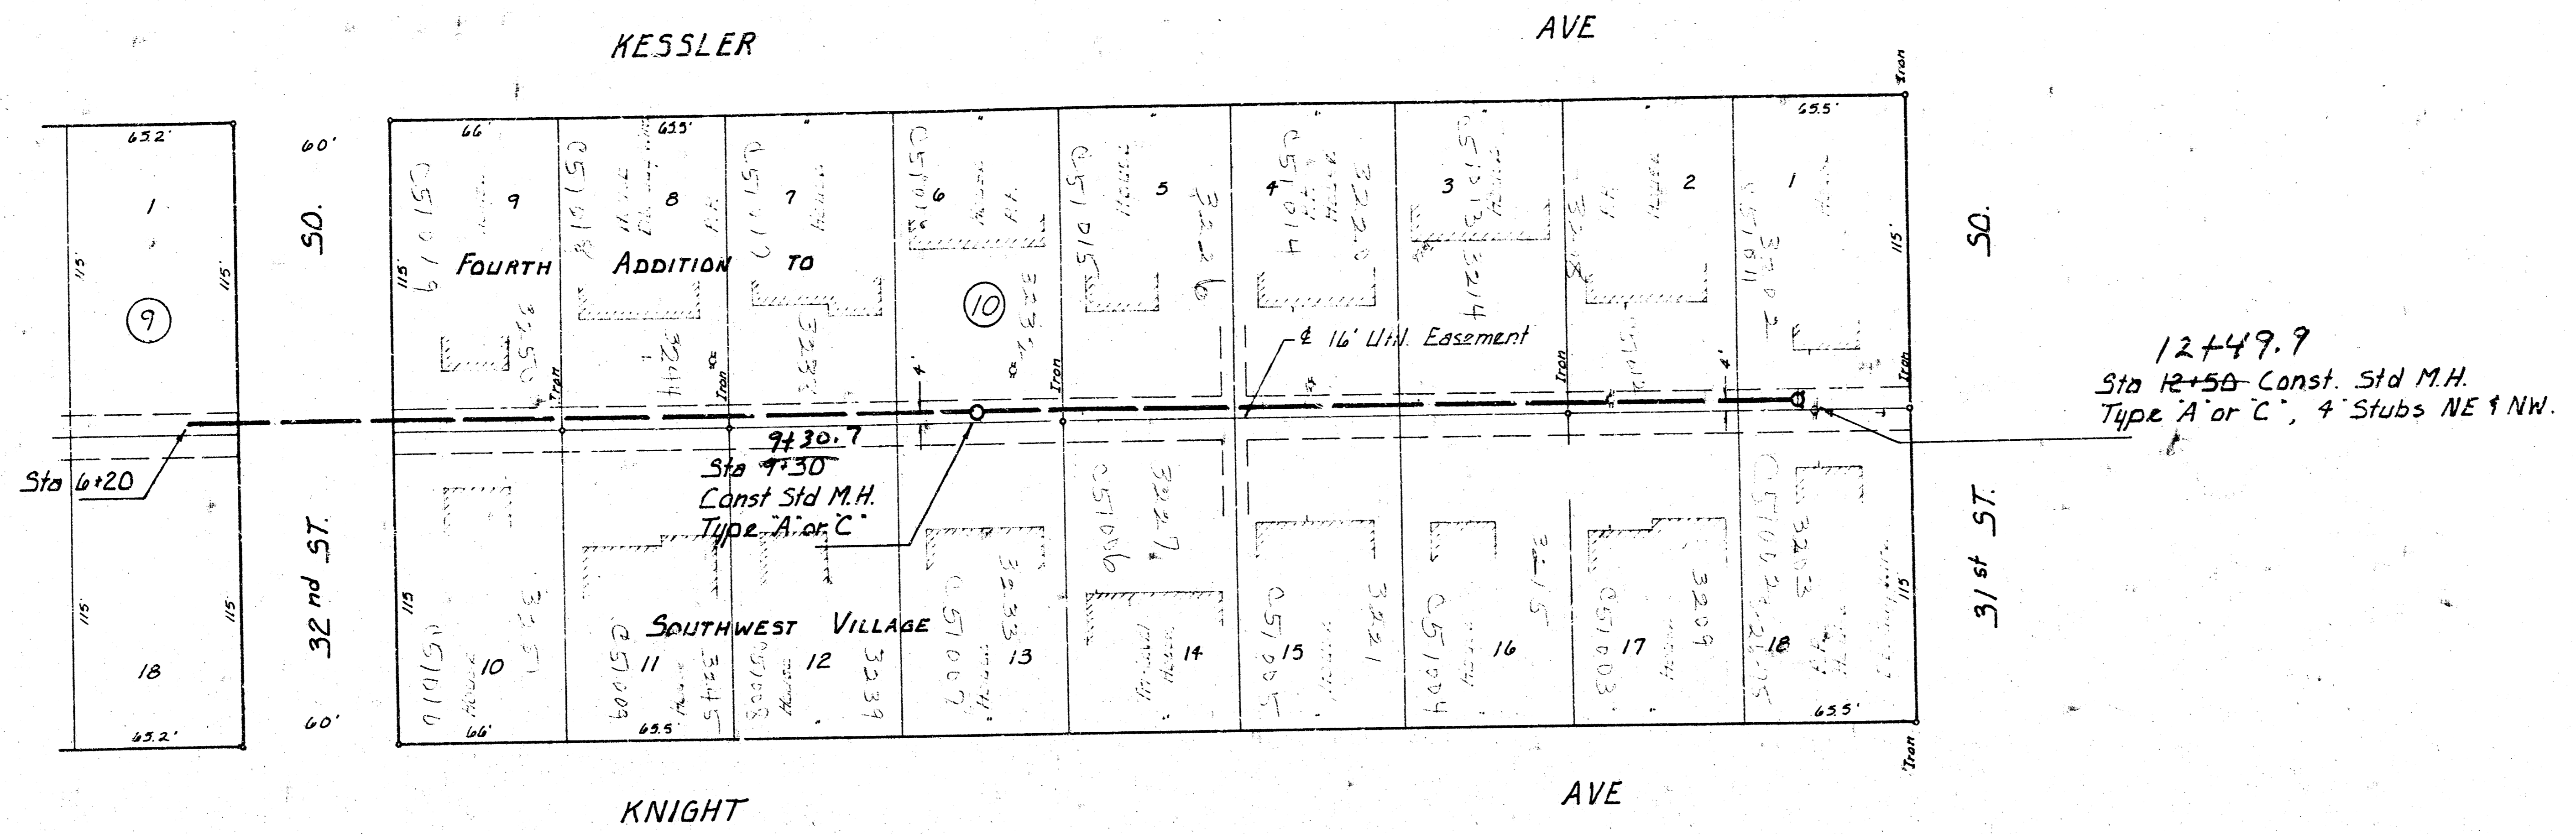

LAT 3, MAIN 23, S.S. NO. 22
PROJECT NO. DBKL574101 2/2

14 8 1 12