



Scale Plan 1" = 40'  
 Profile 1" = 40' Horiz.  
 1" = 5' Vert.





NOTE: FIELD ENGINEER SHALL SET TOPS OF MANHOLES TO MATCH PROPOSED FINISHED GRADE AS DETERMINED BY THE DEVELOPER. RISERS AND ADDITIONAL CROSS SHALL BE INSTALLED ON THIS PROJECT TO SERVE INDIVIDUAL LOTS WITH CHANGES TO THE FIELD ENGINEER. RISER CONSTRUCTION SHALL CONFORM TO THE REQUIREMENTS AS SHOWN IN STANDARD SPECIFICATIONS. LOCATIONS OF THE LIDS OF THE RISERS SHALL BE MARKED BY FASTENED ORANGE PLASTIC CONELED TAPS TO THE TOP OF THE ALIEN AND GRADED TO THE GROUND SURFACE AS THE EXCAVATION IS BACKFILLED SO THAT THE CONELED TAP WILL BE VISIBLE WHEN THE PROJECT IS COMPLETED. ALL RISERS SHALL BE CONSTRUCTED USING S.D.R. 23.5 A.B.S. OR P.V.C. PIPE. ELEVATIONS OF STUBS AND TOPS OF RISERS SHALL BE SUCH THAT ALL FACILITATE CONNECTION OF BASINENT DRAINS WHEN THESE LOTS ARE DEVELOPED.

B.M. 103.47 City Std. Disc 53' E. & 44' S. of Q's 31st St. S. & West St.

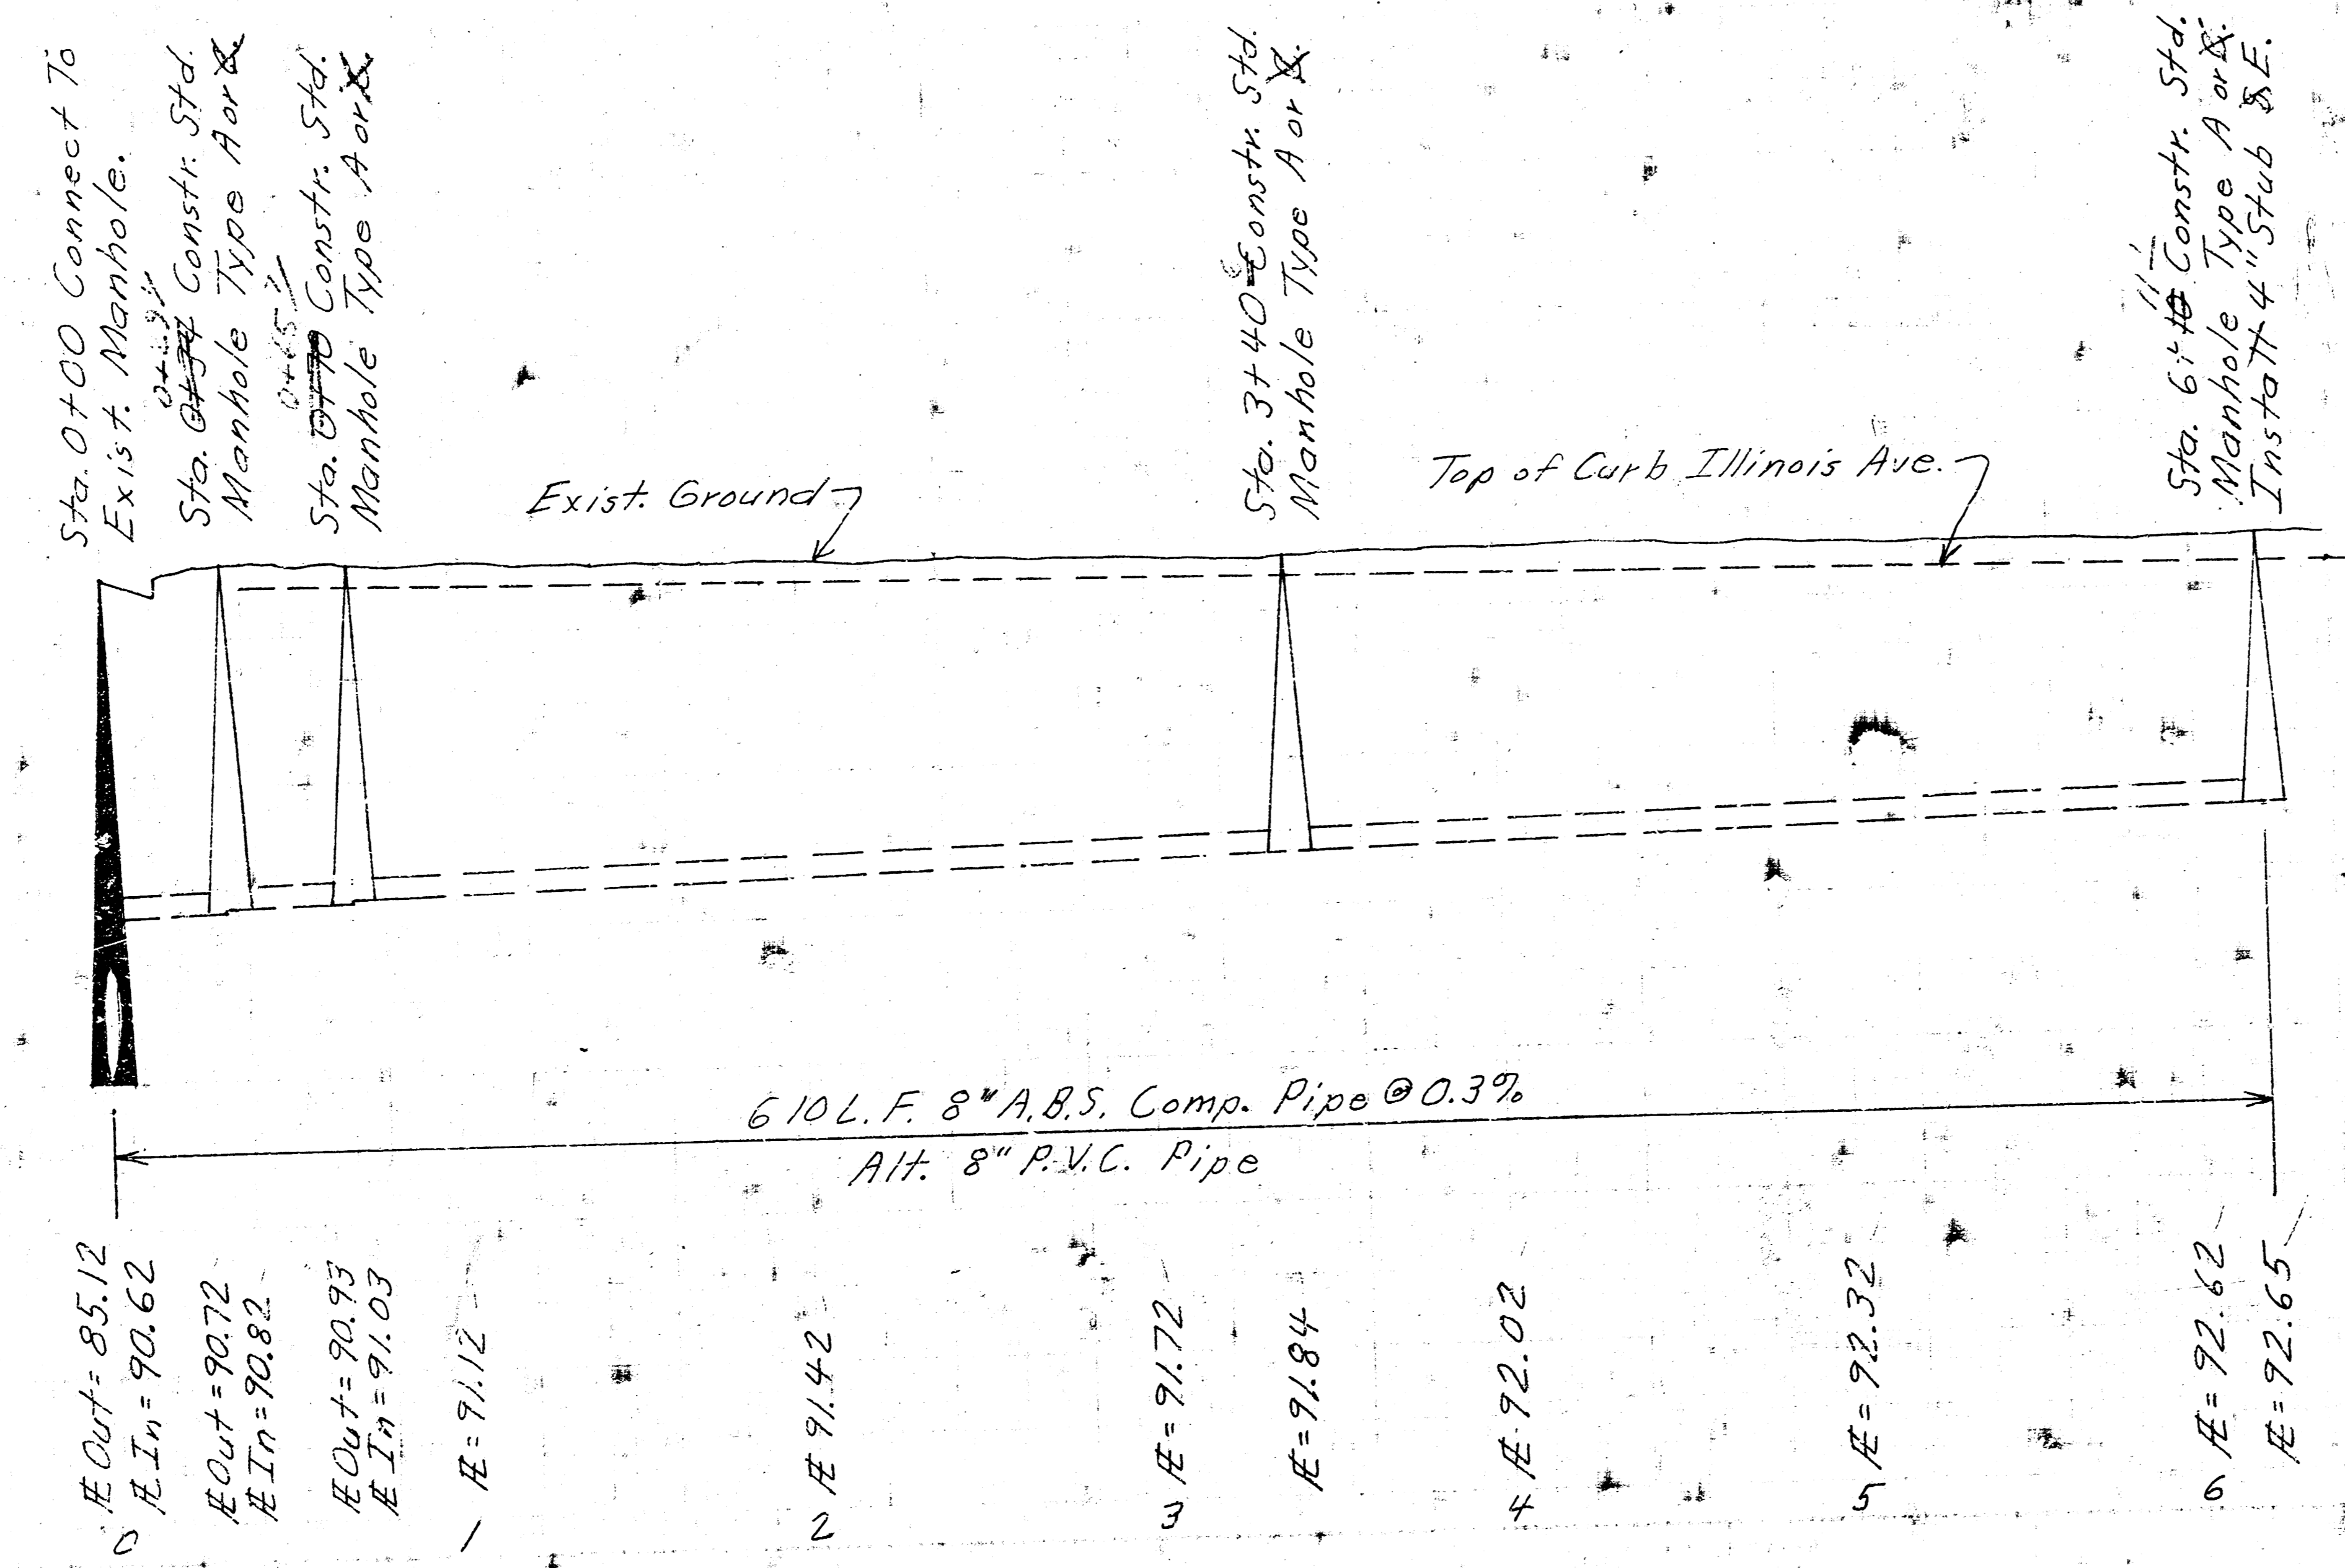

Lat. 6, Main 23, S.S. # 22  
 City of Wichita, Kansas  
 Dean Sellers - Acting City Engineer  
 Proj. # 468-76-245-80190-000-001  
 Sht. # 1 of 2

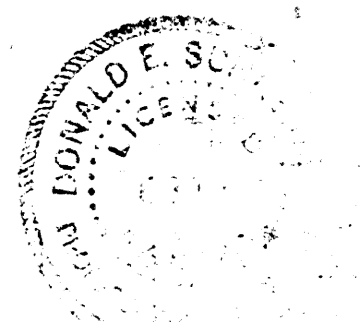

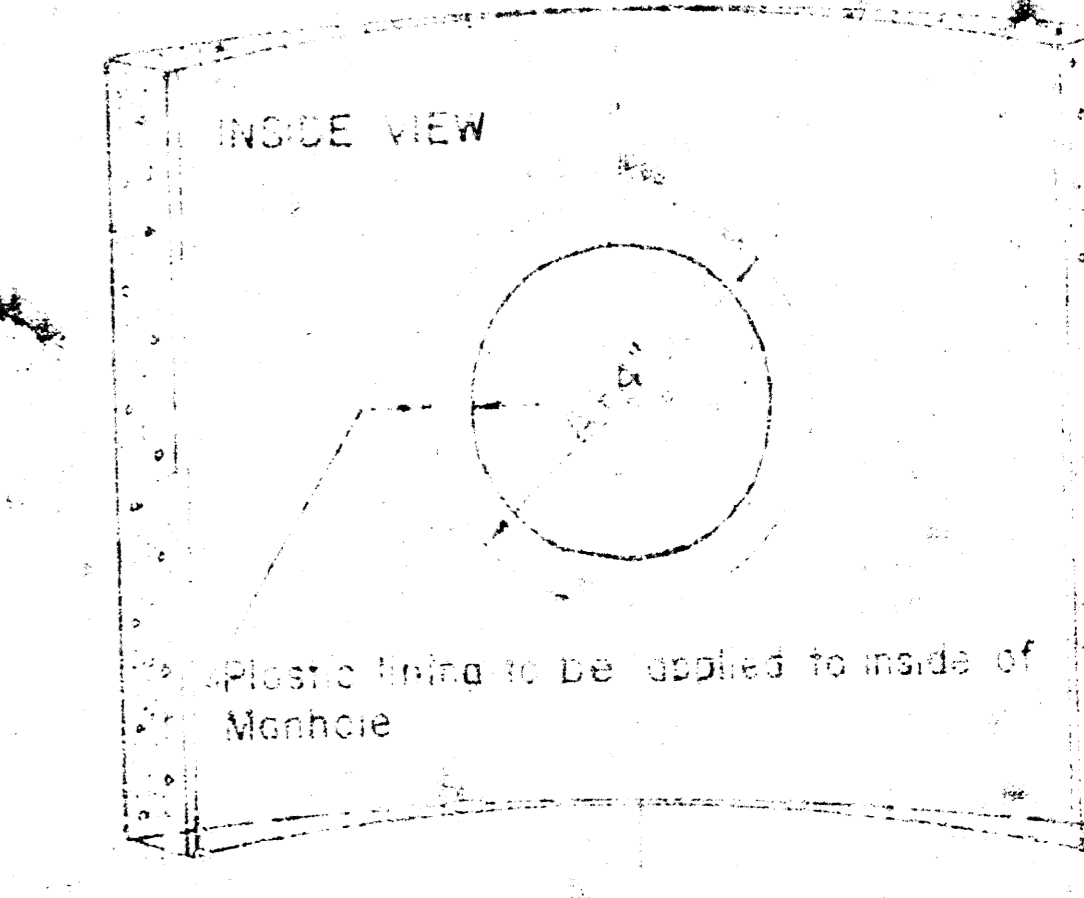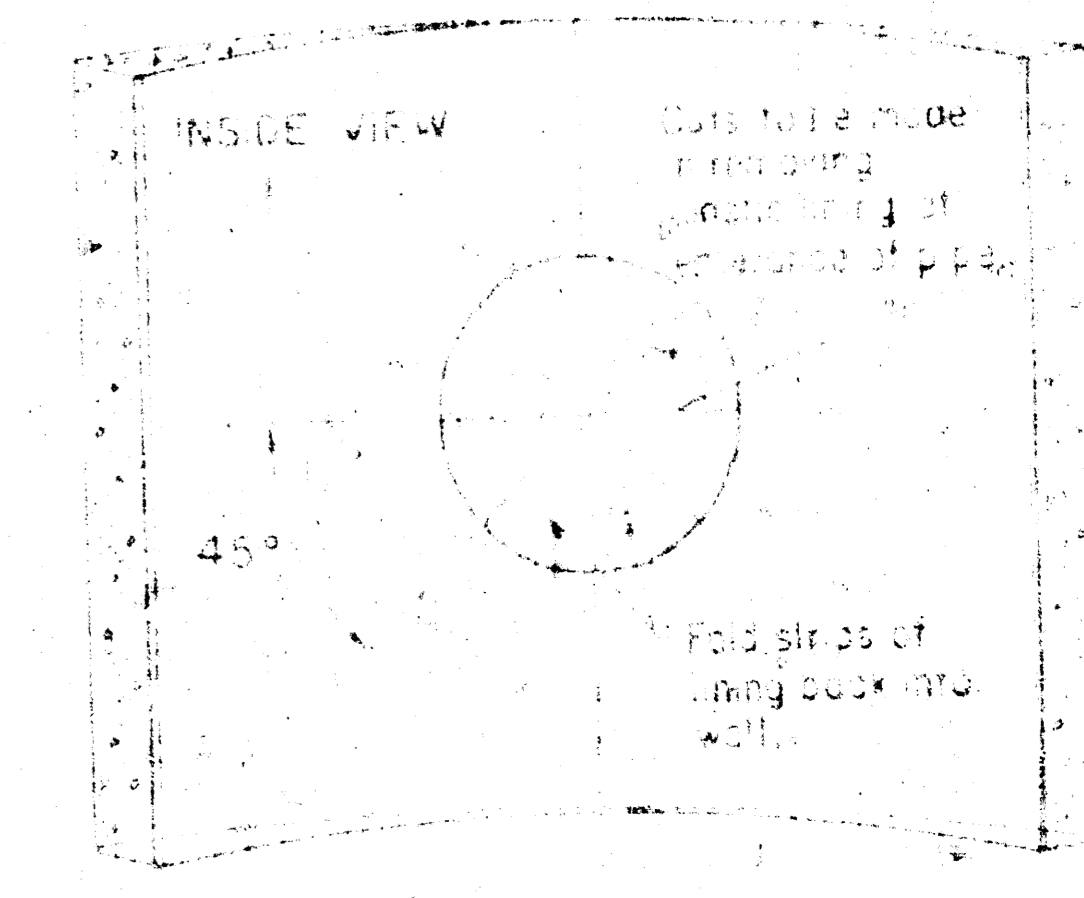 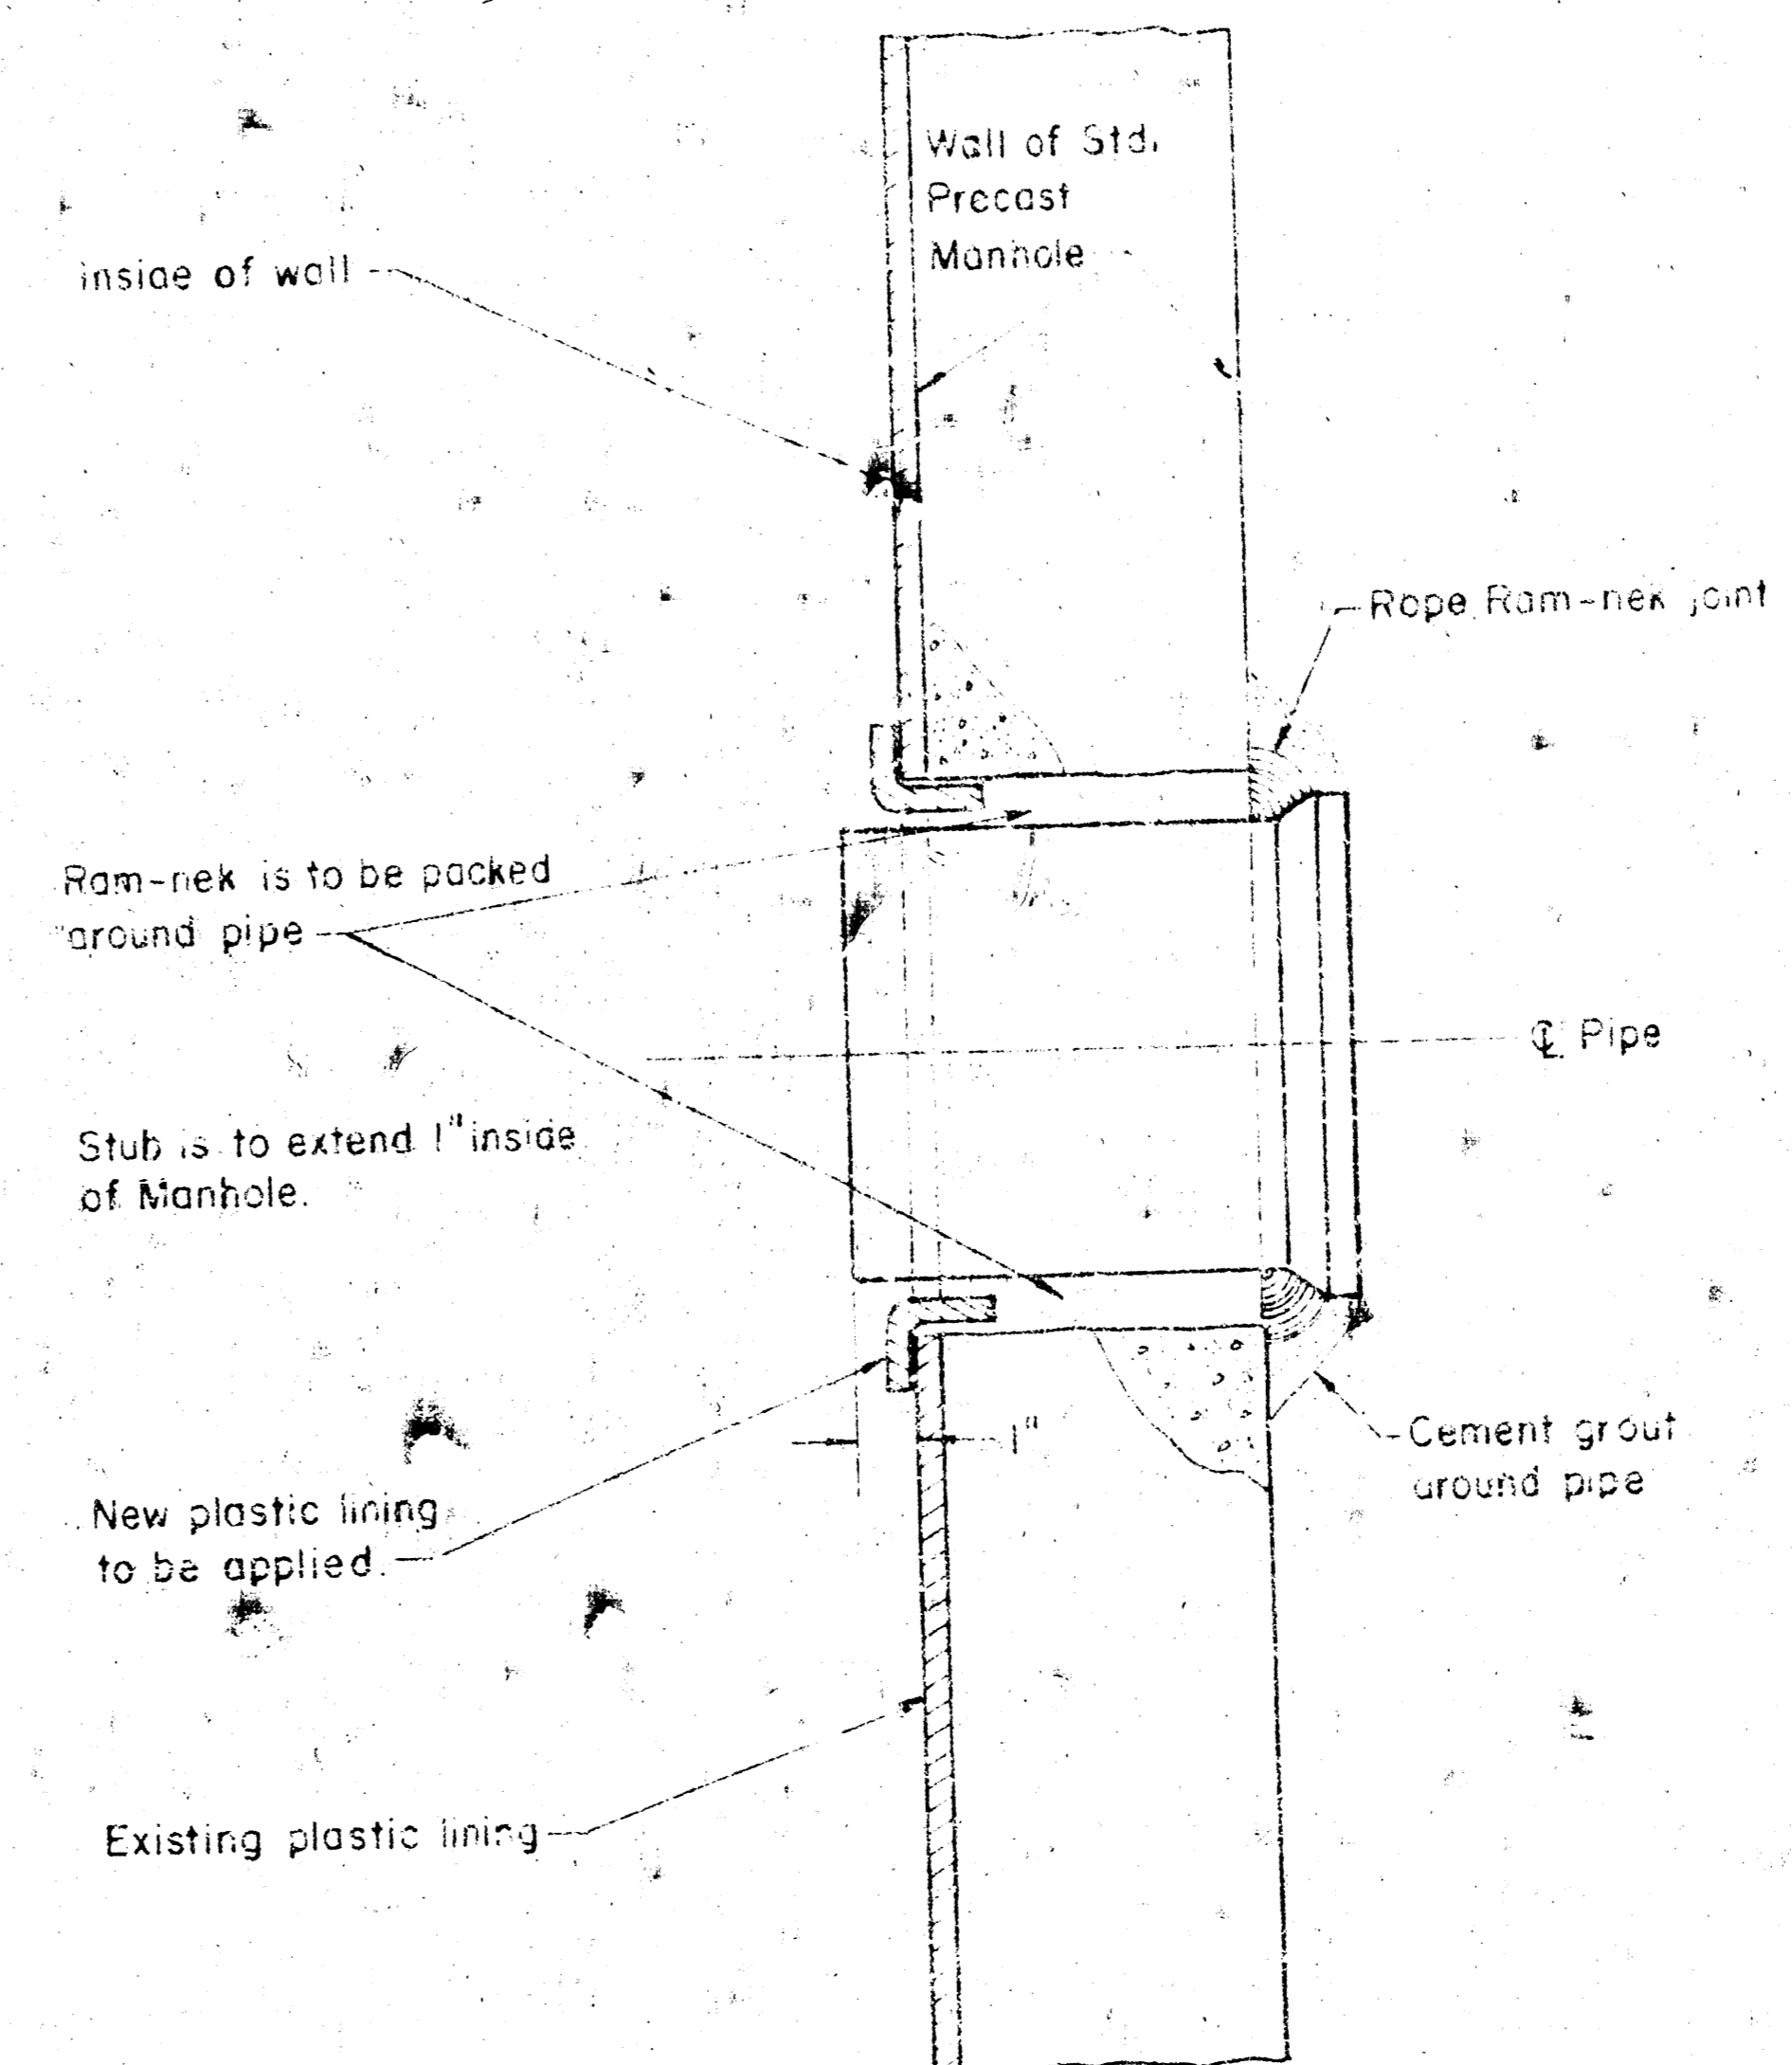

A = OUTSIDE DIAMETER OF PIPE + 2"

DRAWN: Oct 1975  
 DETAIL OF PIPE CONNECTION  
 TO STRUCTURAL TEE MANHOLE  
 CITY OF WICHITA, KANSAS  
 R.W. LINN CITY ENGINEER  
 PROJECT NUMBER: \_\_\_\_\_  
 DATE: \_\_\_\_\_  
 5/17/75 #2 of 2

10 8 3 8