


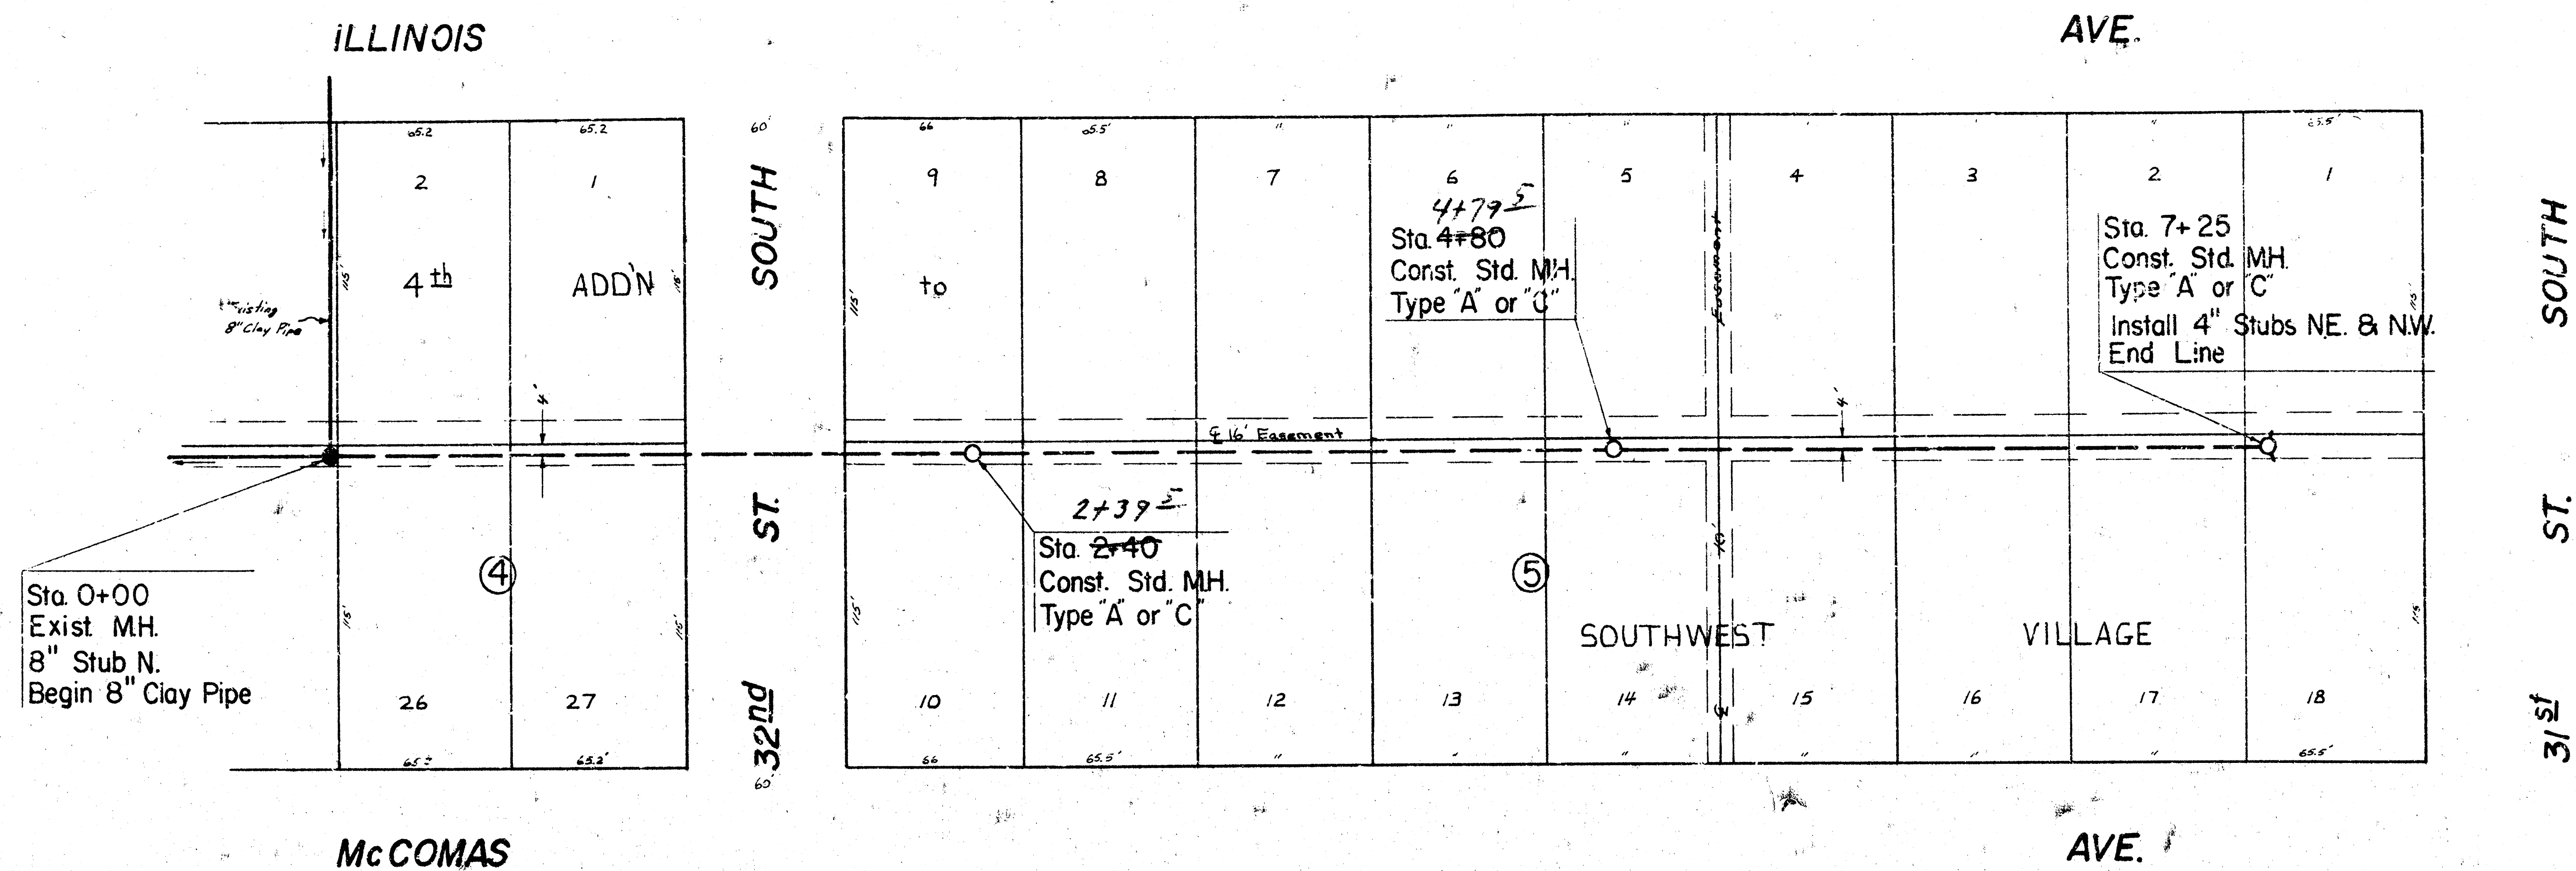

BM 100.68 " + " on top of curb at the east end of return SE corner of Kessler Ave. and 31st St. South

