


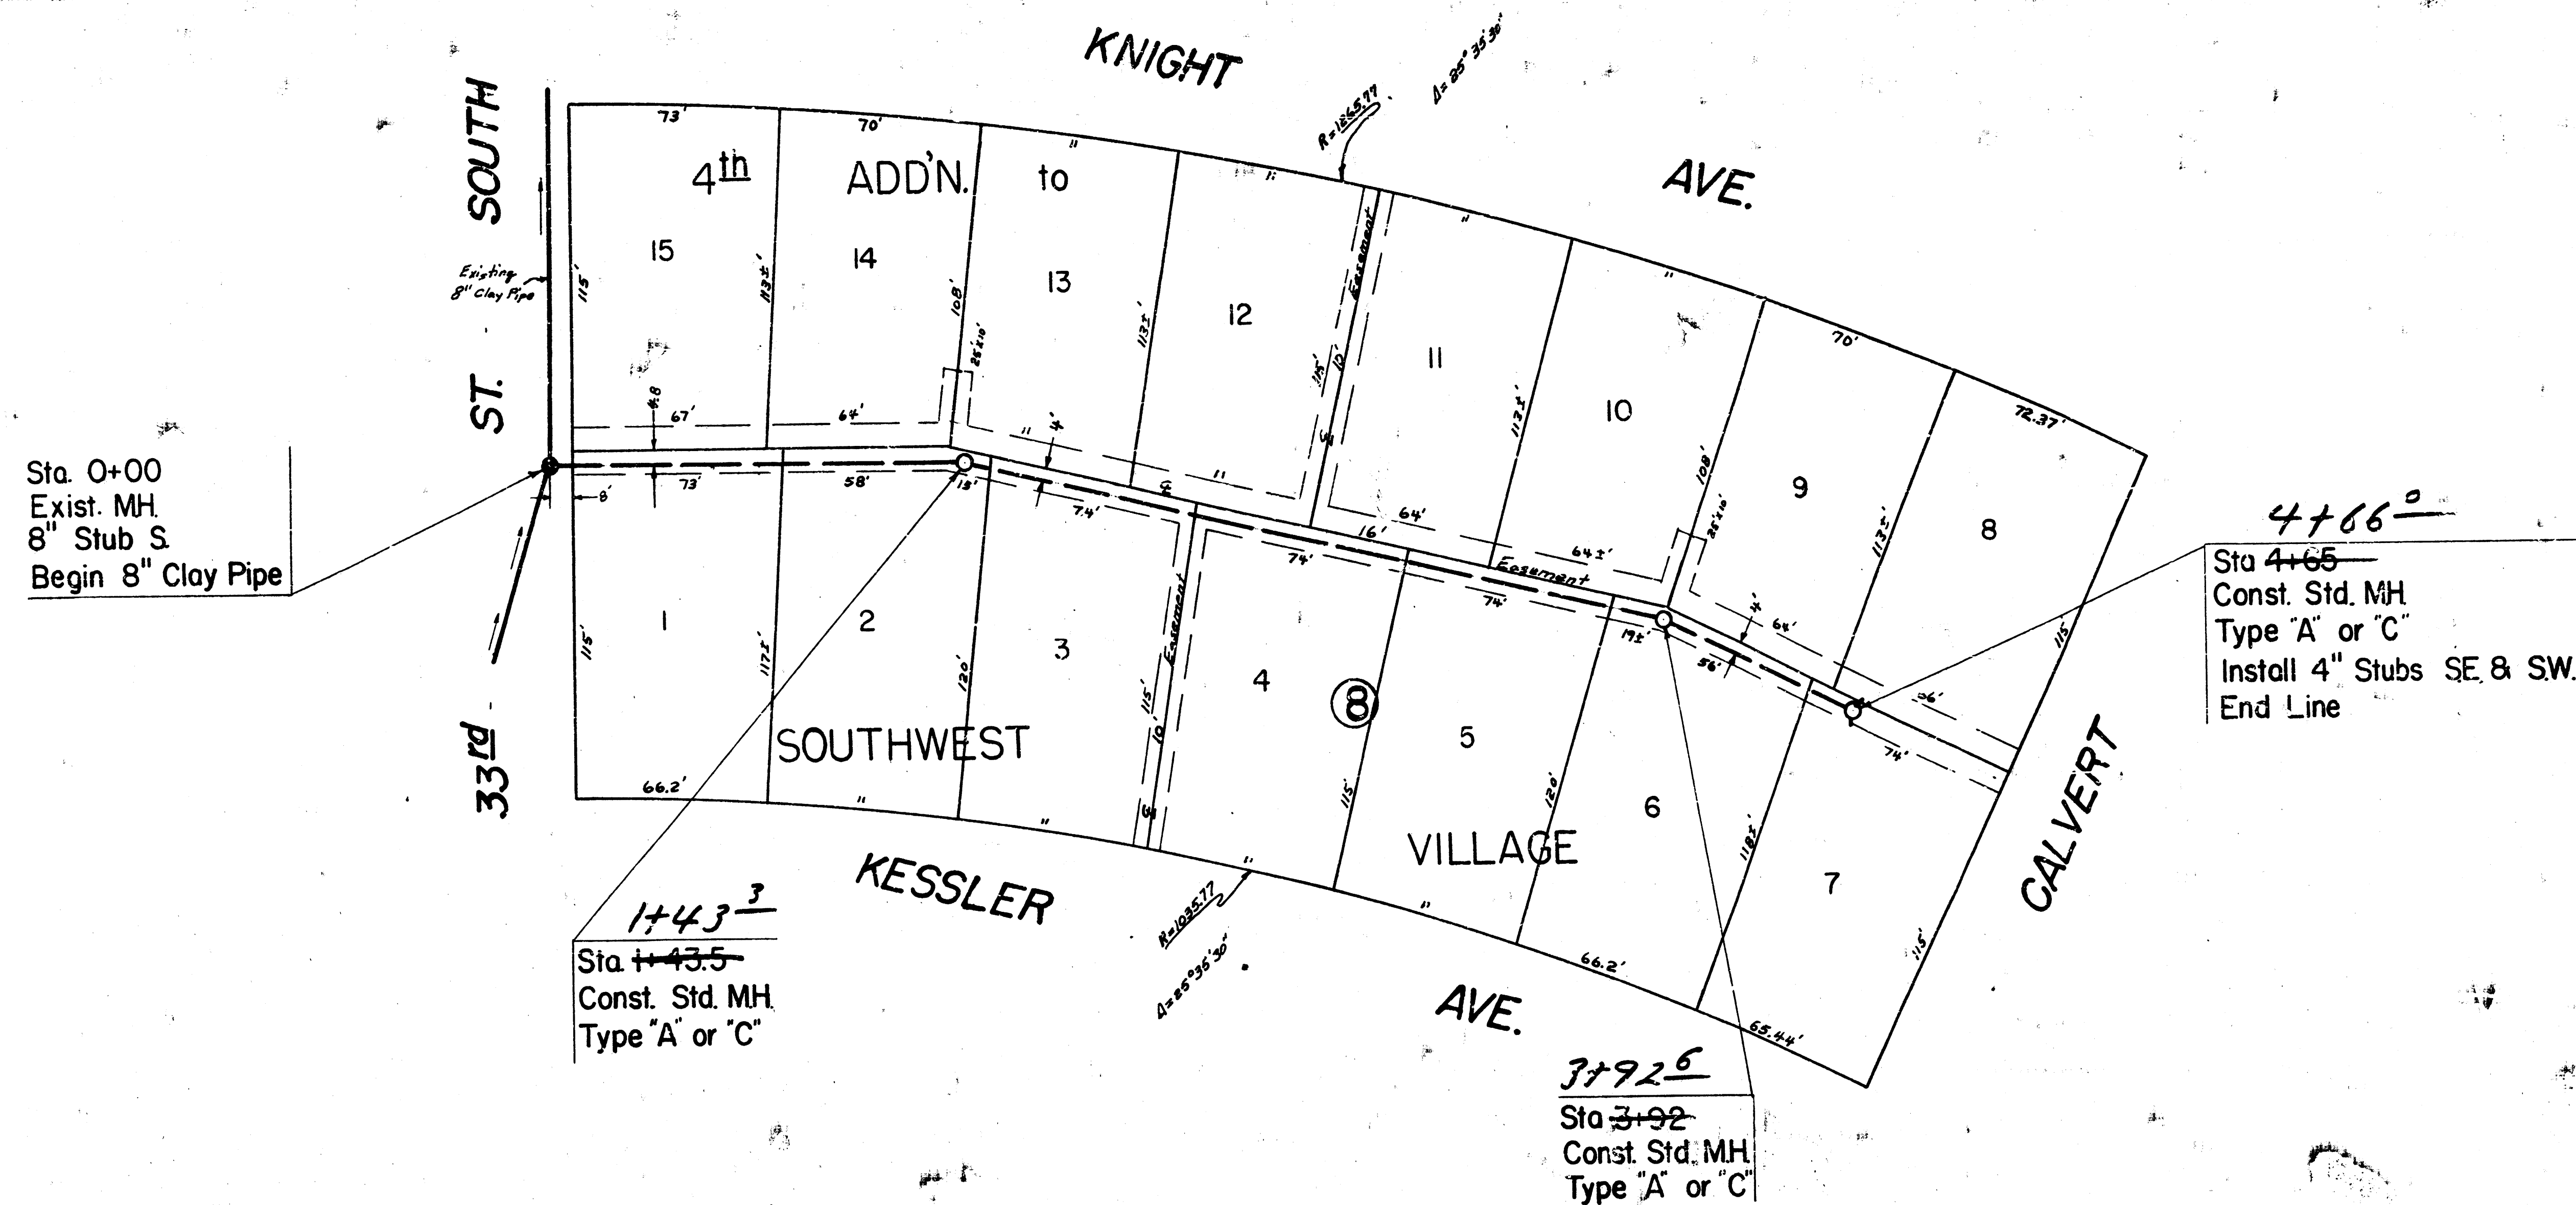

BM 100.68 "+" on top of curb at the east end of return SE corner of Kessler Ave. and 3rd St. South

