
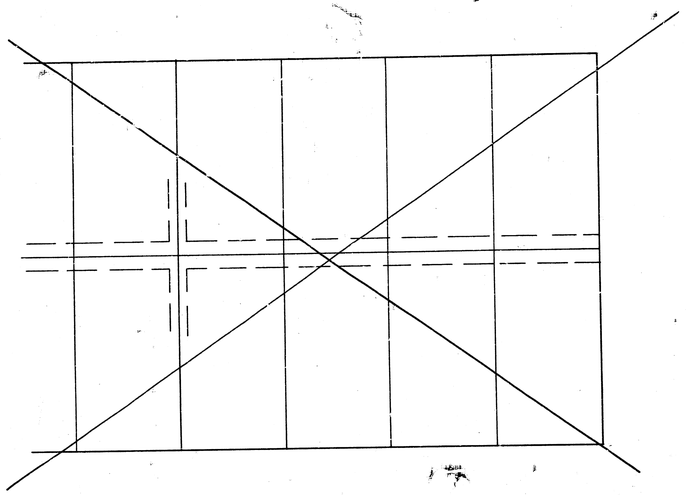



Survey A.R. 69 BK
Plat K. Loomis
Ck.
Checked

B.M. 103.97 City Std. Disc 53'E & 44'S. of ℄ of West St & ℄ 31st St. So.

B.M. 100.79 ⌀ cut on back of curb on west end radius on W.S. Kessler & SS. 31st St. So.

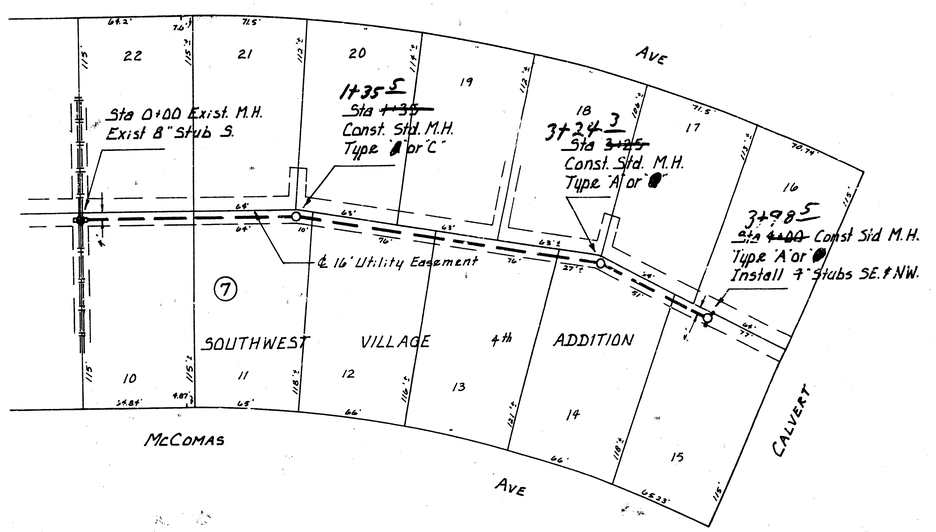

Plan Scale 1"=40'
Profile Scale 1"=40' horz.
1"=5' Vert.

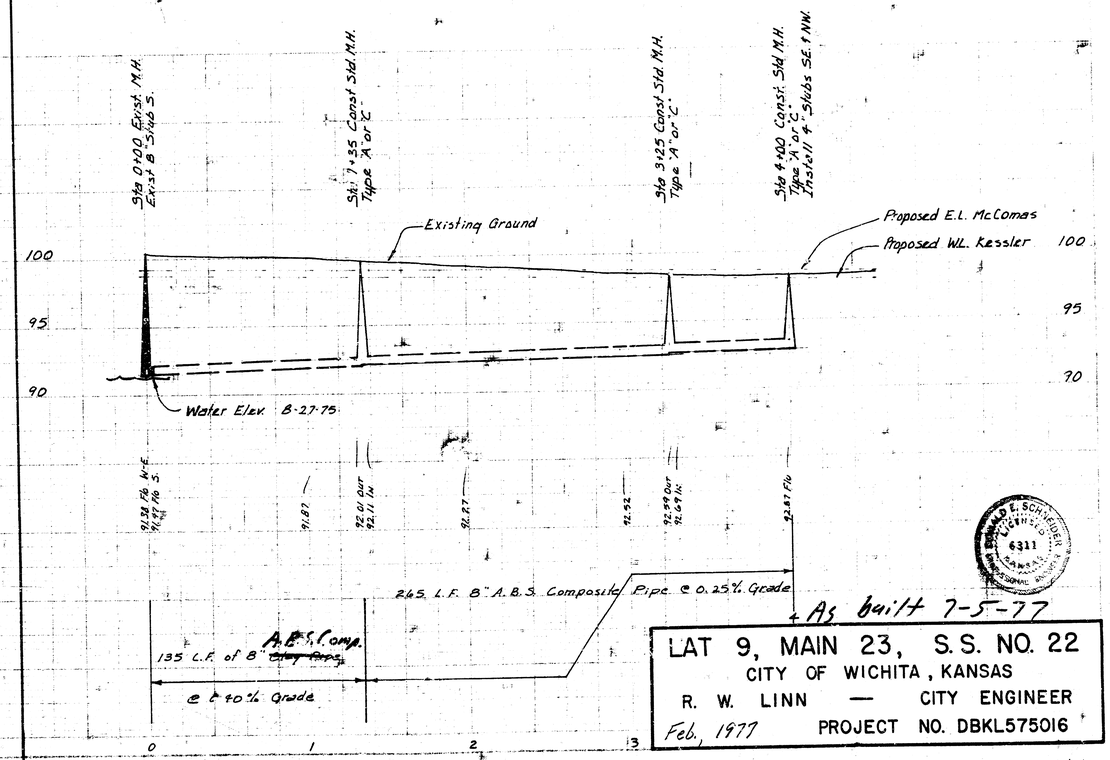

As built 7-5-77

LAT 9, MAIN 23, S.S. NO. 22
CITY OF WICHITA, KANSAS
R. W. LINN — CITY ENGINEER
Feb., 1977 PROJECT NO. DBKL575016

14 10 3 18 1/1