



Sines, A.P. & B.
 Plans, E. Loomis
 Exp.
 Checked

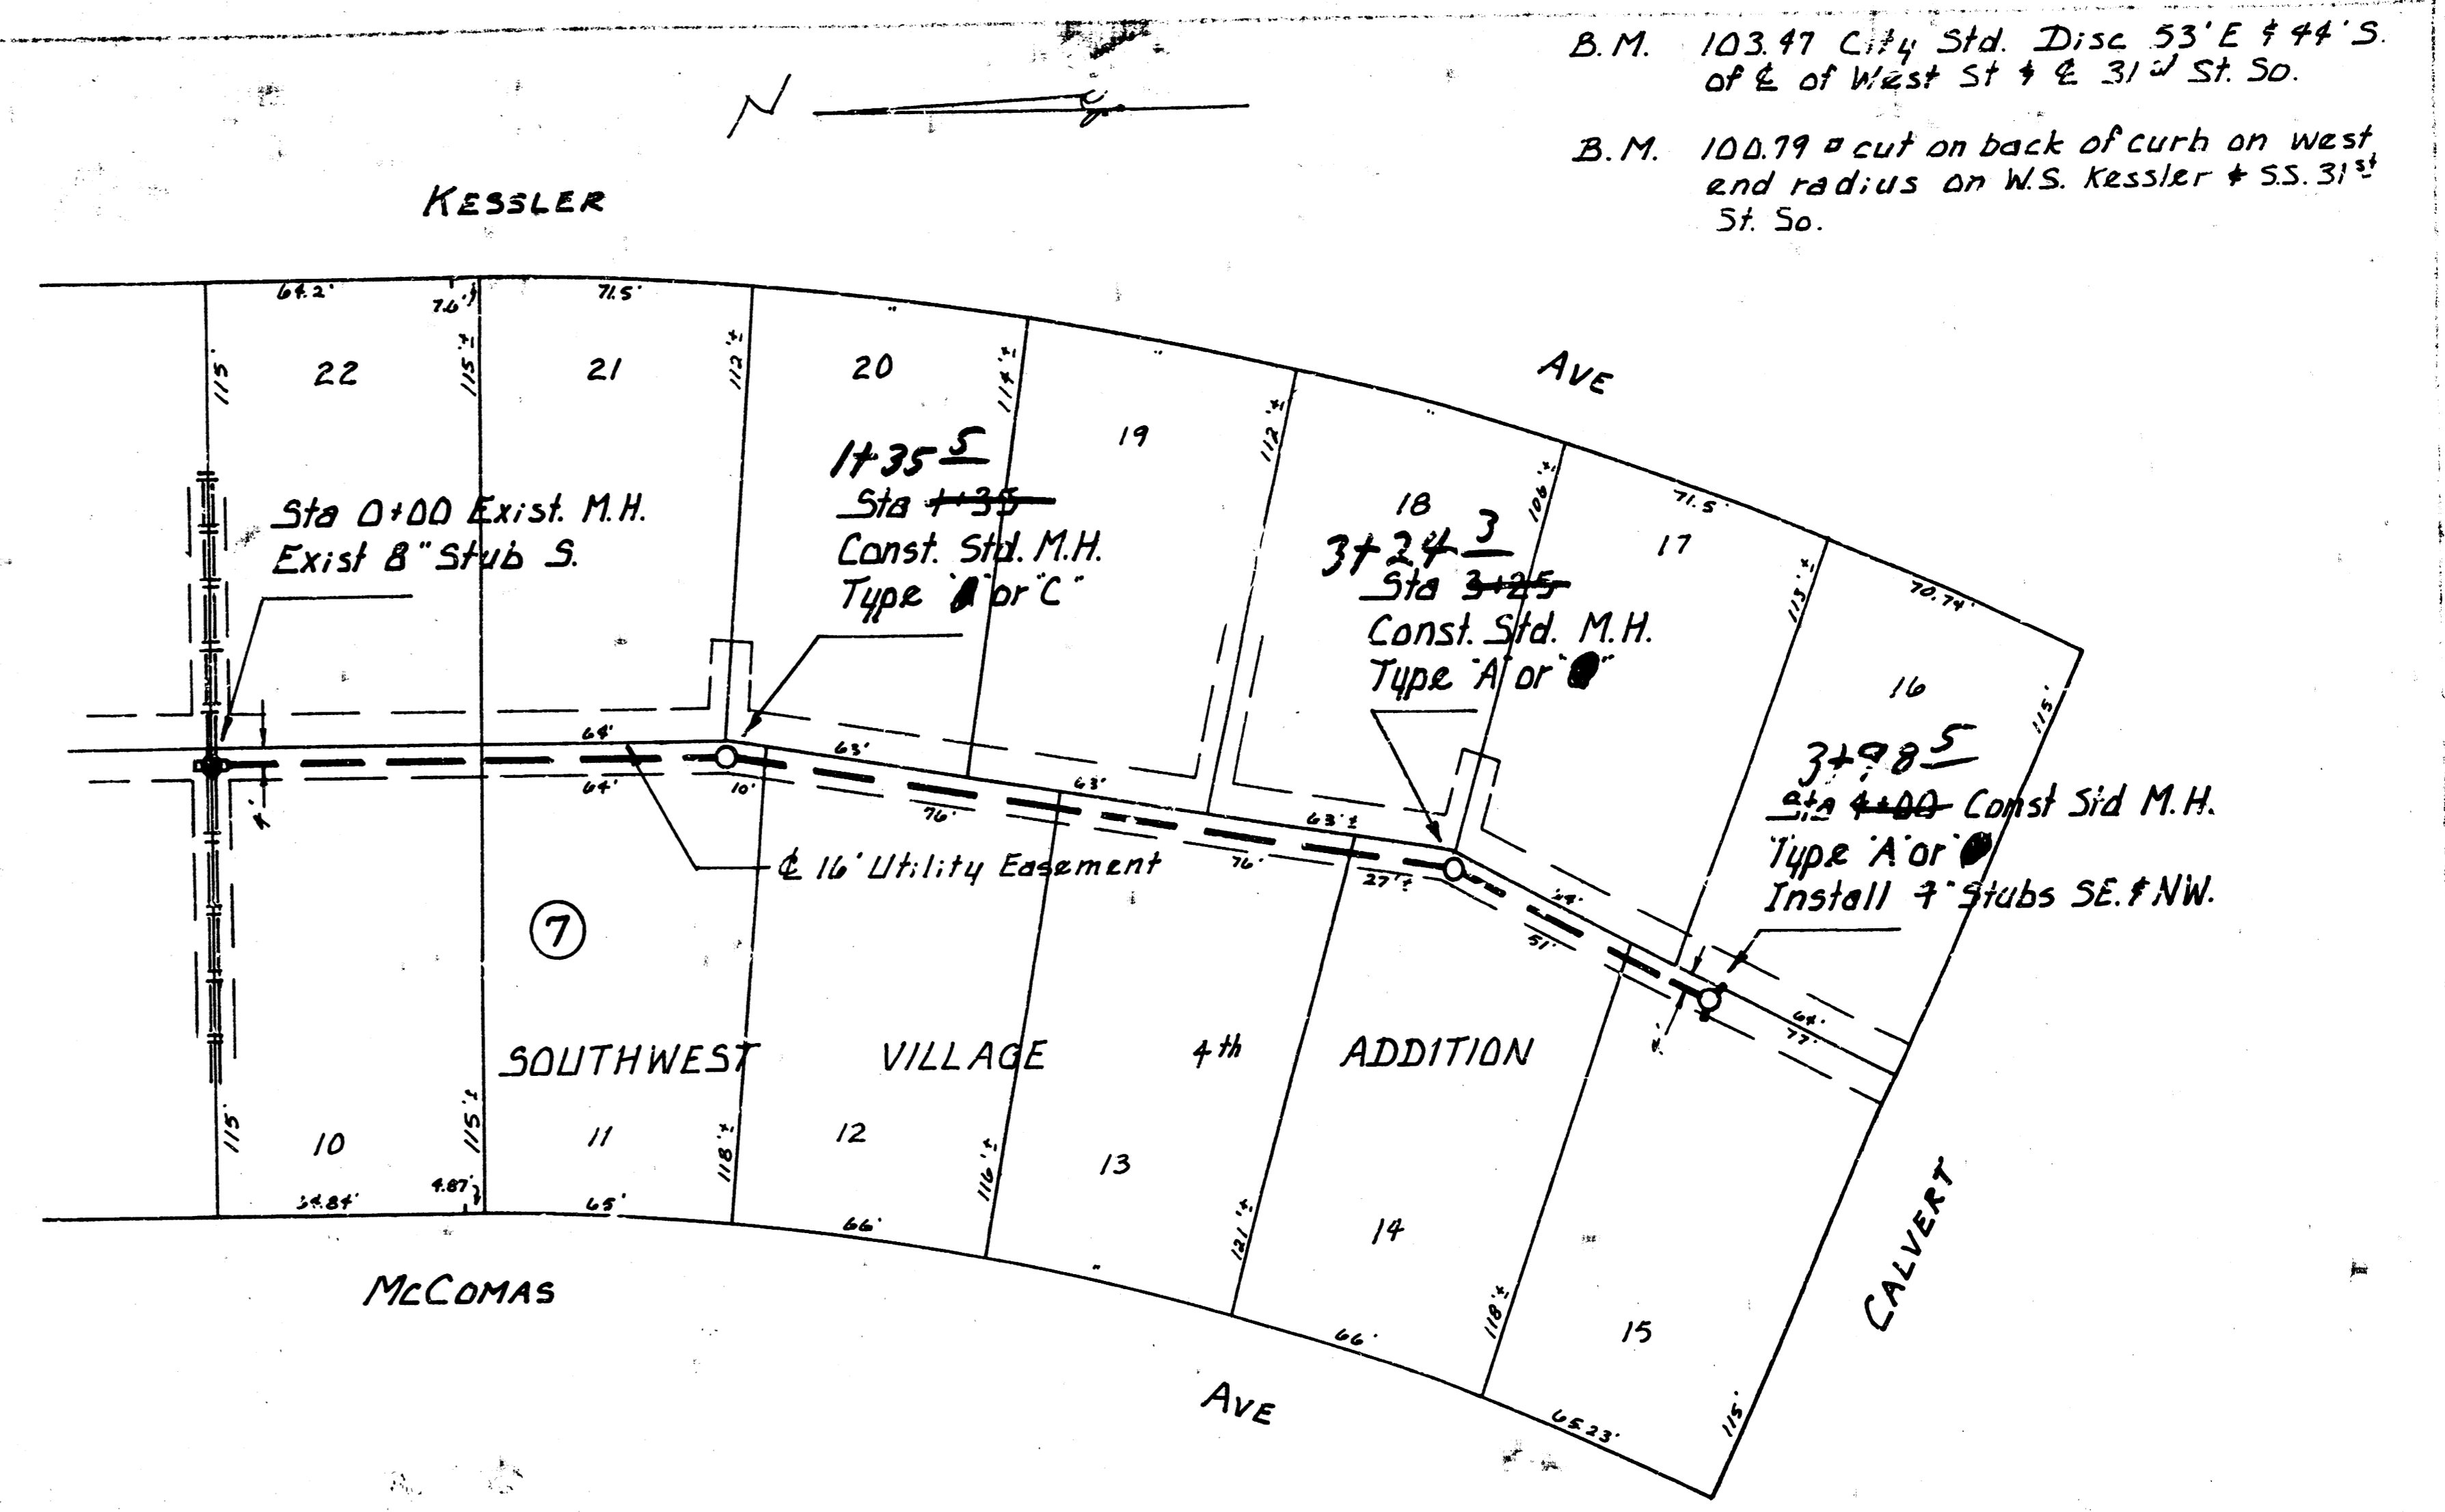

B.M. 103.97 City Std. Disc. 53' E & 44' S
 of E. of West St & E. 31' St. So.
 B.M. 100.79 # cut on back of curb on west
 end radius on W.S. Kessler & S.S. 31'
 St. So.

Plan Scale 1"=40'
 Profile Scale 1"=40' horz.
 1"=5' Vert.

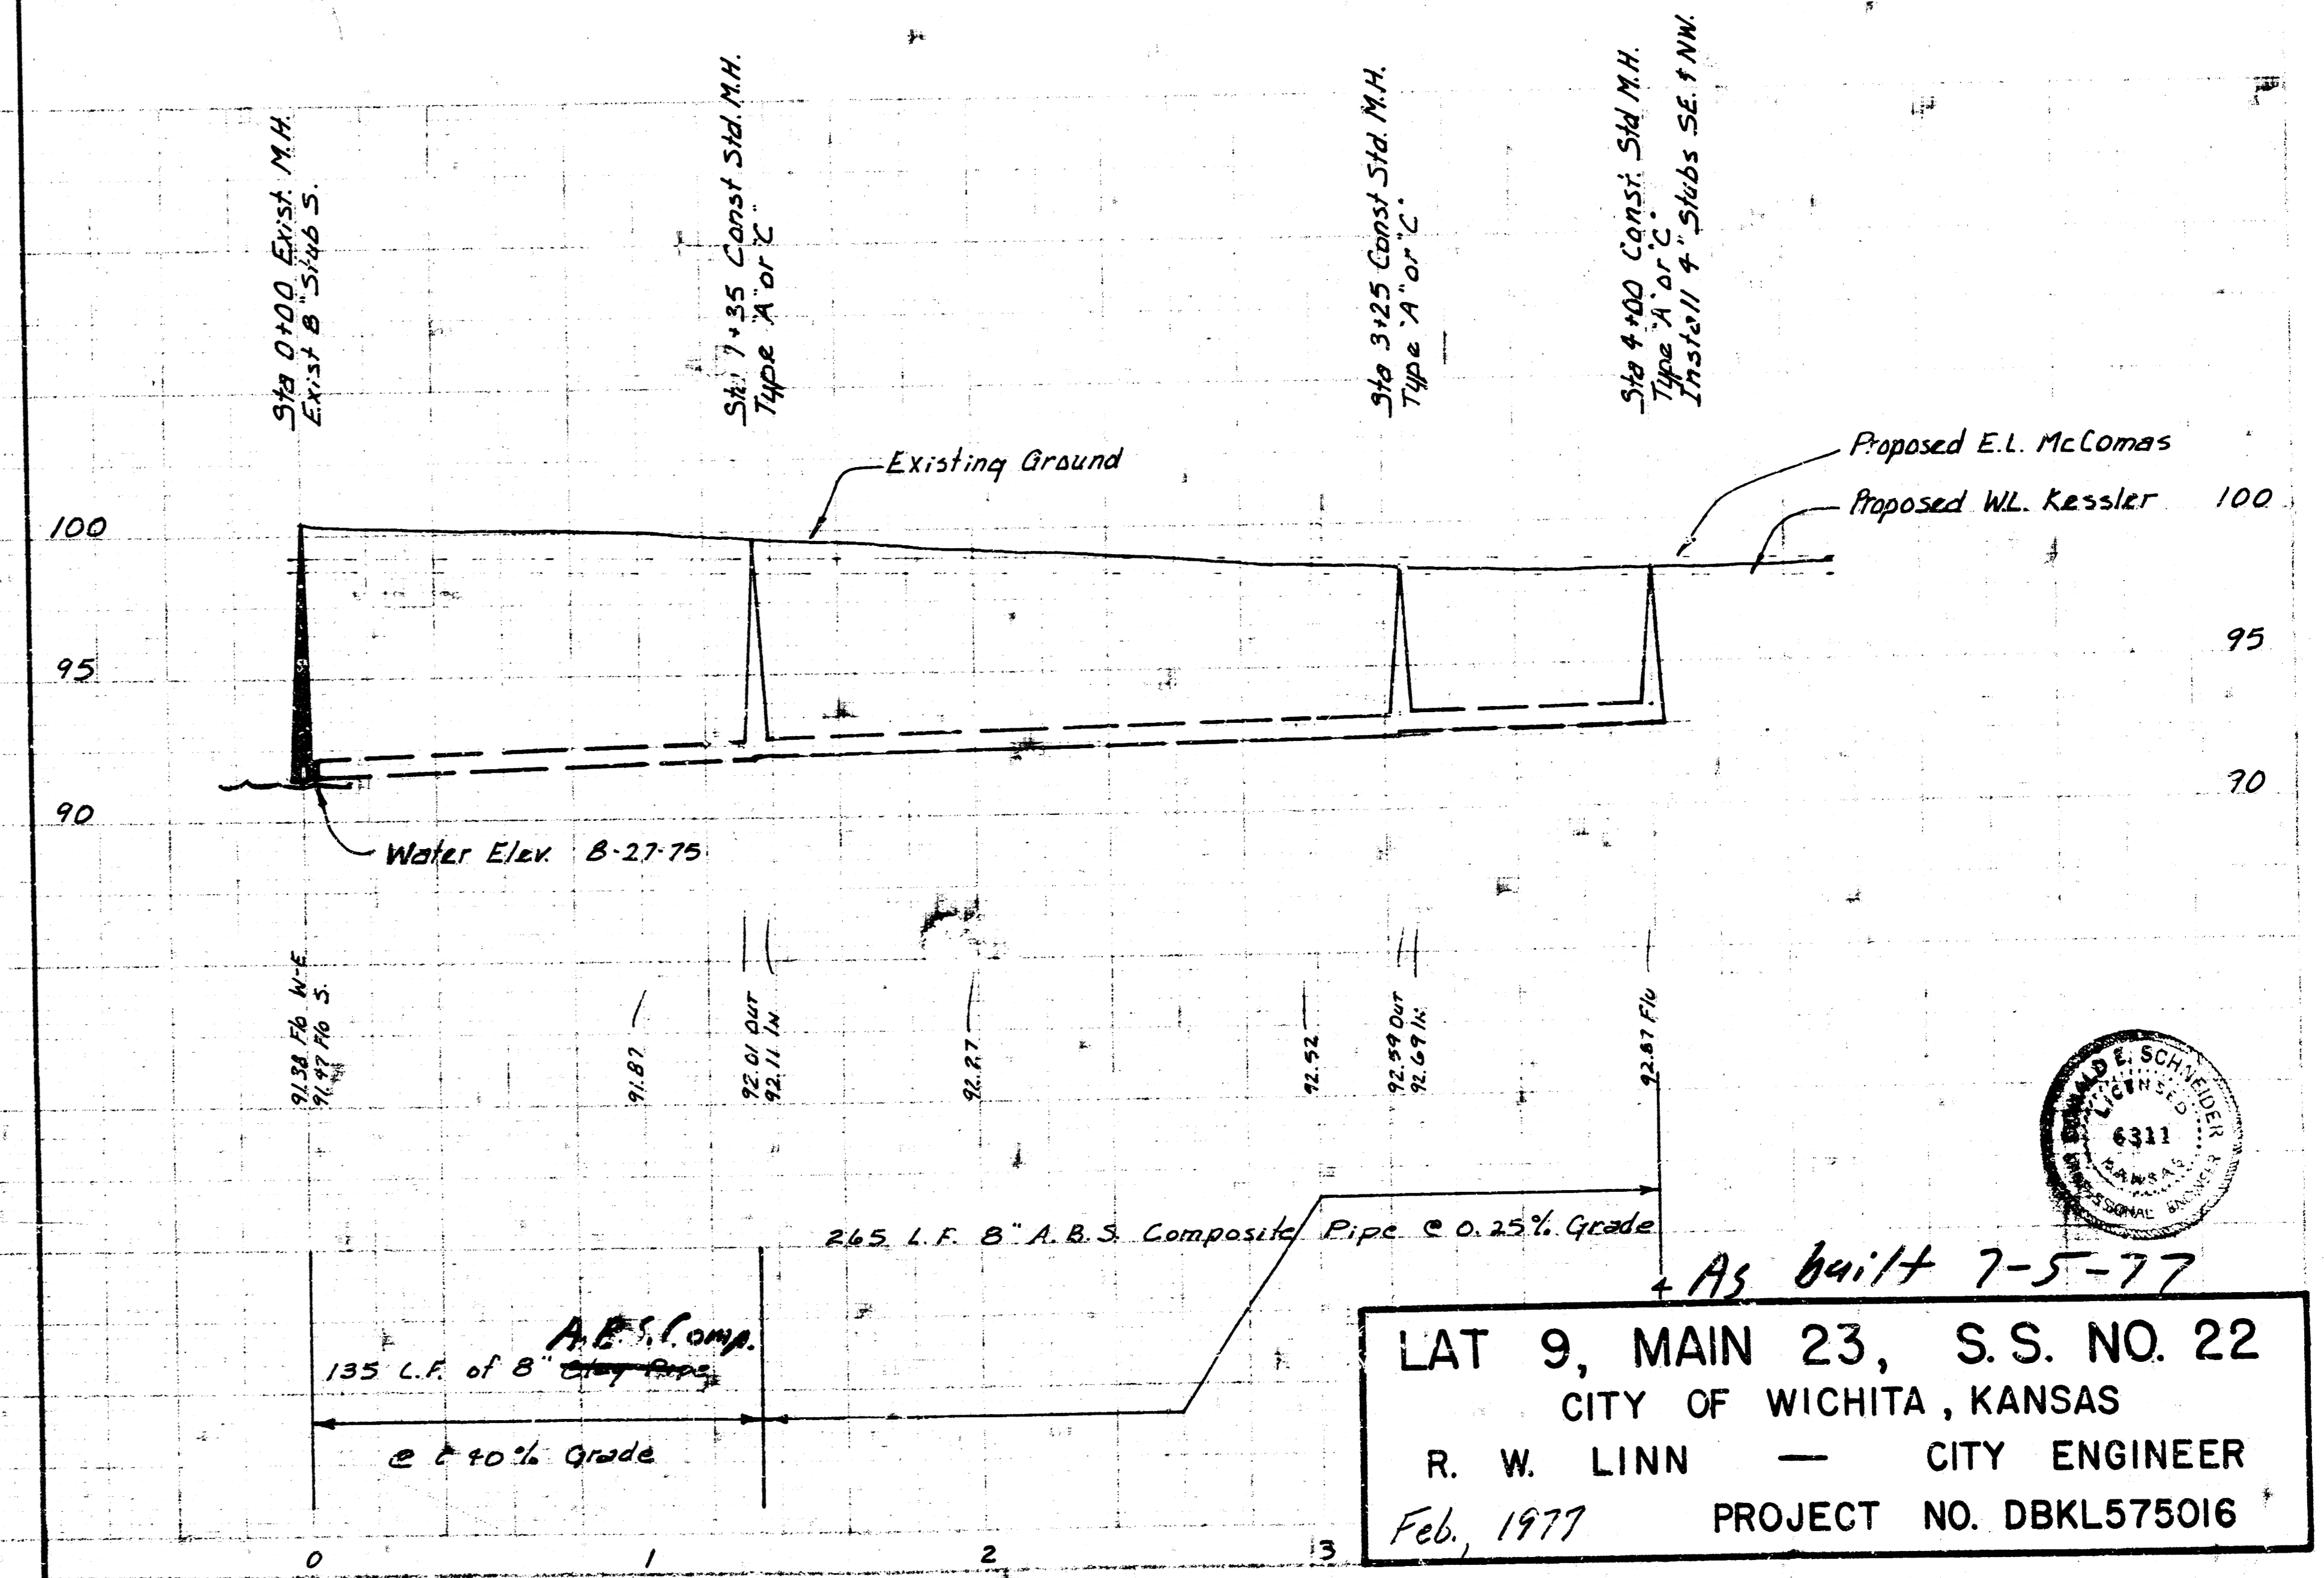

LAT 9, MAIN 23, S.S. NO. 22
 CITY OF WICHITA, KANSAS
 R. W. LINN — CITY ENGINEER
 Feb, 1977 PROJECT NO. DBKL575016



14 10 3 18 1/2