


A.P. 69
K. Loomis

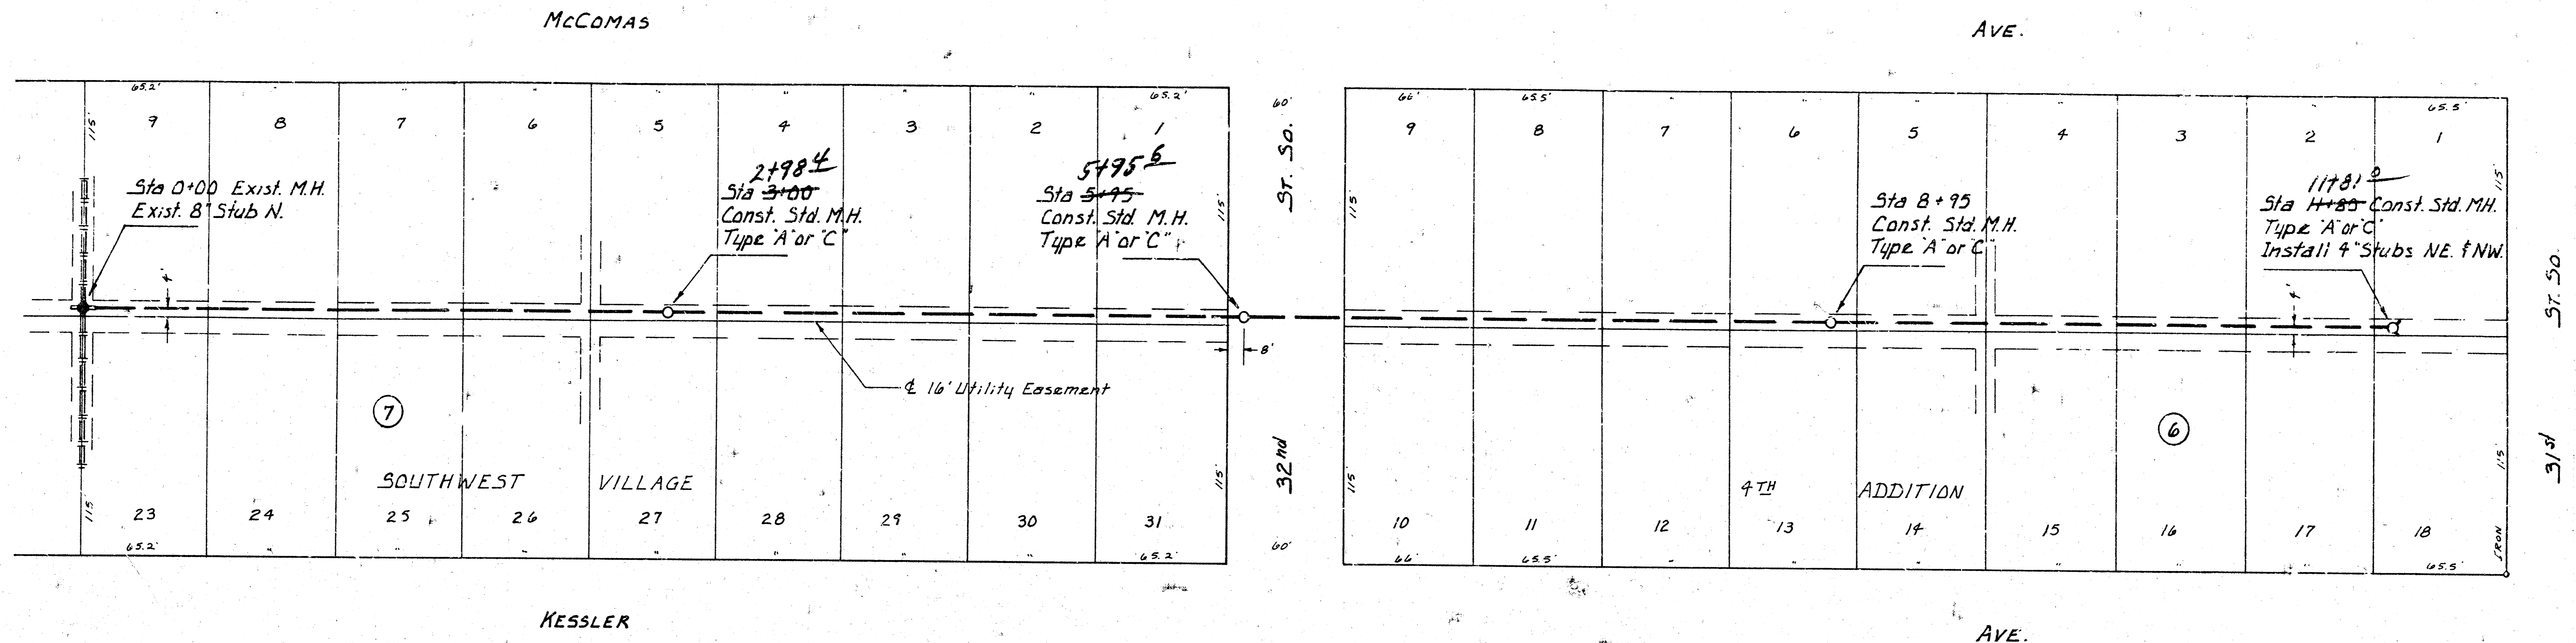

B.M. 103.47 City Std. Disc 53'E & 44'S
of C. of West St & 31st St. So.

B.M. 100.79 a cut on back of curb on West end
radius on W.S. Kessler & S.S. 31st St. So.

Scale Plan 1" = 40'
Profile 1" = 40' horz
1" = 5' Vert.

