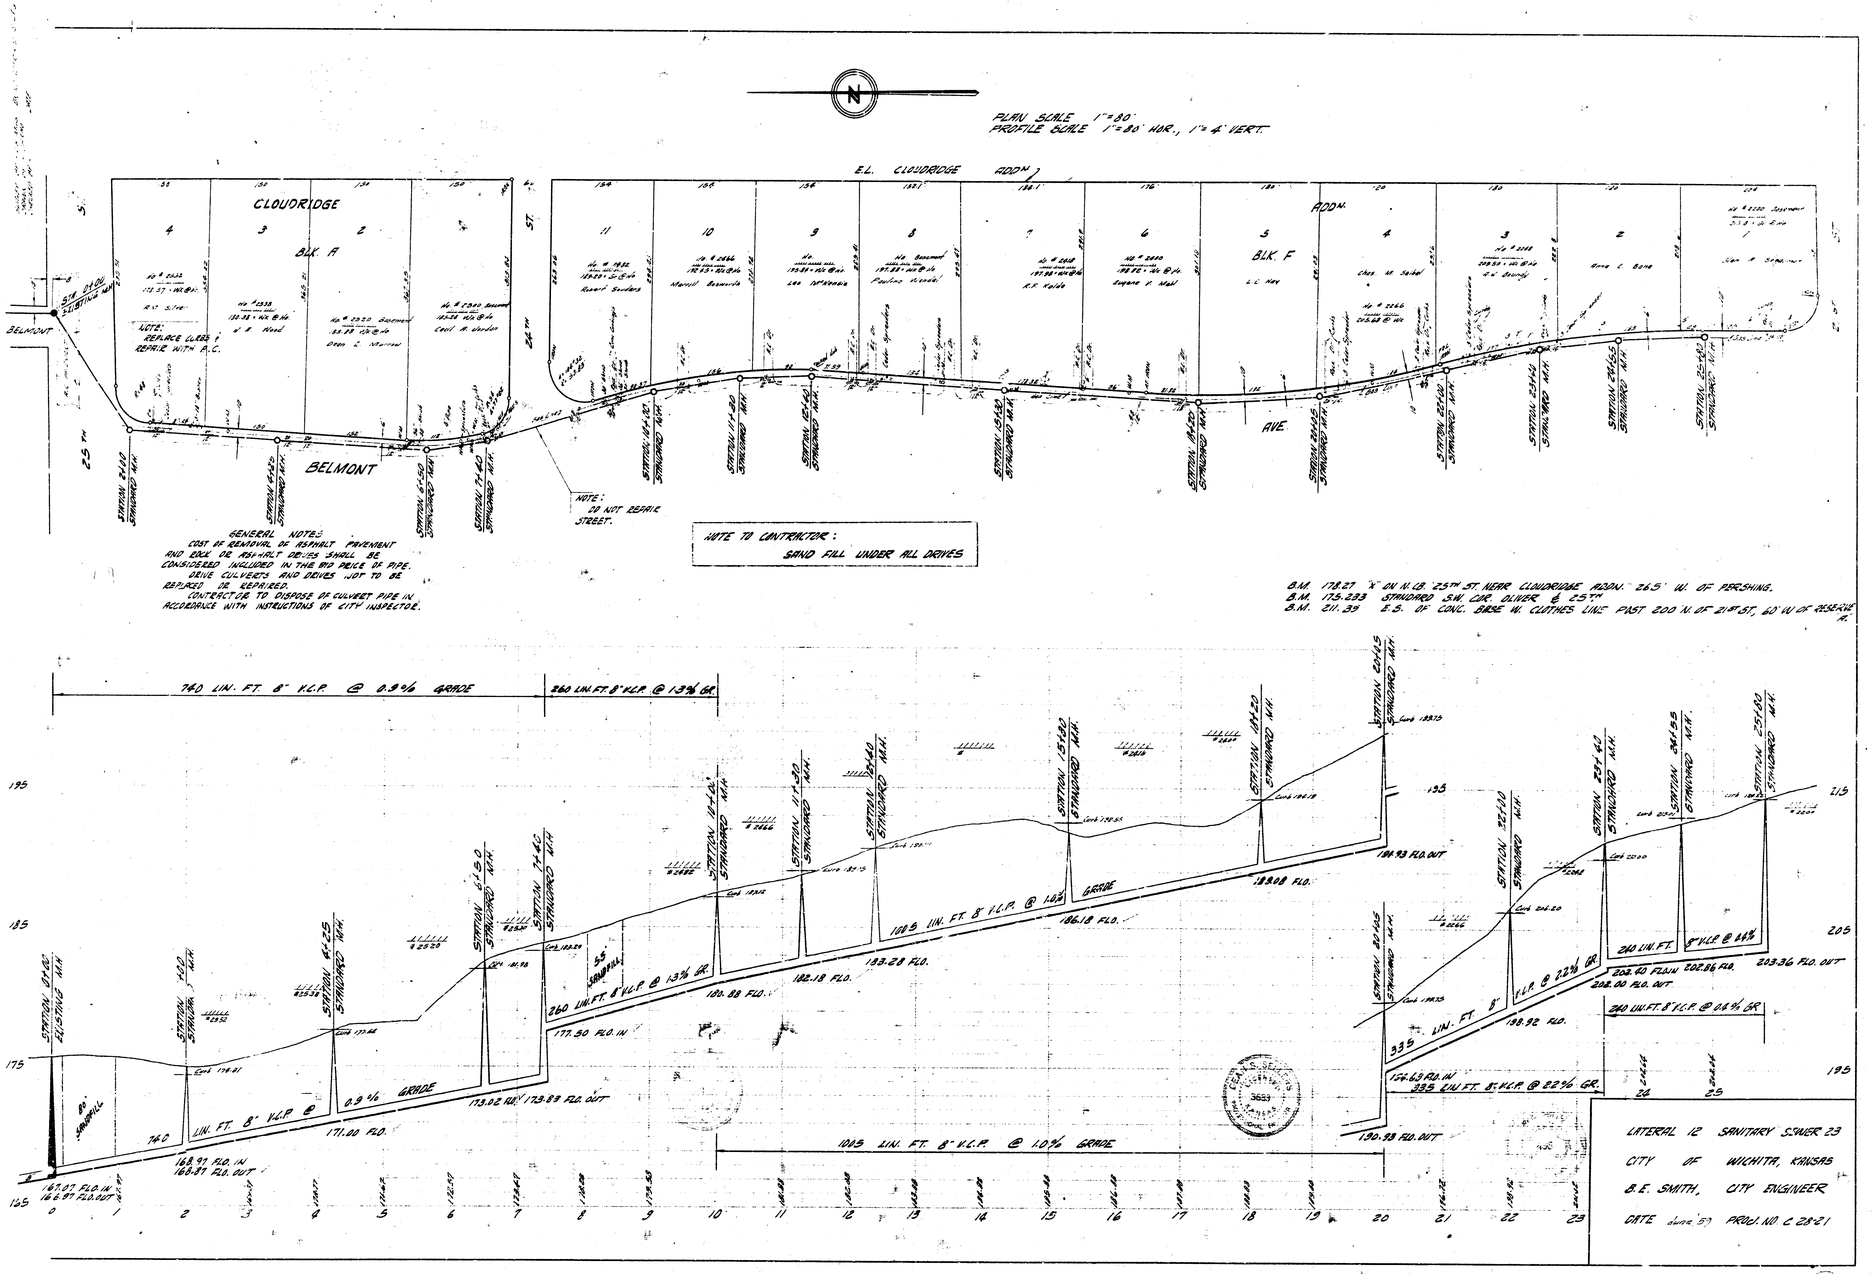

PLAN SCALE 1"=80'
PROFILE SCALE 1"=80' HOR., 1"=4' VERT.
E.L. CLOUDRIDGE ADDN.
CLOUDRIDGE
BLK. A
BLK. F
ADDN.
BELMONT
AVE.
25TH
24TH ST.
NOTE: REPLACE CURBS & REPAIR WITH P.C.
NOTE: DO NOT REPAIR STREET.
NOTE TO CONTRACTOR: SAND FILL UNDER ALL DRIVES
GENERAL NOTES:
COST OF REMOVAL OF ASPHALT PAVEMENT AND ROCK OR ASPHALT DRIVES SHALL BE CONSIDERED INCLUDED IN THE BID PRICE OF PIPE.
DRIVE CULVERTS AND DRIVES NOT TO BE REPLACED OR REPAIRED.
CONTRACTOR TO DISPOSE OF CULVERT PIPE IN ACCORDANCE WITH INSTRUCTIONS OF CITY INSPECTOR.
B.M. 178.27 "X" ON N.CB. 25TH ST. NEAR CLOUDRIDGE ADDN. 265' W. OF PERSHING.
B.M. 175.233 STANDARD S.W. COR. OLIVER & 25TH
B.M. 211.39 E.S. OF CONC. BASE W. CLOTHES LINE POST 200' N. OF 21ST ST., 60' W. OF RESERVE A.
740 LIN. FT. 8" V.C.P. @ 0.9% GRADE
260 LIN. FT. 8" V.C.P. @ 1.3% GR.
1005 LIN. FT. 8" V.C.P. @ 1.0% GRADE
335 LIN. FT. 8" V.C.P. @ 2.2% GR.
240 LIN. FT. 8" V.C.P. @ 0.4% GR.
LATERAL 12 SANITARY SEWER 23
CITY OF WICHITA, KANSAS
B.E. SMITH, CITY ENGINEER
DATE June '59 PROJ. NO. C 28-21