

BM 161.56 NE Cor. Conc. porch House # 6305 E. 27th St. No.
BM 160.23 Ctr. Brick Arc way on conc. wk House # 2900 N. Terrace Dr.

Lots 23 to 31 & Lot 39 are not in Benefit District.

NOTE: THIS PROJECT IS TO BE COORDINATED WITH THE ADJUSTMENT OF CONTINENTAL PIPELINE.

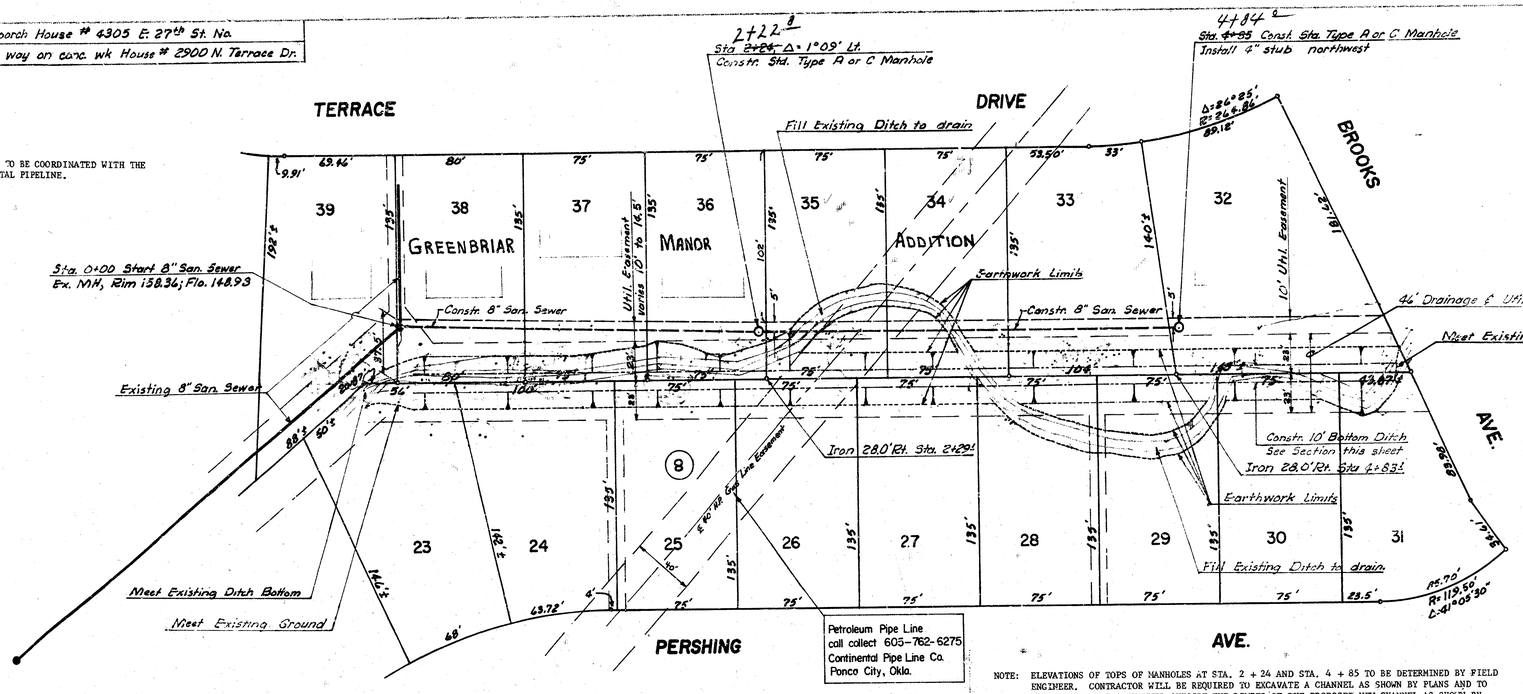


Plan Scale 1" = 40'
Profile Scale 1" = 40' Horz.
1" = 5' Vert.

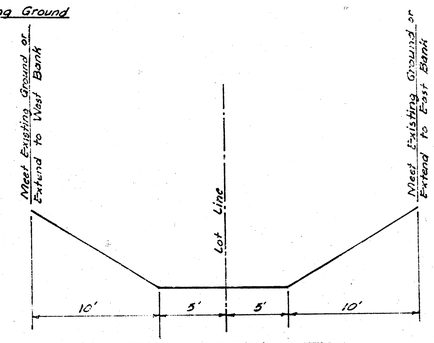

TYPICAL DITCH SECTION

NOTE: ELEVATIONS OF TOPS OF MANHOLES AT STA. 2 + 24 AND STA. 4 + 85 TO BE DETERMINED BY FIELD ENGINEER. CONTRACTOR WILL BE REQUIRED TO EXCAVATE A CHANNEL AS SHOWN BY PLANS AND TO FILL THE EXISTING CHANNEL OUTSIDE THE LIMITS OF THE PROPOSED NEW CHANNEL AS SHOWN BY PLANS. EXCAVATION OF CHANNEL SHALL BE PAID FOR AT PRICE BID PER CUBIC YARD OF EXCAVATION. FILL WILL NOT BE PAID FOR DIRECTLY AND THIS COST SHALL BE INCLUDED IN THE UNIT PRICE BID FOR THE EXCAVATION OF THE CHANNEL.

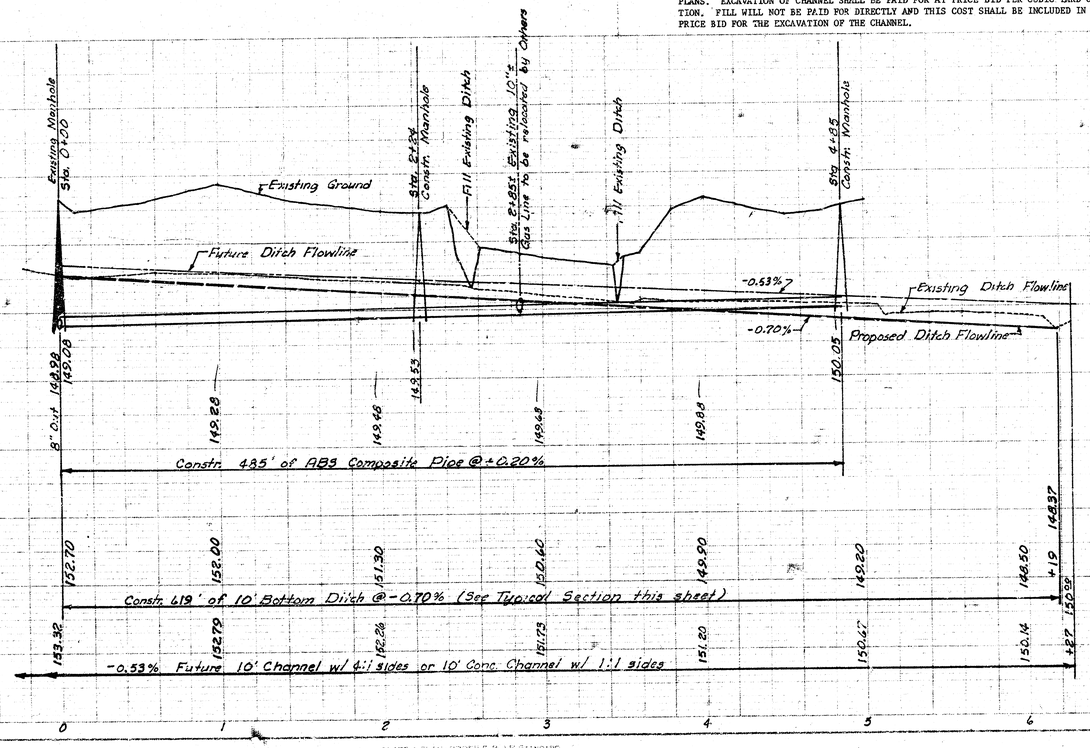

As Built 10-5-76

LAT. 8 MAIN I SANITARY SEWER 23
CITY OF WICHITA, KANSAS
R. W. LINN — CITY ENGINEER
DATE: _____ Sheet 1 of 2
Project Number DBKL576009
1/2

Sheet 2/2

Project No. CBHL 5782009 Lot 8, Main I, SB 23

