


B. M. 182.23 S.W. cor. conc. step
No. 4802 24th St. North.

B. M. 174.49 City Sid. 44' west of 32' N.
of 24th & Oliver.

B. M. 186.38 S.W. cor. conc. porch 4914
E. 24th St. North.

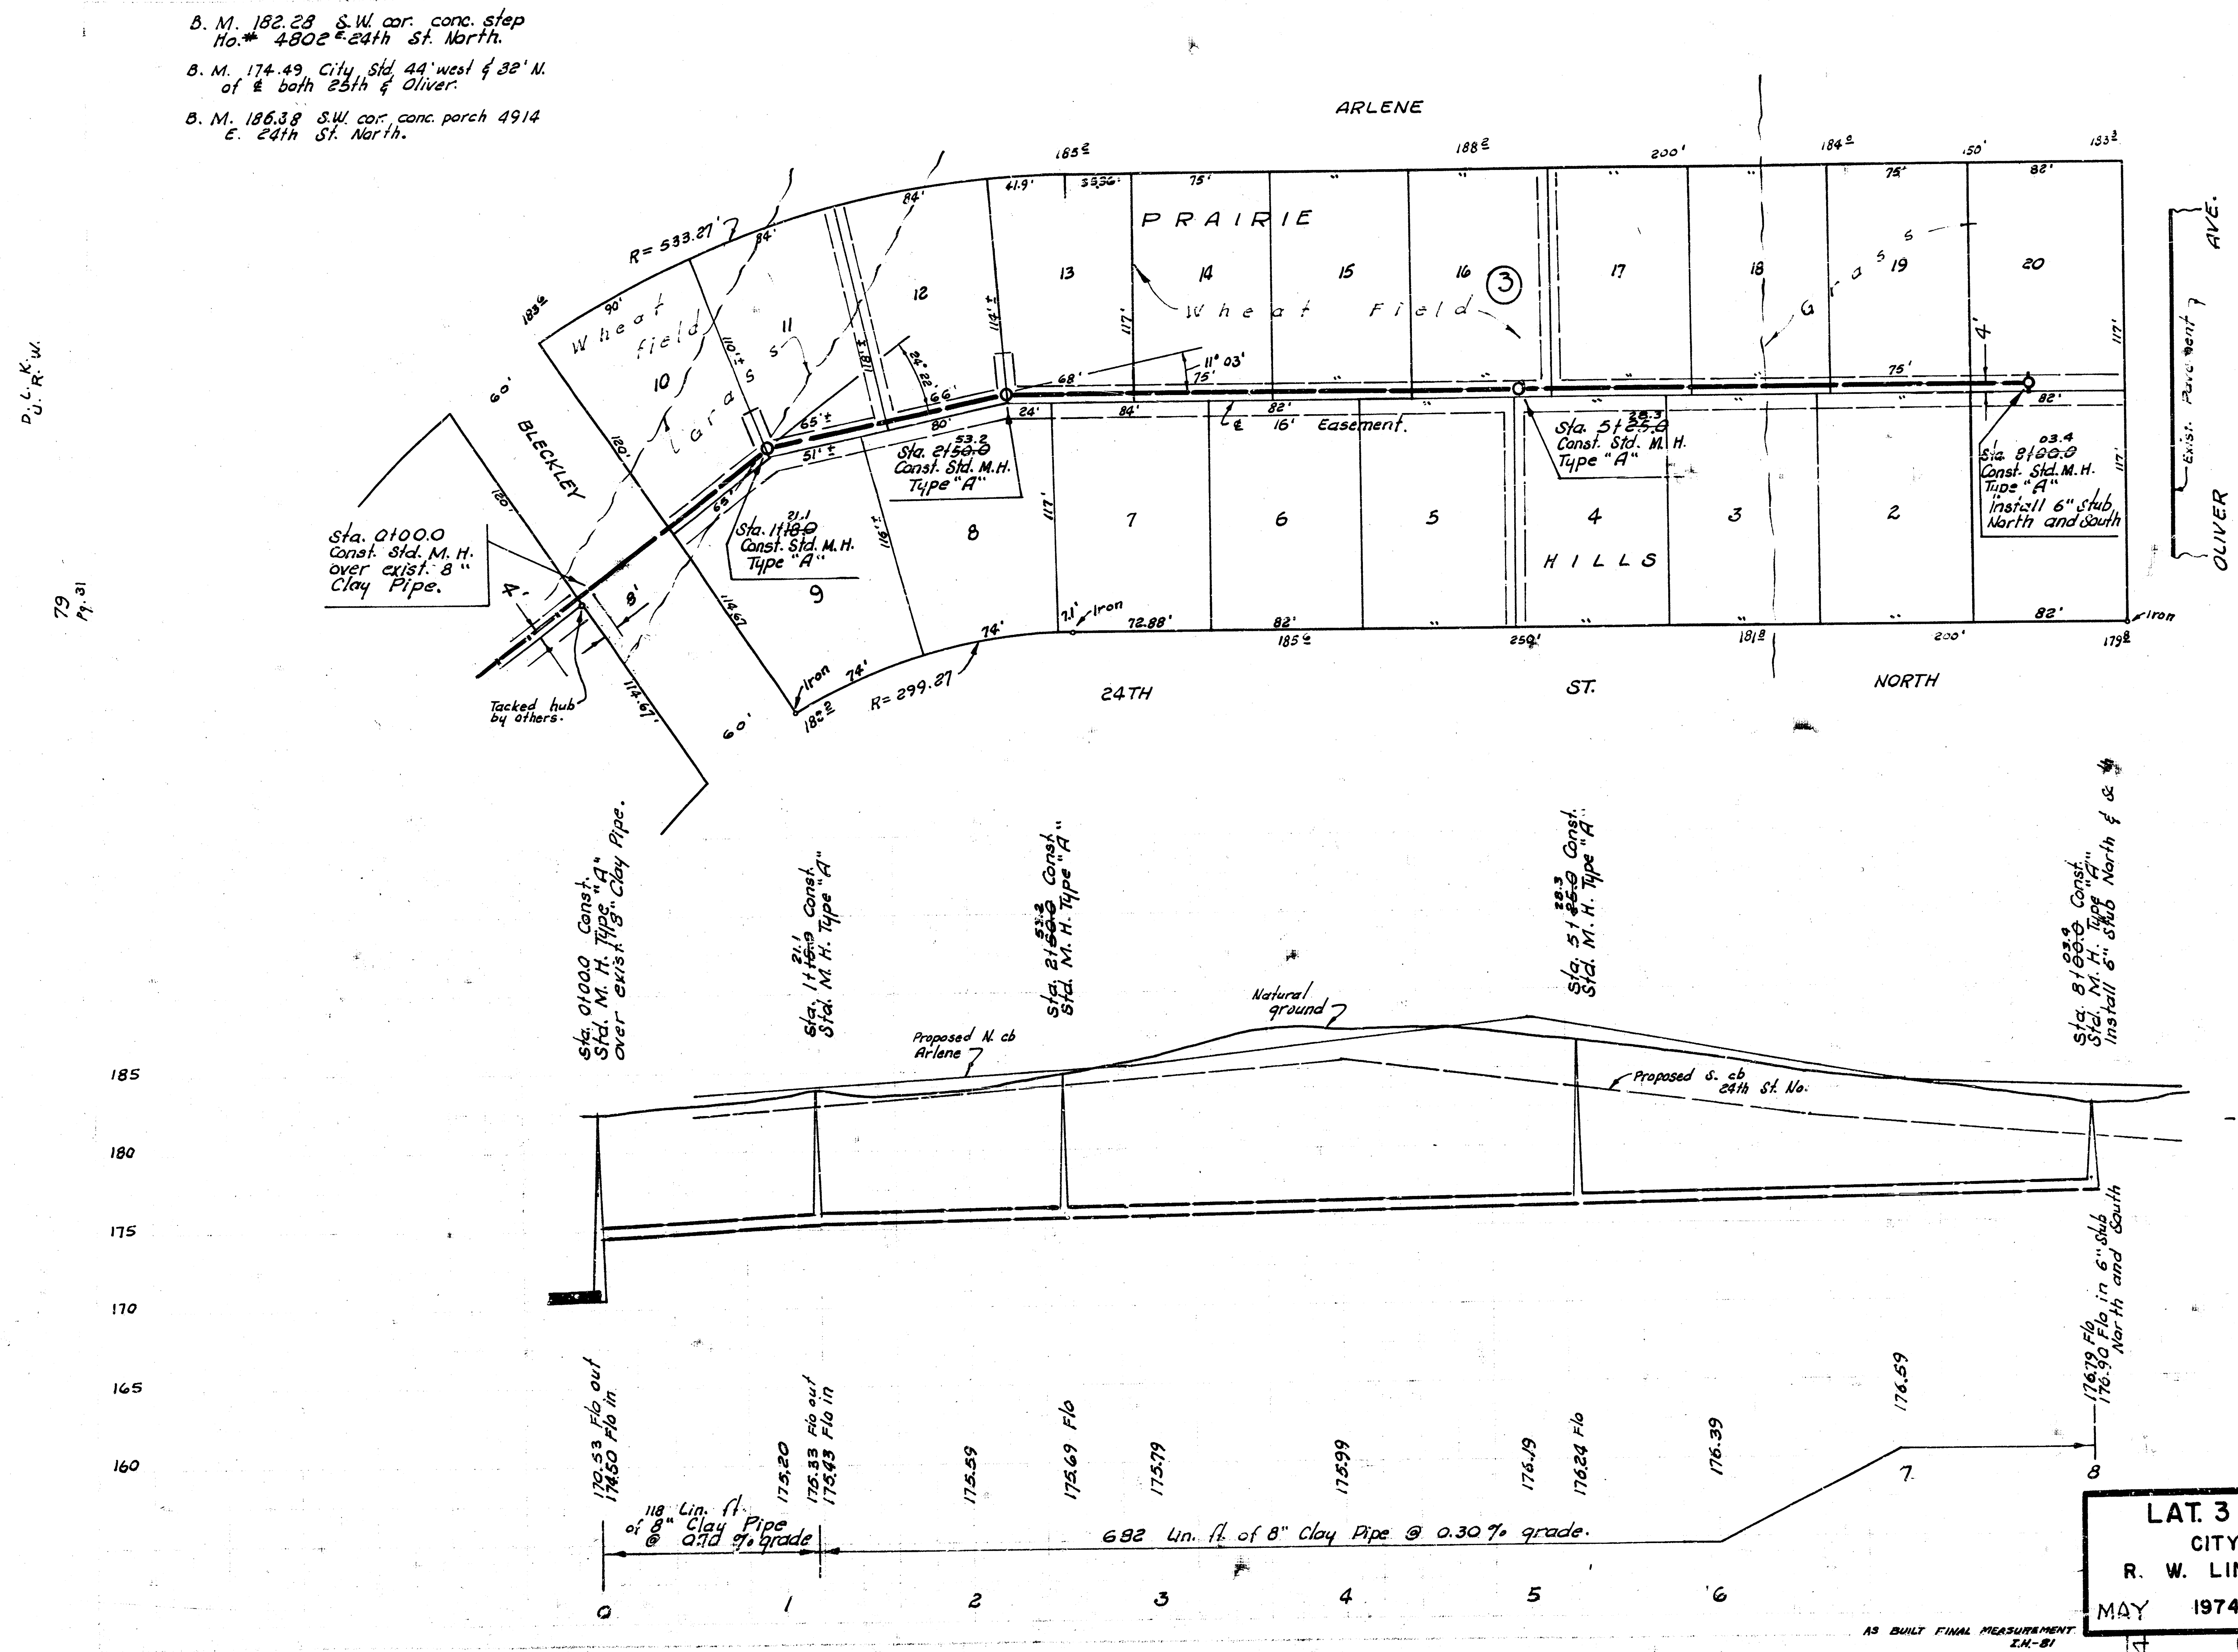

LAT. 3, MAIN 2, S. S. NO. 23
CITY OF WICHITA, KANSAS
R. W. LINN — CITY ENGINEER
MAY 1974 PROJECT NO. DBKL574011

FILMED FROM THE BEST
AVAILABLE COPY